

# **Four Corners Power Plant**

## **Geohydrology Data Submittal**

February 13, 2013

### **Introduction**

The Arizona Public Service Company Four Corners Power Plant (Plant) is a 2,100 MW coal-fired generating station located in Northwest New Mexico near the town of Fruitland, New Mexico. The Plant is constructed on a mesa located above San Juan and Chaco Rivers. Morgan Lake located just north and east of the Plant provides plant cooling (See Figures 1 and 12). Makeup water is pumped from the San Juan River into Morgan Lake. To control salinity, water is discharged (blown down) from Morgan Lake into a tributary of the Chaco River.

Fly ash and scrubber materials are disposed into lined ash ponds located below and west of the Plant. The Lined Ash Impoundment (LAI) currently receives ash from Units 1-3. Excess ash transport water is drained from the LAI and sent to the Lined Decant Water Pond (LDWP). Dry fly ash from Units 4-5 is disposed to the lined Dry Fly Ash Disposal Area (DFADA). Figure 12 shows the location of these disposal areas.

Historically, ash from Units 1-3 was disposed to Ash Ponds 1-6. These ash ponds are no longer active. The LAI and the LDWP were constructed on top of old Ash Ponds 3 and 4 and part of old Ash Pond 5 in 2003. There are also four old lined evaporation ponds (Evaporation Ponds 1-4) located west of the ash ponds and east of the Chaco River. These evaporation ponds were constructed on top of old Ash Ponds 1 and 2 in 1977. Evaporation Ponds 1-4 received discharge from the groundwater intercept systems until December 2011. The intercept system discharge is now directed to the LDWP.

The information discussed and attached to this submittal is intended to provide the geohydrologic framework for the groundwater movement beneath the ash disposal area located to the west of the generating units. This information was used to develop the design for the intercept trench system described later in the document. Activities and plans related to closure of old Evaporation Ponds 1-4 and the old ash disposal areas are also described.

### **Background**

The Plant is located near the western margin of the San Juan Basin, a structural depression that lies at the eastern edge of the Colorado Plateau. To the east of the Plant is the Hogback Monocline that forms the eastern edge of the Basin (Stone, et. al. 1983). The monocline dips to the east at about 38° just east of the Chaco River. The dip of the sediments quickly changes to about 3° to 5° to the east beneath the Plant.

The Cliff House Sandstone caps the Hogback to the west of the Chaco River. The Cliff House Sandstone intertongues with the overlying Cretaceous Lewis Shale. The Plant ash ponds are built upon the Lewis Shale, which is a marine shale that contains substantial amounts of evaporite deposits, including gypsum. The Lewis Shale dips about 3° to 5° to the east beneath to the ash ponds. The monitor wells installed around the ash ponds are all completed in the Lewis Shale. Based on the results from the construction of these wells, the Lewis Shale has a weathered zone about 10 – 50 feet deep, normally overlain by a thin layer of soil 1 – 2 feet thick. The weathered zone slopes to the west towards the Chaco River at about 1.2 degrees. The weathered Lewis Shale varies from brown to gray-brown to light gray in color. Beneath the weathered shale the un-weathered Lewis

# **Four Corners Power Plant**

## **Geohydrology Data Submittal**

February 13, 2013

Shale is gray-brown to blue-gray to dark gray in color. It is significantly less permeable than the weathered shale. The Picture Cliffs Sandstone is located above the Lewis Shale. It is seen in outcrops on top of the mesa where the Plant is located.

Groundwater beneath the ash ponds flows to the west, mainly in the weathered shale and in local alluvial channels that drain towards the Chaco River (Figure 12). There is some uncertainty regarding the contribution of Morgan Lake to the local groundwater. The current groundwater contours suggest that it is a source of water up-gradient of the ash ponds. However, there are three (3) wells that do not fit this interpretation. Wells MW-12R, MW-41 and MW-42 appear to monitor localized perched water zones (see Figure 12). Installation of additional wells located within the ash pond area and between Morgan Lake and the Ash Ponds is planned for later in 2013 to help clarify this issue. The locations for the proposed new wells are shown on Figure 14.

Figures 2 through 11 are geologic cross-sections showing local geology and the location of the piezometric surface of the groundwater in the vicinity of the Plant. Figure 1 shows the location of the cross-sections. Figures 5 through 9 show the geohydrologic conditions from Morgan Lake on the east to the Chaco River on the west. The sections show the groundwater flow direction is east to west at about the same slope as the slope of the interface between the weathered and un-weathered shale. Figure 8 (cross-section G-G') shows the groundwater levels from monitor well LS-1 located east of the ash ponds and to the west towards the Chaco River. Wells LS-1 and LS-2 were drilled as up-gradient wells. Cross-section H-H' in Figure 9 is located just south of section G-G' and shows similar conditions from well LS-2 west towards the Chaco River. However, as discussed above, well MW-12R drilled on the southeastern edge of the LAI (see Figure 12) appears to show a local perched water level.

Figures 2 - 4 show the results of three north-south resistivity surveys conducted west of the ash ponds. These surveys were conducted to assist with the design of intercept trenches intended to capture groundwater moving towards the Chaco River and send it to the LDWP (Figure 12). This impoundment is constructed with a double liner and leachate collection system.

The resistivity data along with geologic information derived from boreholes drilled for the installation of monitor wells showed that the groundwater flow in this area is confined primarily to the un-weathered shale and local alluvial channels. In some cases, water flow was identified in small joint systems within the shale. The most significant flow is within the alluvial channels.

Figures 10 and 11 show cross-sections H-H' and I-I' that give more detail in a deep alluvial zone identified by the resistivity survey and geologic borings and monitor wells. This zone is expected to be the location of greatest groundwater flow in that area.

### **Monitor Wells Construction and Location information**

Tables 1 and 2 provide the location and construction information for the monitor wells and extraction wells constructed in the vicinity of the ash ponds. These wells were sampled in the December 2011 and September 2012 sample rounds.



## **Four Corners Power Plant**

### **Geohydrology Data Submittal**

February 13, 2013

Figure 12 shows the location of the existing monitor wells. Later in 2013, additional monitor wells are planned for construction to replace existing wells that must be abandoned due to activities related to closure of the old Evaporation Ponds 1-4 and the construction of the new South Intercept Trench discussed below. New wells are also planned to provide additional information related to the impact of Morgan Lake on the local groundwater. These wells will be drilled between Morgan Lake and the eastern edge of the ash disposal area and at locations within the ash disposal area between old ash ponds 3, 5 and 6. The data from these wells should better define the gradient and flow direction of the groundwater between Morgan Lake and the ash disposal area. Additional wells are also planned for locations to the south of the ash disposal area to better define the extent and quality of the groundwater in this area. Figure 14 shows the planned location of these new wells and their planned depth.

Exhibit 1 contains copies of the geologic logs for the monitor wells and for geologic borings that provide the basis for the attached geologic cross-sections. The exhibit also contains figures showing the location of these wells and borings.

#### **Planned Closure of Evaporation Ponds 1-4 and Capping of the Old Ash Disposal Areas**

Construction began in 2012 to close Evaporation Ponds 1-4 and the underlying Ash Ponds 1 and 2. The liners for Evaporation Ponds 1-4 and the evaporites contained in those ponds have been removed and disposed into the lined Phase 1 Dry Fly Ash Disposal Area. Construction is proceeding to re-grade and install an evapotranspiration (ET) cap on top of Ash Ponds 1 and 2. This construction is scheduled for completion in the summer of 2013. The Ash Pond 6 closure project is scheduled to begin construction in the summer of 2013. Ash Pond 6 and those parts of old Ash ponds 3 and 5 not covered by the LAI and LDWP will be re-graded and an ET cap installed. This project is planned for completion by the summer of 2014.

#### **Intercept Trench Construction and Design**

In 1993, two sets of extraction wells were installed. One set was installed at the northwest corner of Evaporation Ponds 1-4. The second set was installed to the southwest of Evaporation Ponds 1-4. The wells have been in continuous operation since that time. Additional extraction wells were added to the southwestern area in 2011. After review of the well operation and analysis of the geological information, it was determined that a more effective system was needed to provide a continuous barrier to groundwater flow. As discussed above, the groundwater flows in a relatively thin layer of weathered Lewis Shale and in small local alluvial channels that drain towards the Chaco River. The geophysical data along with data gathered by continuous geological cores and test pits also showed the groundwater sometimes flows in thin joint systems within the Lewis shale. The data also show that the Lewis Shale has very low permeability. As a result, it is extremely difficult to install wells that can efficiently capture the groundwater and provide a continuous barrier to flow towards the Chaco River. An intercept trench system on the other hand can be constructed in a way to provide a continuous barrier to trap this groundwater flow.

# **Four Corners Power Plant**

## **Geohydrology Data Submittal**

February 13, 2013

In 2011, an intercept trench known as the “North Intercept Trench” was installed along the alignment of geologic cross-section Section B-B’ (Figure 3). Figure 13 shows the location of the North Intercept Trench and a detailed cross-section of the trench construction. A drainage pipe was set at the bottom of the trench, which is located at the interface between the weathered and un-weathered Lewis Shale. This design allows the drain to capture the groundwater flow in the un-weathered shale and any local alluvial channels intercepted by the trench. Water captured by the drain flows towards sumps where it is collected and pumped to the LDWP. The North Intercept Trench began operation on October 31, 2011.

Figure 13 shows the water levels prior to start of operation (October 2010) and after start of operation (May 2011) in wells located just down gradient of the trench system. After the North Intercept Trench became operational, the groundwater levels were lowered up to 10 feet to a location close to the bottom of the trench and the interface between the un-weathered and weathered Lewis Shale. This demonstrates that the North Intercept Trench is performing as expected and capturing the groundwater flow in the weathered shale.

Construction is planned to start in February 2013 on the South Intercept Trench. The location of this trench is shown on Figure 14 and follows the alignment of geologic cross-section C-C’ shown on Figure 4. The South Intercept Trench will connect with the North Intercept Trench, and together, the two trenches are designed to form a complete barrier to groundwater flow to the west towards the Chaco River. The design of the South Intercept Trench is similar to that of the North Intercept Trench. The bottom of the South Intercept Trench will be located at the interface between the un-weathered and weathered Lewis Shale. This trench will be considerably deeper than the North Intercept Trench. The deepest section is expected to be at least 60 feet deep at its deepest point near a local alluvial channel in the vicinity of well MW-38 shown on Figure 4. Construction of the South Intercept Trench should be complete in the early fall of 2013.

### **Conclusion**

The data provided in this report represent our best evaluation of the geohydrology beneath the site. The data show that the groundwater is primarily moving in the weathered Lewis shale and in local alluvial channels that drain towards the Chaco River. Operational changes at the Plant, closure and capping of old ash disposal areas and construction of new intercept trench systems have reduced and once complete should prevent this migration of groundwater.

In 1993, extraction well systems were installed and began operation. Since 2004, all new fly ash from the Four Corners Units 1-3 has been placed in lined ash impoundments. Since 2007, all new fly ash from Units 4 and 5 has been placed in the lined DFADA. Construction is in progress to close and cap the old ash disposal areas. Installation of the ET cap at Ash Ponds 1 and 2 is scheduled to be completed this summer. Construction is scheduled to begin in the summer of 2013 on the closure of Ash Pond No. 6. It is expected that installation of the ET cap on Ash Pond 6 will be completed by the summer of 2014.

## **Four Corners Power Plant**

### **Geohydrology Data Submittal**

February 13, 2013

Finally, to provide a continuous barrier to the flow of groundwater towards the Chaco River, the Plant is constructing an intercept trench system located west of the ash impoundments along a north-south alignment (see Figures 13 and 14). The northern portion of this trench system began operation in October 2011. Construction on South Intercept Trench is planned to start in February 2013 and is scheduled to begin operation in the fall of 2013.

After the intercept trench system is complete and the old ash impoundments are closed and capped, we are confident that any further migration of groundwater towards the Chaco River will be contained and prevented.

# **Four Corners Power Plant**

## **Geohydrology Data Submittal**

February 13, 2013

### **References**

Stone, W. J.; Lyford, F.P.; Frenzel, P.F.; Mizell, H.H.; and Padgett, E.T., 1983.  
Hydrology and Water Resources of San Juan Basin, New Mexico. New Mexico  
Bureau of Mines and Mineral Resources, Hydrologic Report 6, 70p.

**Four Corners Power Plant**  
Geohydrology Data Submittal  
February 13, 2013

TABLES

Table 1 Four Corners Power Plant Monitor Well and Extraction Well Location Data  
Survey, May 27, 2012 through June 29, 2012 by Souder, Miller Associates

Well	Well Type	Northing	Easting	Latitude	Longitude	Ground Surface Elevation	Top of Steel Casing	Top of PVC Casing	Comment
DMX-1	Monitor	2,071,870.306	2,521,916.064	N36° 41' 30.68488"	W108° 31' 10.22868"	5096.03	5097.19	5096.54	
DMX-2	Monitor	2,071,078.439	2,521,966.704	N36° 41' 22.85844"	W108° 31' 9.53735"	5100.04	5101.47	5100.88	
DMX-3	Monitor	2,070,872.970	2,521,291.767	N36° 41' 20.77894"	W108° 31' 17.80601"	5084.85	5086.16	5085.5	
DMX-4	Monitor	2,068,429.771	2,520,848.352	N36° 40' 56.58897"	W108° 31' 23.03438"	5072.11	5073.53	5073	
DMX-5	Extraction	2,067,741.201	2,521,646.366	N36° 40' 49.83698"	W108° 31' 13.17688"	5081.42	5083.23	NM	Active Ext Well - Flange top
DMX-6	Monitor	2,067,192.477	2,521,605.850	N36° 40' 44.40829"	W108° 31' 13.62602"	5076.42	5077.79	5077.4	
EW-1	Extraction	2,067,117.671	2,521,581.465	N36° 40' 43.63647"	W108° 31' 13.90389"	5073.99	5074.75	NM	Active Extraction Well - Flange top
EW-10	Extraction	2,070,930.509	2,521,907.421	N36° 41' 21.39151"	W108° 31' 10.25222"	5096.08	5096.78	5095.91	Inactive Extraction Well
EW-11	Extraction	2,071,004.665	2,521,925.866	N36° 41' 22.12608"	W108° 31' 10.03228"	5099.56	5100.16	NM	Active Extraction Well - Flange top
EW-12	Extraction	2,071,061.640	2,521,957.721	N36° 41' 22.6917"	W108° 31' 9.64617"	5100.57	5101.39	NM	Active Extraction Well - Flange top
EW-13	Extraction	2,071,289.322	2,521,956.677	N36° 41' 24.94295"	W108° 31' 9.67899"	5098.88	5099.17	5098.04	Inactive Extraction Well
EW-14	Extraction	2,067,703.196	2,521,509.638	N36° 40' 49.4515"	W108° 31' 14.85207"	5078.85	5079.65	NM	Active Extraction Well - Flange top
EW-15	Extraction	2,067,874.965	2,521,370.949	N36° 40' 51.14012"	W108° 31' 16.56978"	5076.82	5077.73	NM	Active Extraction Well - Flange top
EW-2	Extraction	2,067,178.547	2,521,592.389	N36° 40' 44.2696"	W108° 31' 13.79004"	5075.9	5076.88	5075.42	Inactive Extraction Well - aluminum cap
EW-3	Extraction	2,067,243.795	2,521,601.307	N36° 40' 44.91541"	W108° 31' 13.68631"	5082.02	5083.03	5081.6	Inactive Extraction Well - aluminum cap
EW-4	Extraction	2,067,306.571	2,521,610.752	N36° 40' 45.53681"	W108° 31' 13.57588"	5079.38	5081.45	5079.07	Inactive Extraction Well - aluminum cap
EW-5	Extraction	2,067,369.999	2,521,619.875	N36° 40' 46.13773"	W108° 31' 13.47436"	5074.93	5075.89	NM	Active Extraction Well - Flange top
EW-6	Extraction	2,067,427.107	2,521,614.397	N36° 40' 46.70759"	W108° 31' 13.55145"	5073.24	5073.87	NM	Active Extraction Well - Flange top
EW-7	Extraction	2,067,489.136	2,521,636.632	N36° 40' 47.34386"	W108° 31' 13.27422"	5073.74	5074.34	NM	Inactive Extraction Well - Flange top
EW-8	Extraction	2,067,553.653	2,521,646.219	N36° 40' 47.98249"	W108° 31' 13.1622"	5077.76	5078.41	5077.1	Inactive Extraction Well - aluminum cap
EW-9	Extraction	2,070,867.932	2,521,884.289	N36° 41' 20.77111"	W108° 31' 10.53073"	5096.1	5096.63	5095.39	Inactive Extraction Well
GM-2	Monitor	2,068,482.316	2,523,534.853	N36° 40' 57.2983"	W108° 30' 50.05768"	5125.96	5126.32	5127.69	
LS-1	Monitor	2,069,533.473	2,529,315.997	N36° 41' 8.09203"	W108° 29' 39.17298"	5368.47	5370.57	5369.8	
LS-2	Monitor	2,068,498.802	2,529,315.422	N36° 40' 57.86105"	W108° 29' 39.09251"	5397.9	5400.16	5399.49	
MW-1	Monitor	2,070,662.810	2,523,914.506	N36° 41' 18.88579"	W108° 30' 45.58641"	5138.48	5140.43	5139.8	
MW-2	Monitor	2,070,756.362	2,524,362.875	N36° 41' 19.84222"	W108° 30' 40.0896"	5148.92	5151.03	5150.47	
MW-3	Monitor	2,071,277.192	2,523,713.381	N36° 41' 24.94674"	W108° 30' 48.10925"	5125.52	5126.98	5126.73	
MW-4	Monitor	2,072,409.042	2,524,302.007	N36° 41' 36.17976"	W108° 30' 40.98041"	5148.51	5149.66	5149.32	
MW-5	Monitor	2,070,570.696	2,520,764.200	N36° 41' 17.75254"	W108° 31' 24.25662"	5087.31	5089.3	5088.5	
MW-6	Monitor	2,068,063.444	2,521,470.891	N36° 40' 53.01091"	W108° 31' 15.35944"	5080.19	5082.71	NM	Flange Top
MW-7	Monitor	2,067,347.919	2,524,866.308	N36° 40' 46.1744"	W108° 30' 33.61361"	5148.29	5149.9	5149.32	
MW-8	Monitor	2,067,581.981	2,523,451.559	N36° 40' 48.38988"	W108° 30' 51.00179"	5120.85	5122.97	5122.56	
MW-10	Monitor	2,065,094.409	2,525,297.908	N36° 40' 23.92153"	W108° 30' 28.12067"	5149.65	5151.19	5150.71	
MW-11	Monitor	2,066,102.300	2,523,277.542	N36° 40' 33.74646"	W108° 30' 53.00903"	5110.48	5112.84	5111.96	
MW-12R	Monitor	2,068,365.170	2,527,509.566	N36° 40' 56.41608"	W108° 30' 1.25118"	5261.71	5264.7	5264.44	

Horizontal Control is State Plan Coordinates New Mexico West Zone, (code 3003) NAD83

Vertical Ortho-metric height computed in NAVD88 using Geoid09 datum.

Note: NM = No Measurement. NA = Not Applicable

Table 1 Four Corners Power Plant Monitor Well and Extraction Well Location Data  
Survey, May 27, 2012 through June 29, 2012 by Souder, Miller Associates

<u>Well</u>	<u>Well Type</u>	<u>Northing</u>	<u>Easting</u>	<u>Latitude</u>	<u>Longitude</u>	<u>Ground Surface Elevation</u>	<u>Top of Steel Casing</u>	<u>Top of PVC Casing</u>	<u>Comment</u>
MW-13	Monitor	2,066,528.206	2,525,040.922	N36° 40' 38.08117"	W108° 30' 31.39916"	5149.52	5151.36	5150.75	
MW-15	Monitor	2,066,785.433	2,521,852.445	N36° 40' 40.40087"	W108° 31' 10.56304"	5092.28	5094.26	5093.93	
MW-16	Monitor	2,066,347.131	2,522,638.010	N36° 40' 36.12238"	W108° 31' 0.88113"	5100.42	5102.2	5101.32	
MW-17	Monitor	2,069,573.914	2,521,950.173	N36° 41' 7.98046"	W108° 31' 9.60818"	5094.38	5097.03	5096.42	
MW-18	Monitor	2,069,694.441	2,521,036.433	N36° 41' 9.10746"	W108° 31' 20.83694"	5088.06	5089.8	5089.1	
MW-19	Monitor	2,071,286.957	2,522,890.880	N36° 41' 24.9855"	W108° 30' 58.20871"	5126.34	5128.26	5127.4	
MW-20	Monitor	2,072,202.151	2,523,319.355	N36° 41' 34.06513"	W108° 30' 53.02777"	5128.59	5130.98	5130.55	
MW-21	Monitor	2,073,087.495	2,524,415.484	N36° 41' 42.89628"	W108° 30' 39.64596"	5154.47	5155.97	5155.04	
MW-22	Monitor	2,073,074.023	2,524,878.134	N36° 41' 42.79536"	W108° 30' 33.96404"	5156.3	5157.34	5156.51	
MW-23	Monitor	2,070,718.763	2,521,884.608	N36° 41' 19.29614"	W108° 31' 10.51371"	5097.04	5099.03	5098.65	
MW-24	Monitor	2,068,062.320	2,521,480.455	N36° 40' 53.00046"	W108° 31' 15.24193"	5080.41	5082.24	5081.65	
MW-25	Monitor	2,067,567.149	2,523,455.085	N36° 40' 48.24347"	W108° 30' 50.95721"	5121.79	5123.75	5122.71	
MW-26	Monitor	2,070,666.388	2,523,905.003	N36° 41' 18.92051"	W108° 30' 45.7034"	5138.36	5140.06	5139.26	
MW-30	Monitor	2,072,222.658	2,521,960.648	N36° 41' 34.17211"	W108° 31' 9.71222"	5084.38	5084.54	5084.15	
MW-31	Monitor	2,072,695.419	2,521,955.295	N36° 41' 38.8464"	W108° 31' 9.81948"	5088.47	5091.52	5091.12	
MW-32	Monitor	2,071,643.570	2,521,962.678	N36° 41' 28.4462"	W108° 31' 9.63643"	5084.94	5088.03	5087.65	
MW-33	Monitor	2,068,867.856	2,520,813.547	N36° 41' 0.91829"	W108° 31' 23.50036"	5074.26	5077.25	5076.85	
MW-34	Extraction	2,068,099.790	2,521,293.156	N36° 40' 53.35769"	W108° 31' 17.54461"	5077.34	5078.33	NM	Active Extraction Well - Flange top
MW-35	Monitor	2,067,229.414	2,522,434.520	N36° 40' 44.83211"	W108° 31' 3.45639"	5091.81	5093.77	5093.15	
MW-36	Monitor	2,069,951.374	2,521,841.331	N36° 41' 11.7051"	W108° 31' 10.97761"	5089.61	5092.55	5092.1	
MW-37	Monitor	2,068,287.634	2,522,206.115	N36° 40' 55.27973"	W108° 31' 6.35312"	5092.49	5095.3	5094.73	
MW-38	Monitor	2,068,081.654	2,522,247.142	N36° 40' 53.24589"	W108° 31' 5.83138"	5092.38	5095.35	5094.74	
MW-39	Monitor	2,068,277.996	2,522,207.807	N36° 40' 55.18455"	W108° 31' 6.33151"	5092.73	5095.35	5094.93	
MW-40	Monitor	2,069,609.076	2,523,640.187	N36° 41' 8.44718"	W108° 30' 48.86263"	5134.91	5138.02	5137.08	
MW-41	Monitor	2,071,279.193	2,527,525.246	N36° 41' 25.23127"	W108° 30' 1.30751"	5253.98	5256.97	5256.06	
MW-42	Monitor	2,072,910.359	2,526,527.600	N36° 41' 41.29157"	W108° 30' 13.69663"	5222.32	5225.23	5224.56	
MW-43	Monitor	2,072,045.990	2,530,655.841	N36° 41' 33.02706"	W108° 29' 22.93453"	5269.42	5272.46	5271.58	
MW-44	Monitor	2,065,826.301	2,525,157.767	N36° 40' 31.14881"	W108° 30' 29.90415"	5145.15	5147.37	5146.89	
Piez	Monitor	2,071,073.019	2,521,938.923	N36° 41' 22.80289"	W108° 31' 9.87797"	5100.21	NA	5101.18	Located 18 ft W and 8 ft N of EW-12, PVC casing only
Piez 5/6	Monitor	2,067,399.417	2,521,617.417	N36° 40' 46.45534"	W108° 31' 13.50222"	5073.59	NA	5073.85	Located btwn EW-5 and EW-6, PVC casing only
Well-2	Monitor	2,072,953.829	2,526,803.337	N36° 41' 41.74046"	W108° 30' 10.31466"	5246.06	5247.55	5247.54	

Horizontal Control is State Plan Coordinates New Mexico West Zone, (code 3003) NAD83

Vertical Ortho-metric height computed in NAVD88 using Geoid09 datum.

Note: NM = No Measurement. NA = Not Applicable

TABLE 2 Four Corners Power Plant

## Well Construction Data

Well ID	Installation Date	Casing	Cased Depth of Well (ft bgs)	Screen Interval (feet bgs)		Screen Length (ft)	Drilled TD (ft bgs)	Installed Pump	Notes
				Top of Screen	Bottom of Screen				
MW-1	Sep-87	4-inch Sch 80 PVC	21.6	11.6	21.6	10	22	Bladder pump	
MW-2	Mar-87	4-inch Sch 80 PVC	29.7	9.7	29.7	20	30	Bladder pump	Obstruction at 11.1 ft btoc on 8/31/2010. Not operational
MW-3	Mar-87	4-inch Sch 80 PVC	44.25	14.25	44.25	30	80	Bladder pump	
MW-4	Mar-87	4-inch Sch 80 PVC	35	15	35	20	40	Bladder pump	
MW-5	Mar-87	4-inch Sch 80 PVC	49.1	29.1	49.1	20	49.9	Bladder pump	Transducer
MW-6	Mar-87	4-inch Sch 80 PVC	48.8	28.8	48.8	20	50	Bladder pump	Transducer
MW-7	Mar-87	4-inch Sch 80 PVC	34.7	14.7	34.7	20	35	Bladder pump	
MW-8	Mar-87	4-inch Sch 80 PVC	47.7	27.7	47.7	20	50.35	Bladder pump	
MW-9	Mar-87		NA	NA	NA	NA	20	NA	Part of Phase I monitor well installation plan. Boring dry. Not completed as a well.
MW-10	Mar-87	4-inch Sch 80 PVC	33	13	33	20	35	None	DRY
MW-11	Mar-87	4-inch Sch 80 PVC	49.9	29.9	49.9	20	49.9	Bladder pump	
MW-12	Sep-87	4-inch Sch 80 PVC	40	19.5	40	20.5	40	NA	Abandoned 5/17/2012
MW-12R	Mar-12	5-inch Sch 80 PVC	33.5	13.5	33.5	20	70	None	
MW-13	Sep-87	4-inch Sch 80 PVC	54.9	34.9	54.9	20	54.9	None	DRY
MW-14	Sep-87	4-inch Sch 80 PVC	39.9	19.9	39.9	20	39.9	NA	Abandoned 5/17/2012
MW-15	Sep-87	4-inch Sch 80 PVC	52.7	22.2	52.2	30	54.1	Bladder pump	Transducer
MW-16	Sep-87	4-inch Sch 80 PVC	54.8	35.5	54.8	19.3	54.8	Bladder pump	
MW-17	Sep-87	4-inch Sch 80 PVC	24.7	4.2	24.2	20	24.7	Bladder pump	DRY
MW-18	Sep-87	4-inch Sch 80 PVC	55	25.5	55	29.5	55	Bladder pump	Transducer
MW-19	Sep-87	4-inch Sch 80 PVC	49.7	29.2	49.7	20.5	49.7	Bladder pump	
MW-20	Sep-87	4-inch Sch 80 PVC	30	9.5	30	20.5	40	Bladder pump	
MW-21	Sep-87	4-inch Sch 80 PVC	30	10.6	30	19.4	30	Bladder pump	
MW-22	Sep-87	4-inch Sch 80 PVC	30.4	10.4	30.4	20	30.4	Bladder pump	
MW-23	Sep-87	4-inch Sch 80 PVC	49	29	49	20	50	Bladder pump	
MW-24	Sep-87	4-inch Sch 80 PVC	69.7	59.7	69.7	10	69.7	Bladder pump	Transducer
MW-25	Sep-87	4-inch Sch 80 PVC	54.5	44.5	54.5	10	54.5	None	DRY
MW-26	Sep-87	4-inch Sch 80 PVC	50.5	40.5	50.5	10	50.5	None	DRY
MW-30 <sup>2</sup>	Jun-10	5-inch Sch 80 PVC	26.2	16.2	26.2	10	27.2	None	
MW-31	Jun-10	5-inch Sch 80 PVC	24	14	24	10	25	None	
MW-32	Jun-10	5-inch Sch 80 PVC	20	10	20	10	21	None	
MW-33	Jun-10	5-inch Sch 80 PVC	29	14	29	15	50	None	Transducer
MW-34 <sup>1</sup>	Jun-10	5-inch Sch 80 PVC	49	24	49	25	60	Grundfos 10 SQ-110	Extraction Well.
MW-35	Oct-10	5-inch Sch 80 PVC	30	20	30	10	80	None	
MW-36	Oct-10	5-inch Sch 80 PVC	37	17	37	20	80	None	
MW-37	Oct-10	5-inch Sch 80 PVC	58	48	58	10	80	None	



TABLE 2 Four Corners Power Plant

## Well Construction Data

Well ID	Installation Date	Casing	Cased Depth of Well (ft bgs)	Screen Interval (feet bgs)		Screen Length (ft)	Drilled TD (ft bgs)	Installed Pump	Notes
				Top of Screen	Bottom of Screen				
MW-38	Oct-10	5-inch Sch 80 PVC	39	14	39	25	60	None	
MW-39	Oct-10	5-inch Sch 80 PVC	38	18	38	20	39	None	
MW-40	Mar-12	5-inch Sch 80 PVC	22.5	12.5	22.5	10	50	None	
MW-41	Mar-12	5-inch Sch 80 PVC	35.2	20.2	35.2	15	50	None	
MW-42	Mar-12	5-inch Sch 80 PVC	37	22	37	15	72	None	
MW-43	Mar-12	5-inch Sch 80 PVC	26	16	26	10	60	None	
MW-44	Mar-12	5-inch Sch 80 PVC	23.5	13.5	23.5	10	40	None	
EW-1	1993	5-inch Sch 40 PVC	ND	ND	ND	ND		Yes	Extraction Well.
EW-2	1993	5-inch Sch 40 PVC	ND	ND	ND	ND		None	Inactive Extraction Well
EW-3	1993	5-inch Sch 40 PVC	ND	ND	ND	ND		None	Inactive Extraction Well
EW-4	1993	5-inch Sch 40 PVC	ND	ND	ND	ND		None	Inactive Extraction Well
EW-5	1993	5-inch Sch 40 PVC	ND	ND	ND	ND		Yes	Extraction Well.
EW-6	1993	5-inch Sch 40 PVC	ND	ND	ND	ND		Yes	Extraction Well.
EW-7	1993	5-inch Sch 40 PVC	ND	ND	ND	ND		None	Inactive Extraction Well
EW-8	1993	5-inch Sch 40 PVC	ND	ND	ND	ND		None	Inactive Extraction Well. Transducer installed
EW-9	1993	5-inch Sch 40 PVC	ND	ND	ND	ND		None	Inactive Extraction Well
EW-10	1993	5-inch Sch 40 PVC	ND	ND	ND	ND		None	Inactive Extraction Well
EW-11	1993	5-inch Sch 40 PVC	ND	ND	ND	ND		Yes	Extraction Well.
EW-12	1993	5-inch Sch 40 PVC	ND	ND	ND	ND		Yes	Extraction Well.
EW-13	1993	5-inch Sch 40 PVC	ND	ND	ND	ND		None	Inactive Extraction Well
EW-14 <sup>1</sup>	Oct-10	5-inch Sch 80 PVC	48	18	48	30	49	Grundfos 10 SQ-110	Extraction Well.
EW-15 <sup>1</sup>	Oct-10	5-inch Sch 80 PVC	49	19	49	30	50	Grundfos 10 SQ-110	Extraction Well.
DMX-1	Apr-92	4-inch Sch 40 PVC	39	19	39	20	45	None	
DMX-2	Apr-92	4-inch Sch 40 PVC	35.5	15.5	35.5	20	55	None	
DMX-3	Apr-92	4-inch Sch 40 PVC	38	18	38	20	45	None	
DMX-4	Apr-92	4-inch Sch 40 PVC	51	31	51	20	60	None	Transducer
DMX-5 <sup>1</sup>	Apr-92	4-inch Sch 40 PVC	42	22	42	20	60	Grundfos 10 SQ-110	Extraction Well.
DMX-6	Apr-92	4-inch Sch 40 PVC	35	15	35	20	40	None	Transducer
GM-2	1974	2-inch PVC	ND	ND	ND	ND	22	None	TD est. DRY - Bottom well sounded at 23.25 ft btoc.
LS-1	Oct-03	4-inch Sch 80 PVC	359.5	329.5	359.5	30	360	None	Sample with Hydrosleeve
LS-2	Oct-03	4-inch Sch 80 PVC	358	328	358	30	360	None	Sample with Hydrosleeve
Well-2	ND	2-inch PVC	ND	ND	ND	ND	194	None	Drilled TD est based on June 8, 1987 meas. depth to water of 195.65 ft btoc. Sounded dry at 186.2 ft btoc on 8/31/2010

# TABLE 2 Four Corners Power Plant

## Well Construction Data

Well ID	Installation Date	Casing	Cased Depth of Well (ft bgs)	Screen Interval (feet bgs)		Screen Length (ft)	Drilled TD (ft bgs)	Installed Pump	Notes
				Top of Screen	Bottom of Screen				
Piez	ND	2-inch PVC	ND	ND	ND	ND	ND	None	Peizometer measured for water levels by Four Corners Engineering
Piez 5/6	ND	2-inch PVC	ND	ND	ND	ND	ND	None	Peizometer measured for water levels by Four Corners Engineering

### Notes

NA = Not Applicable

ft bgs = feet below ground surface

ND = No Data

ft btoc = feet below top of PVC casing

ft bgs = feet below ground surface

NS - Not surveyed

ft btoc = feet below top of PVC casing

ND - No Data

<sup>1</sup> Active Extraction Well. Top of PVC not surveyed. Measure point is top of steel flange.

<sup>2</sup> MW-30: Original grade was backfilled due to construction of trench. Top of steel was 3.39 feet above ground surface


and PVC was 2.95 feet above ground surface. Therefore old surface elevation was approximately 5018.2 ft. rounded to nearest 0.1 ft (Top Steel elev of 5084.54- 3.39ft)

Based on old ground elevation, TD= 24ft bgs, Depth cased = 23ft bgs, top screen = 13ft bgs and bottom screen = 23 ft bgs.

**Four Corners Power Plant**  
Geohydrology Data Submittal  
February 13, 2013

FIGURES



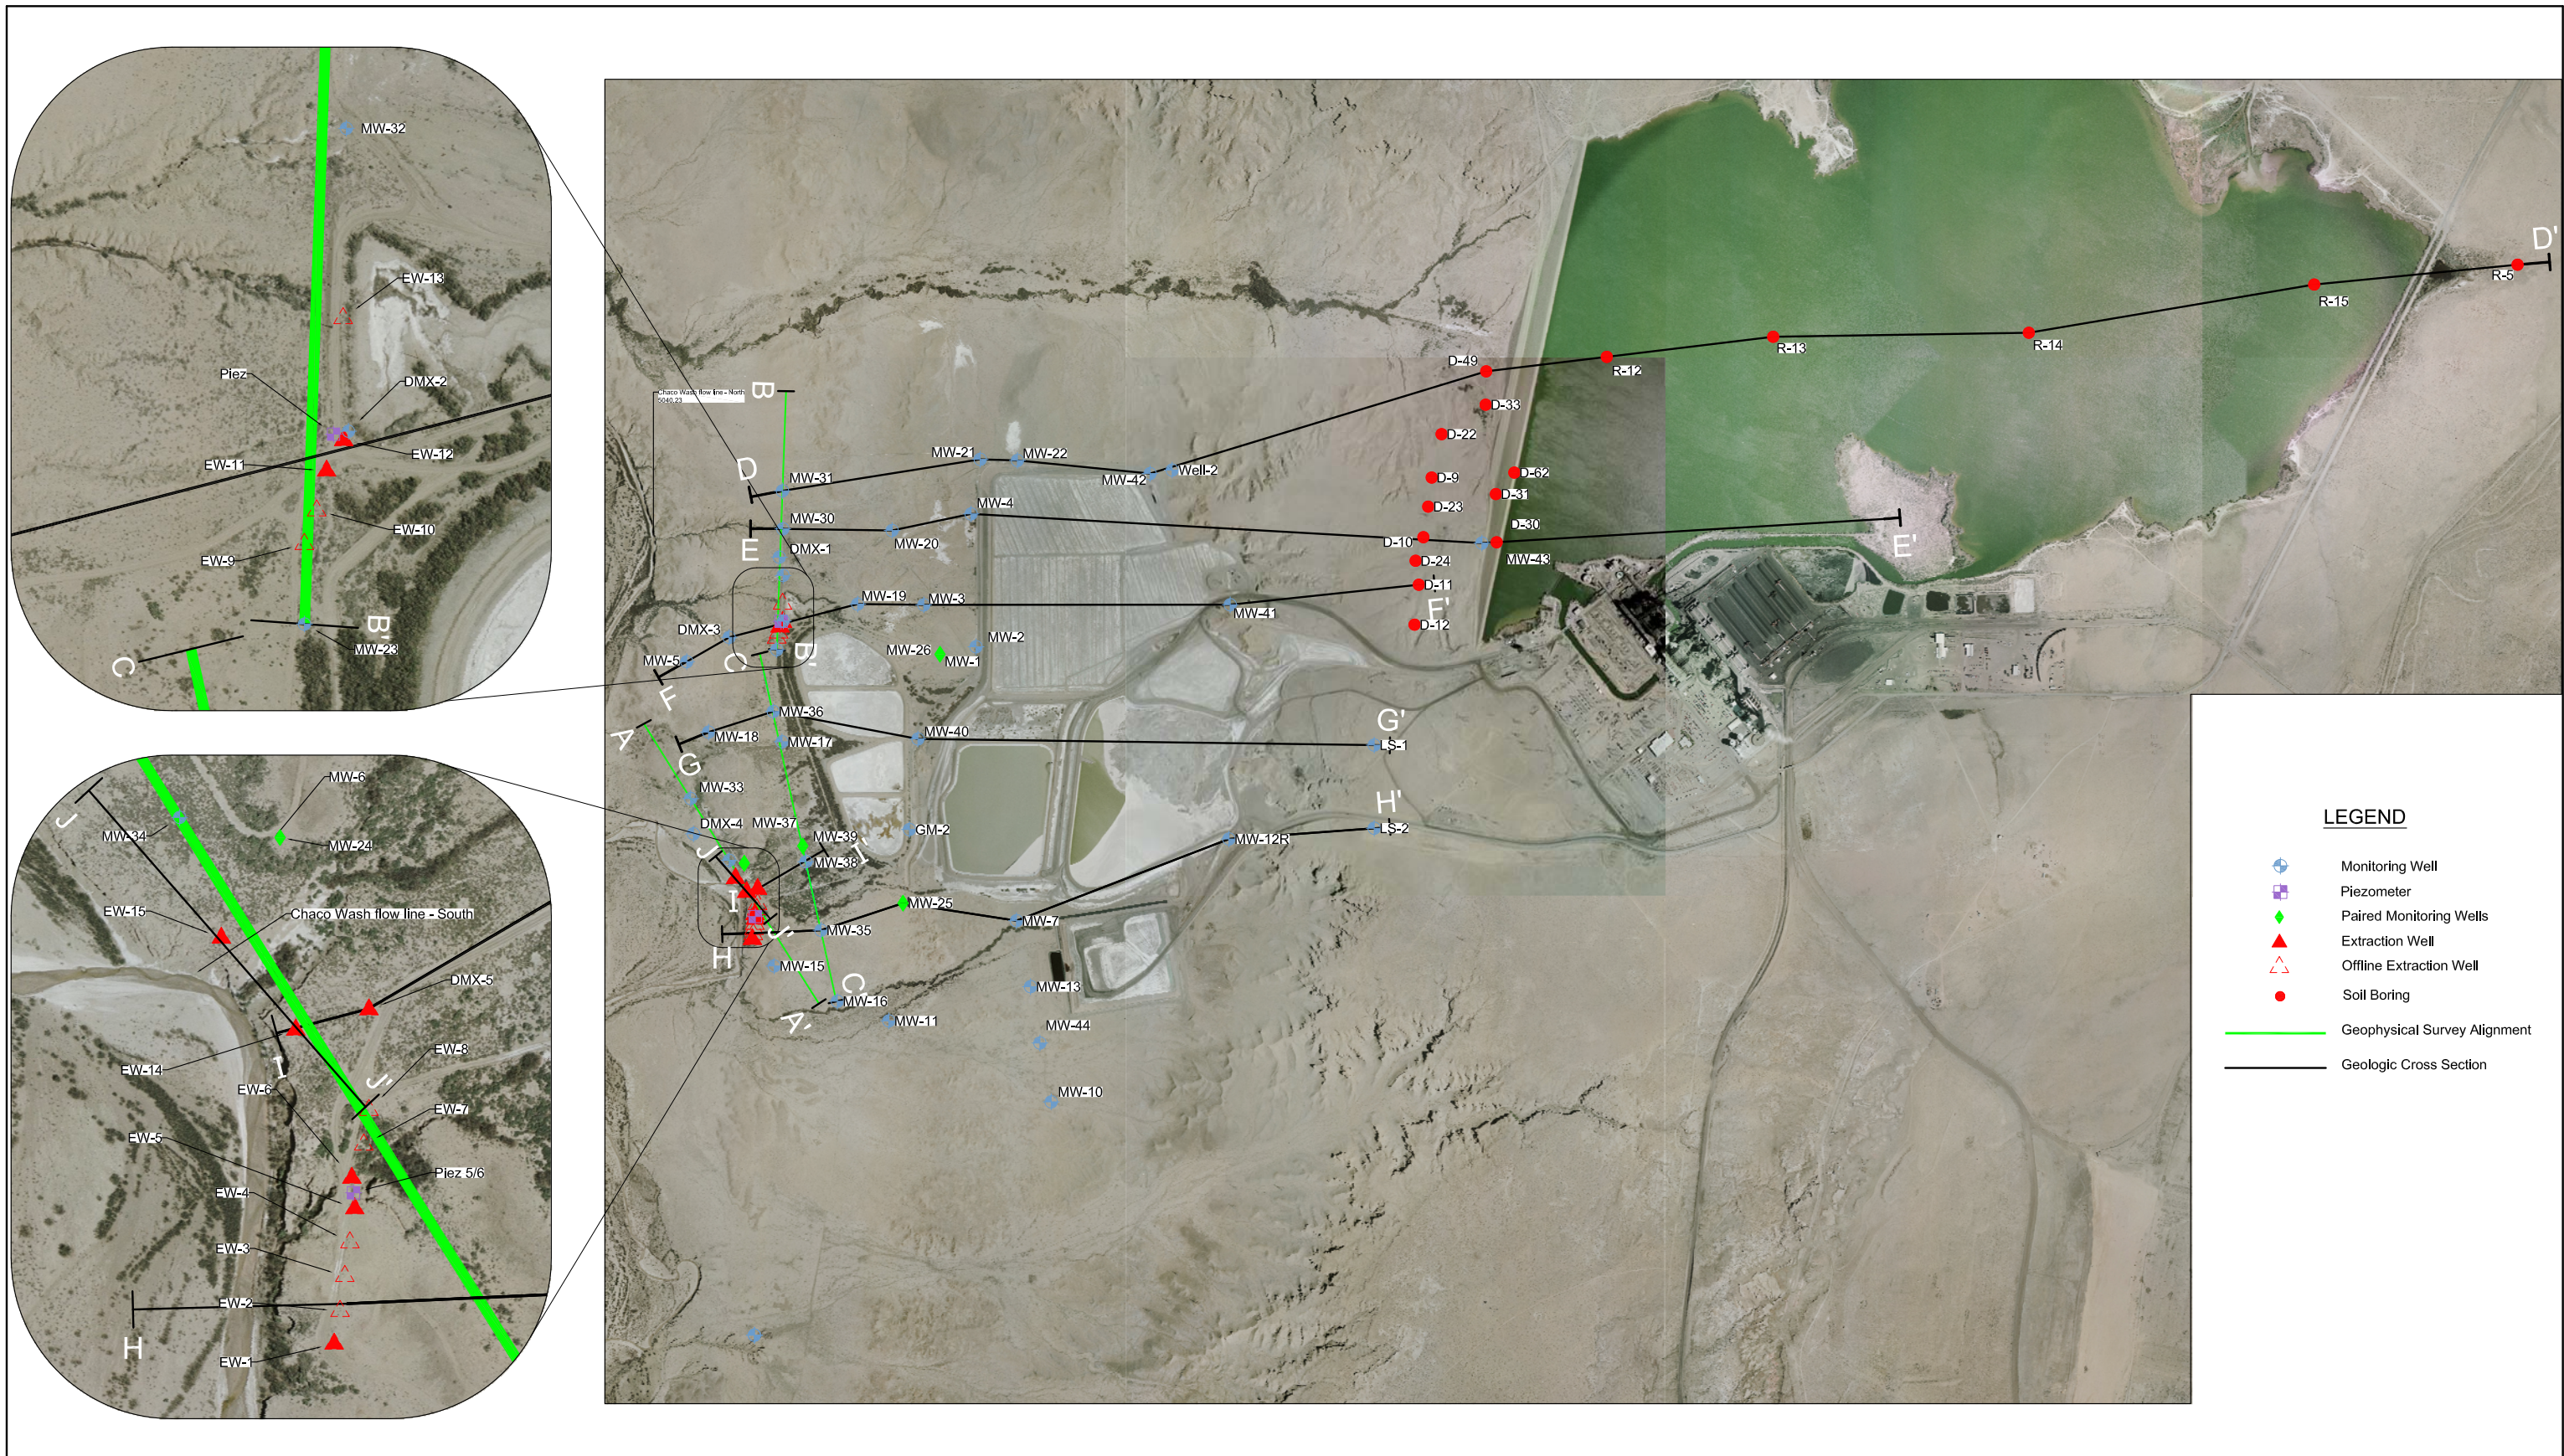

REFERENCE: AERIAL: PROVIDED BY APS (AERIAL MAPPING COMPANY) FLIGHT DATE MAY 7TH, 2010, DATUM: NEW MEXICO STATE PLANE, NAD83, WEST ZONE, US SURVEY FOOT.

TOPOGRAPHY: FLOWN BY "AERO-GRAPHICS, INC." ON NOVEMBER 22, 2006 40 WEST OAKLAND AVENUE, SALT LAKE CITY, UTAH 84115, DATUM: NEW MEXICO STATE PLANE, NAD27/NGVD29, WEST ZONE, US SURVEY FOOT USGS TOPOGRAPHIC QUAD: FRUITLAND, THE HOGBACK NORTH, NM, 1979






P:\WRES\Arizona\_Public\_Service\23446329\_APS\_FCPP\_Wells\_&\_Geology\5\_0\_Technical\5\_6\_CADD\Figures\A18655.dwg




# Geological Cross Section Index Arizona Public Service Four Corners Power Plant

Figure 1






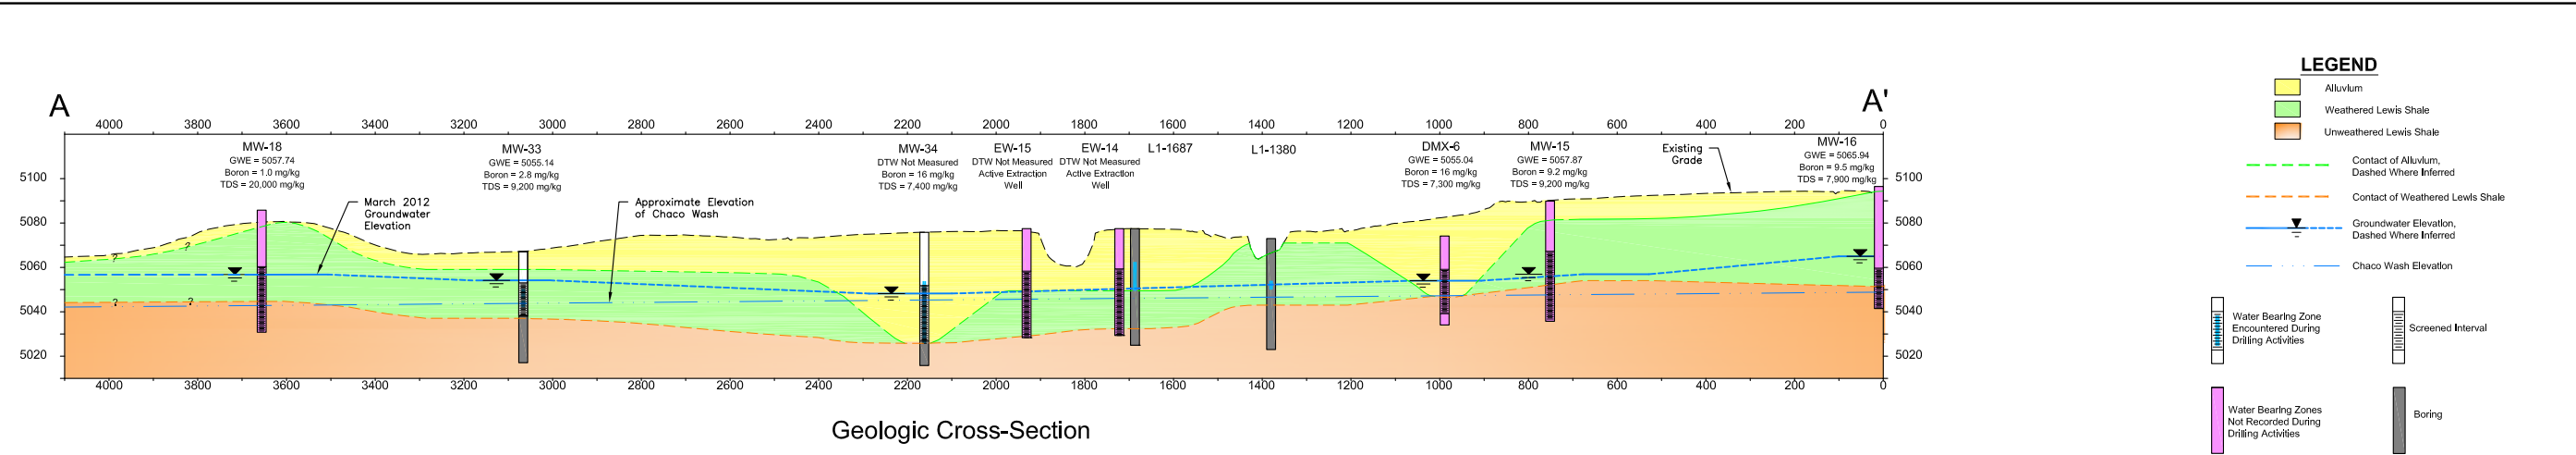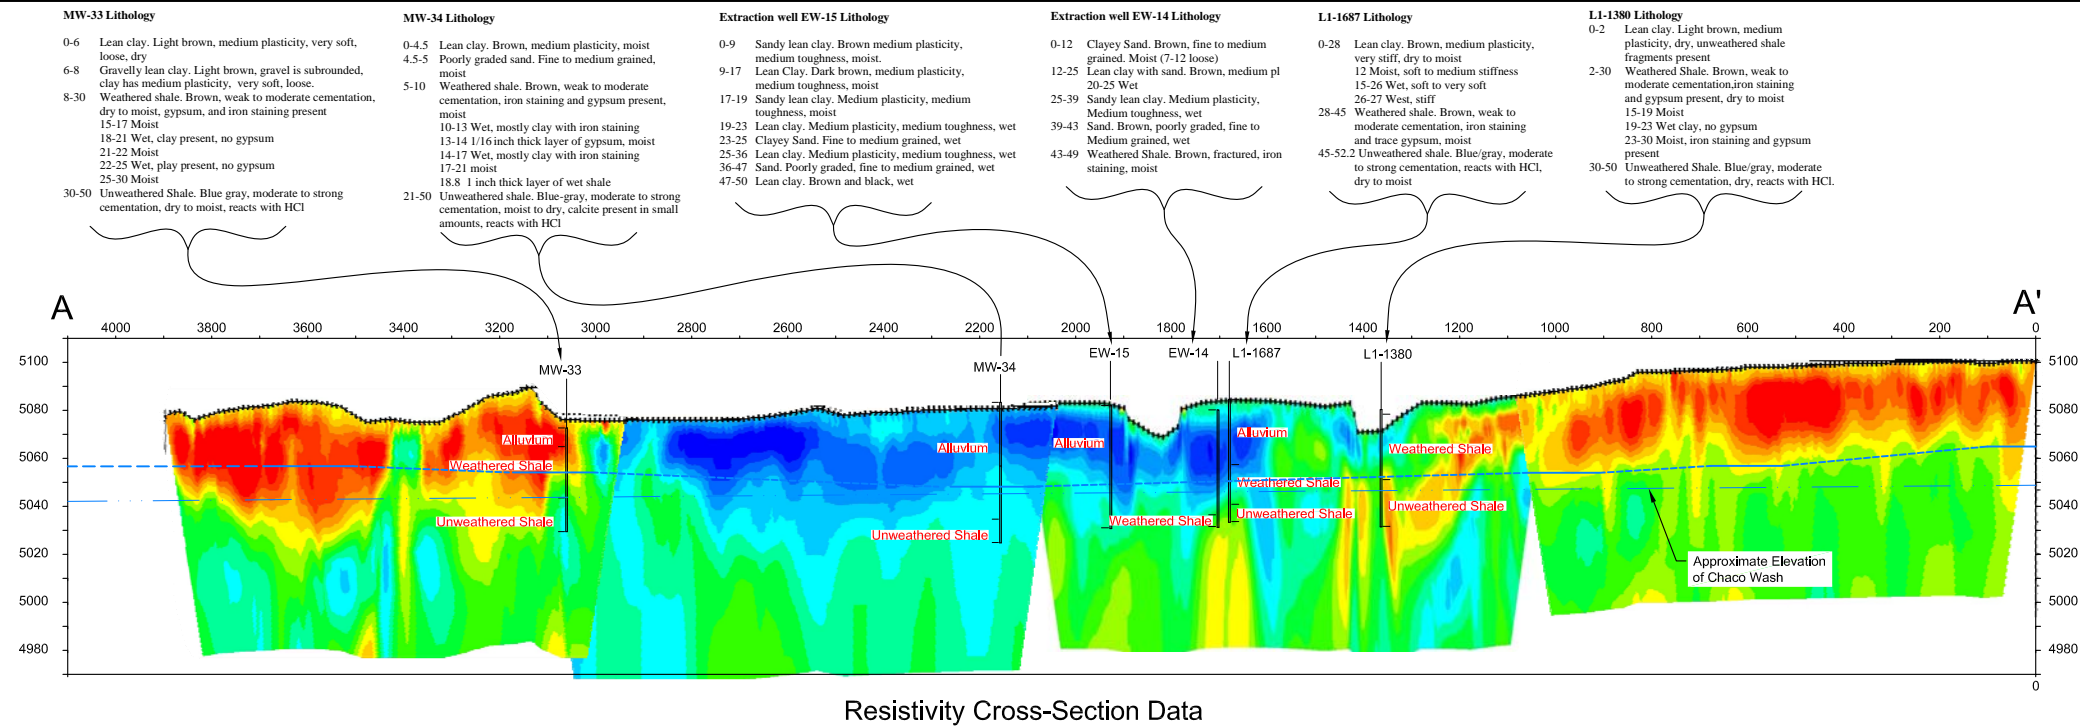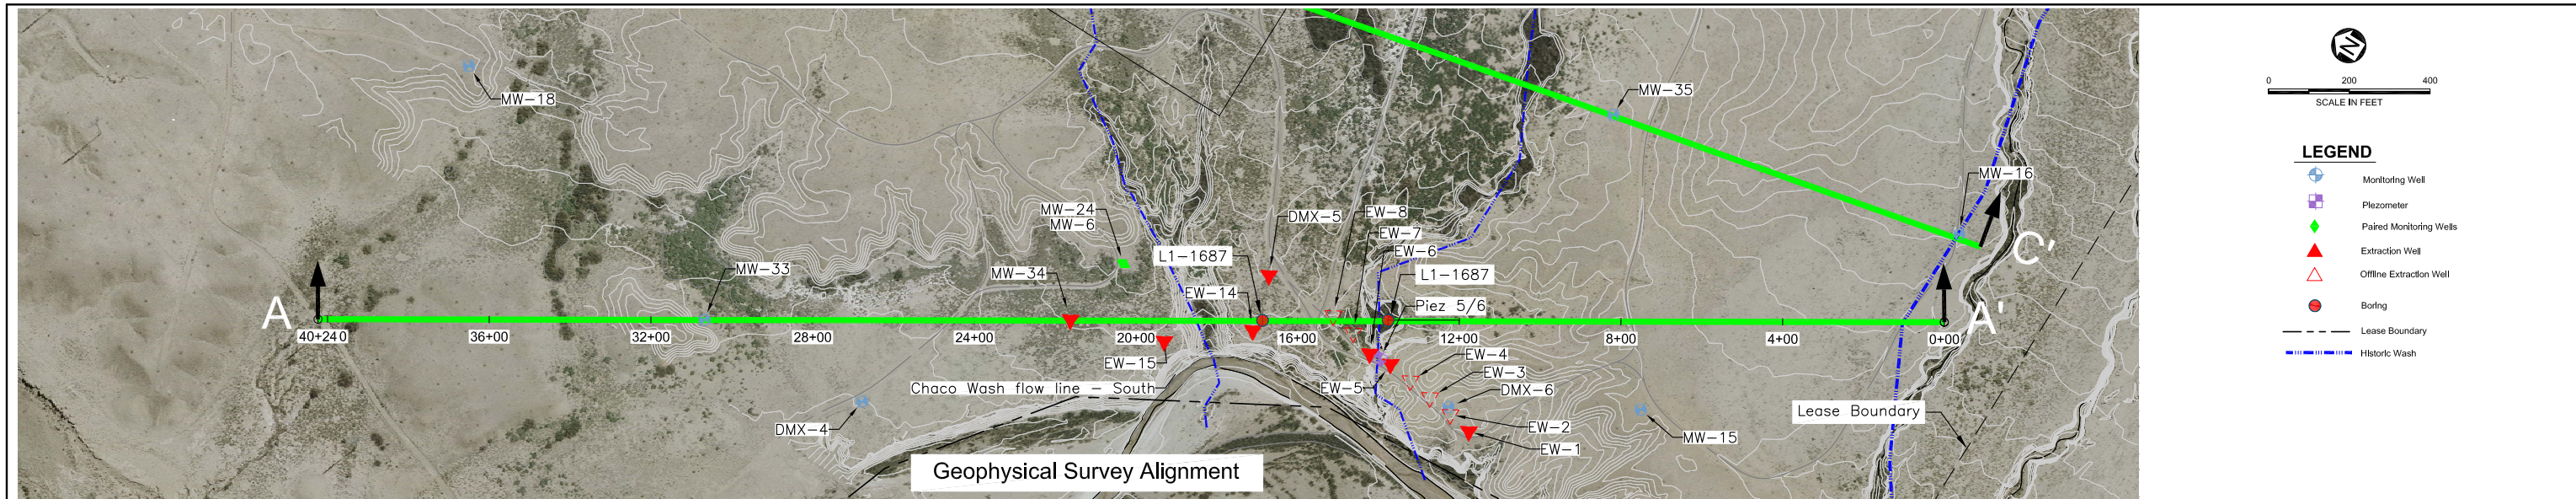



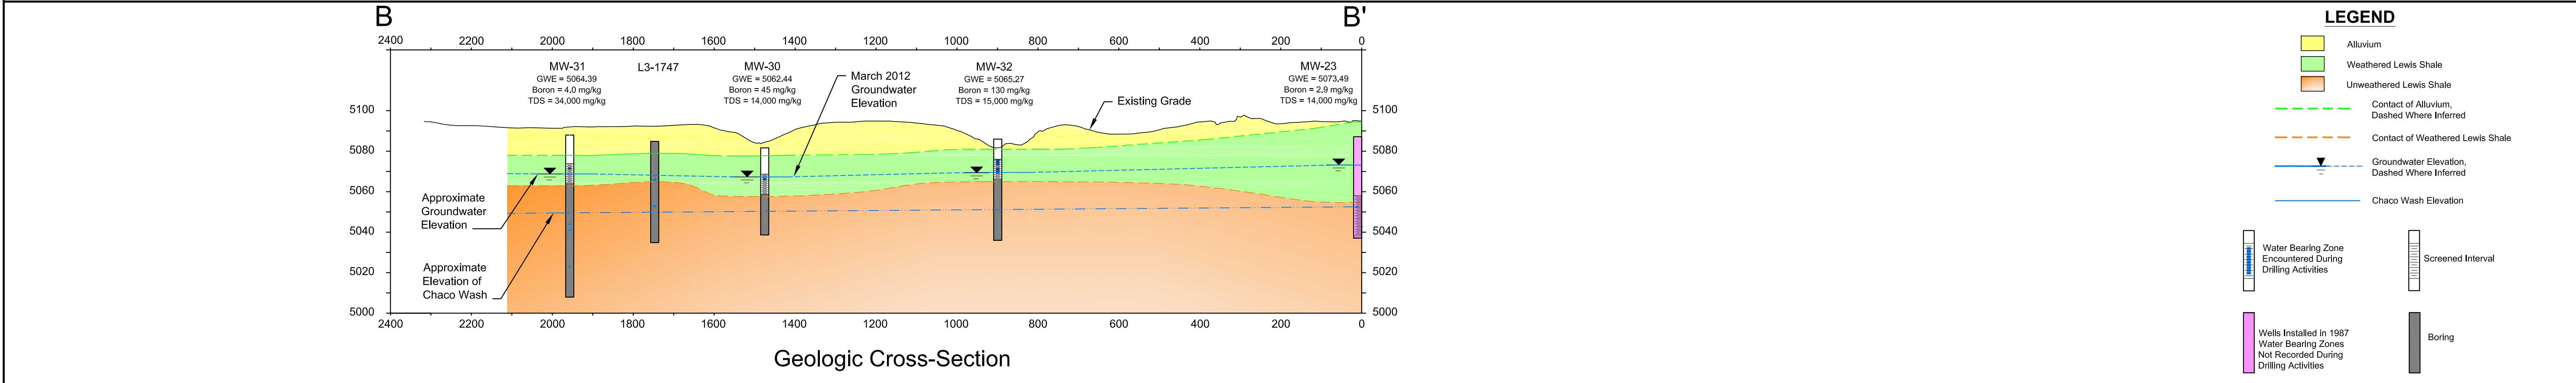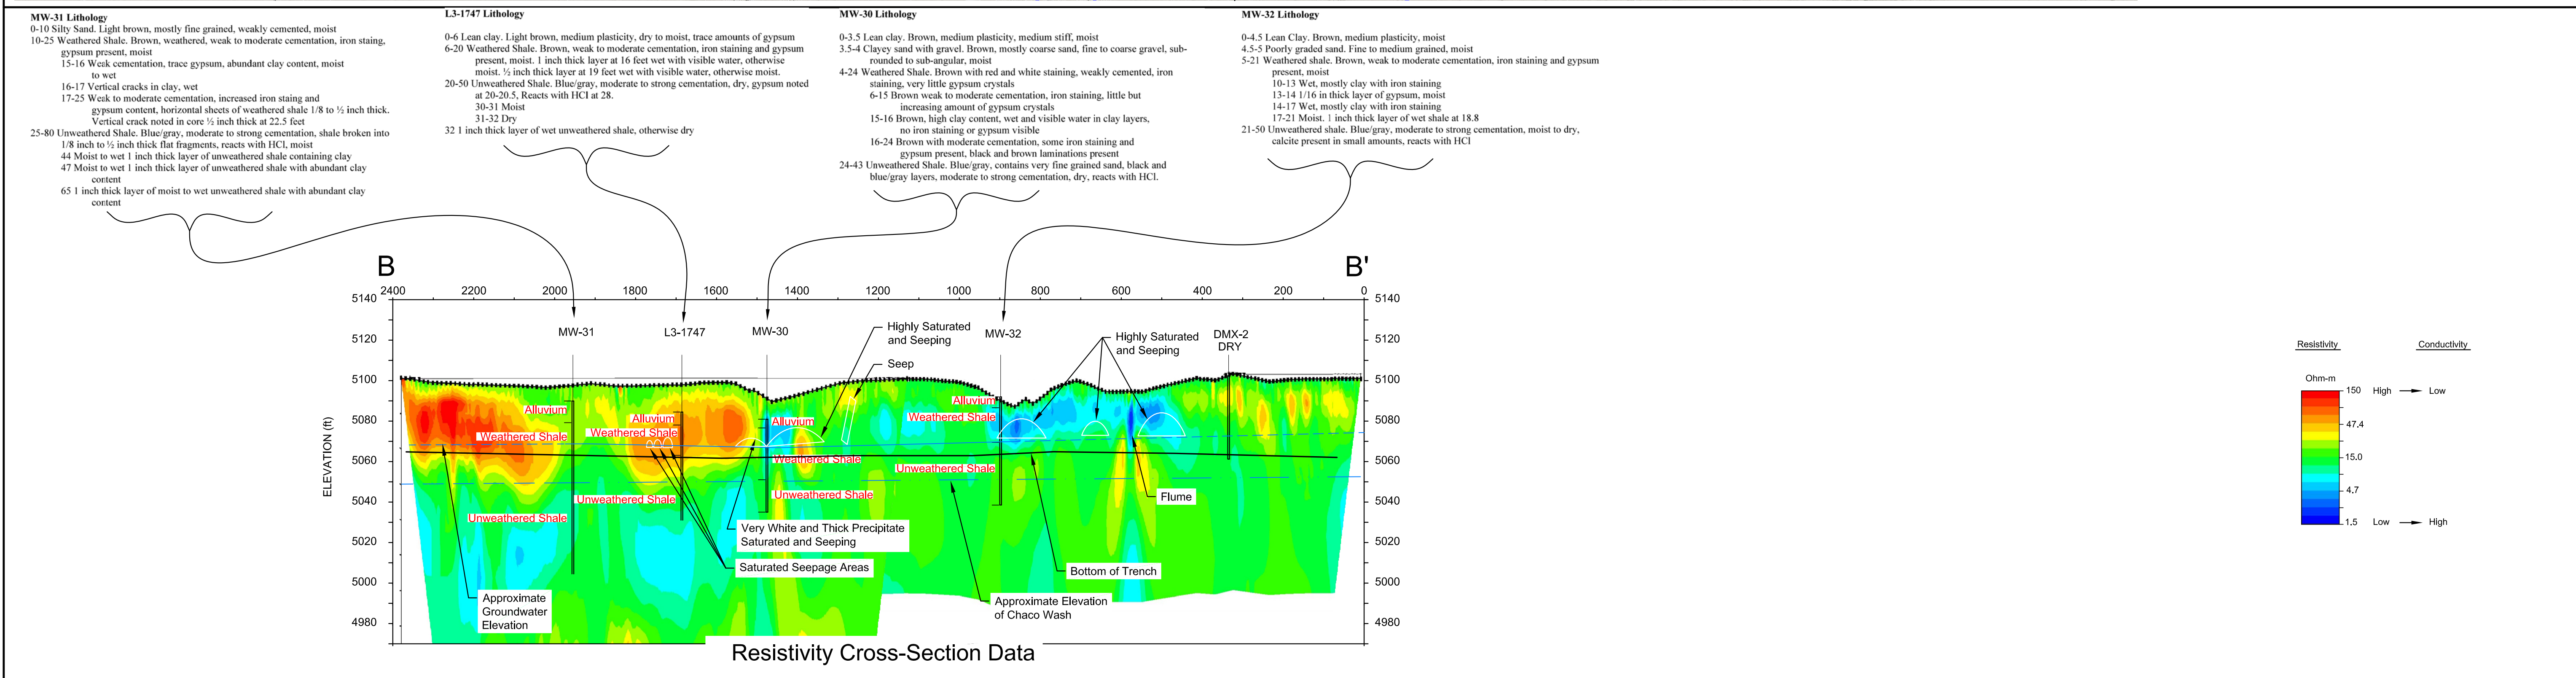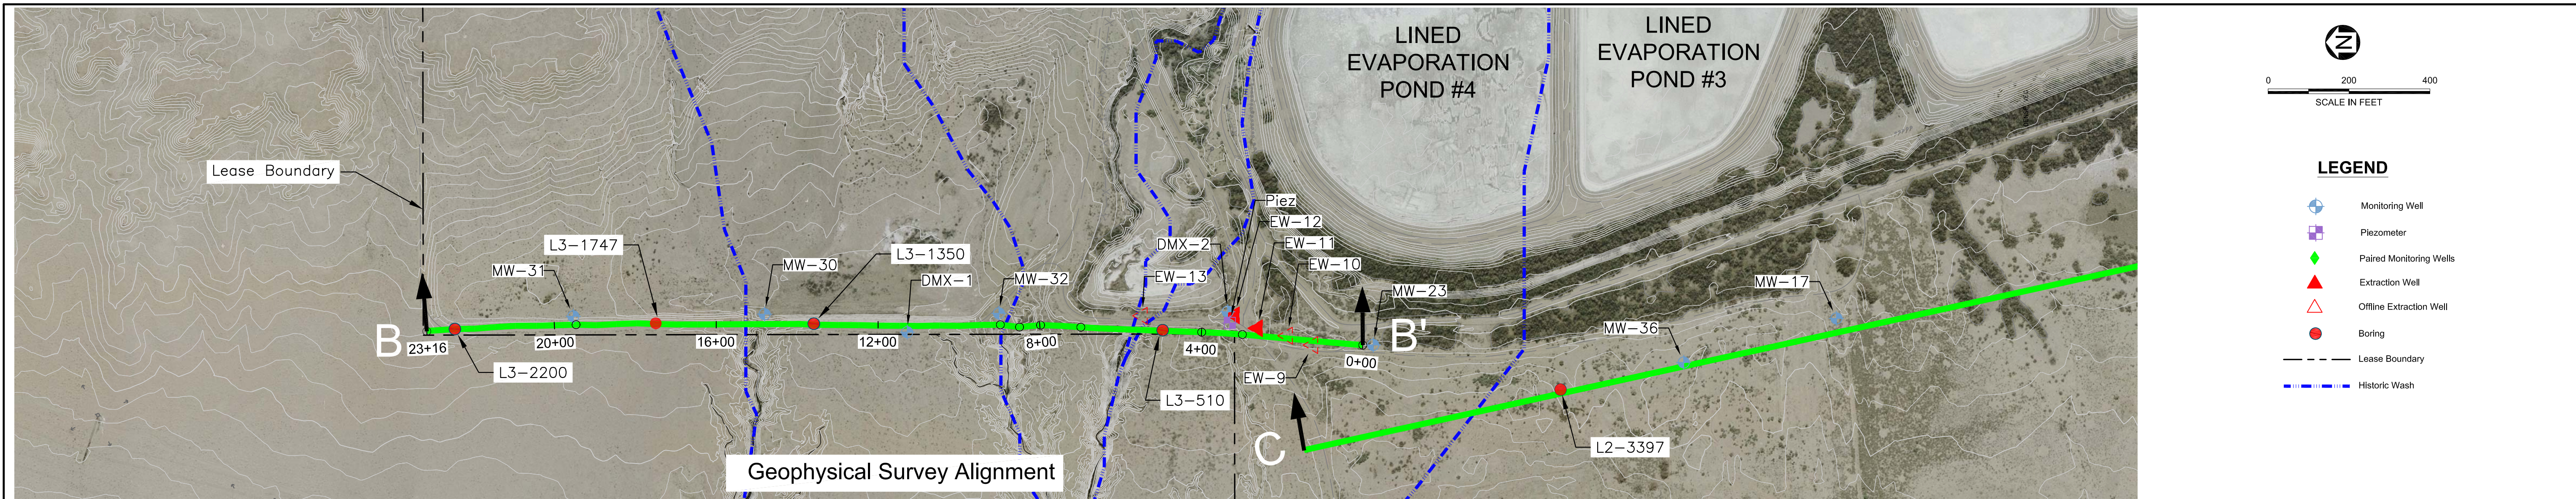




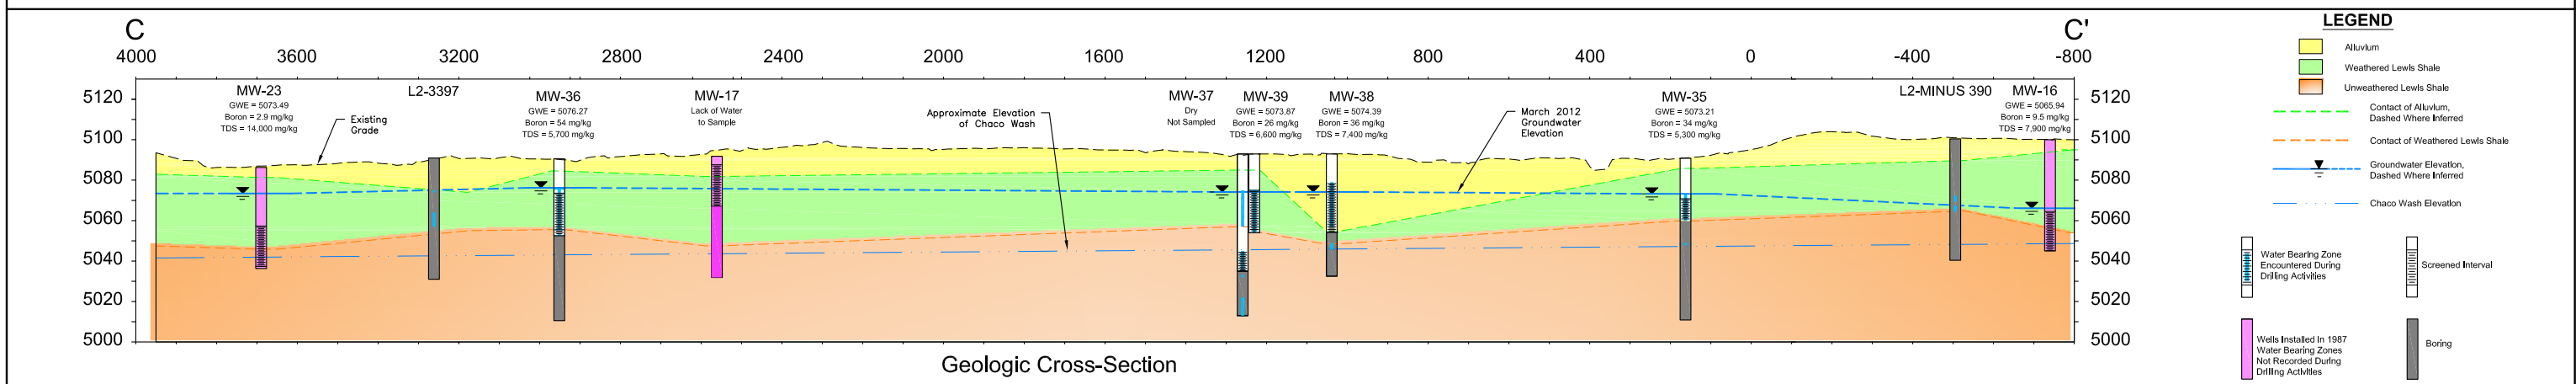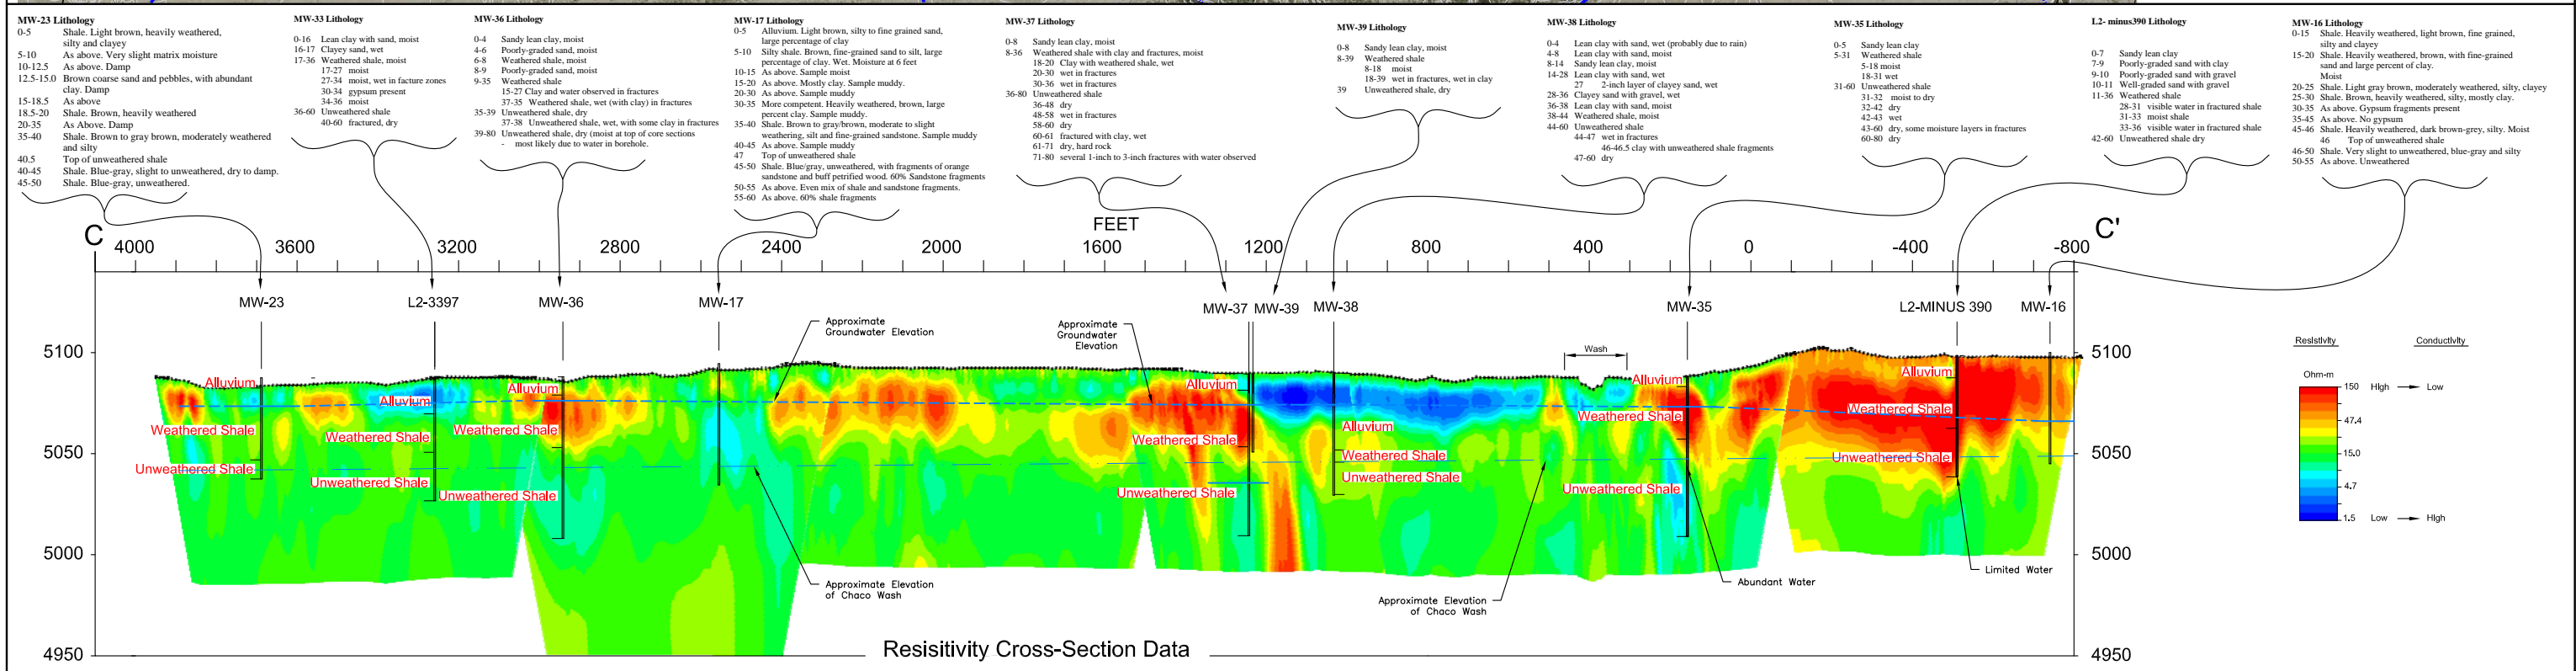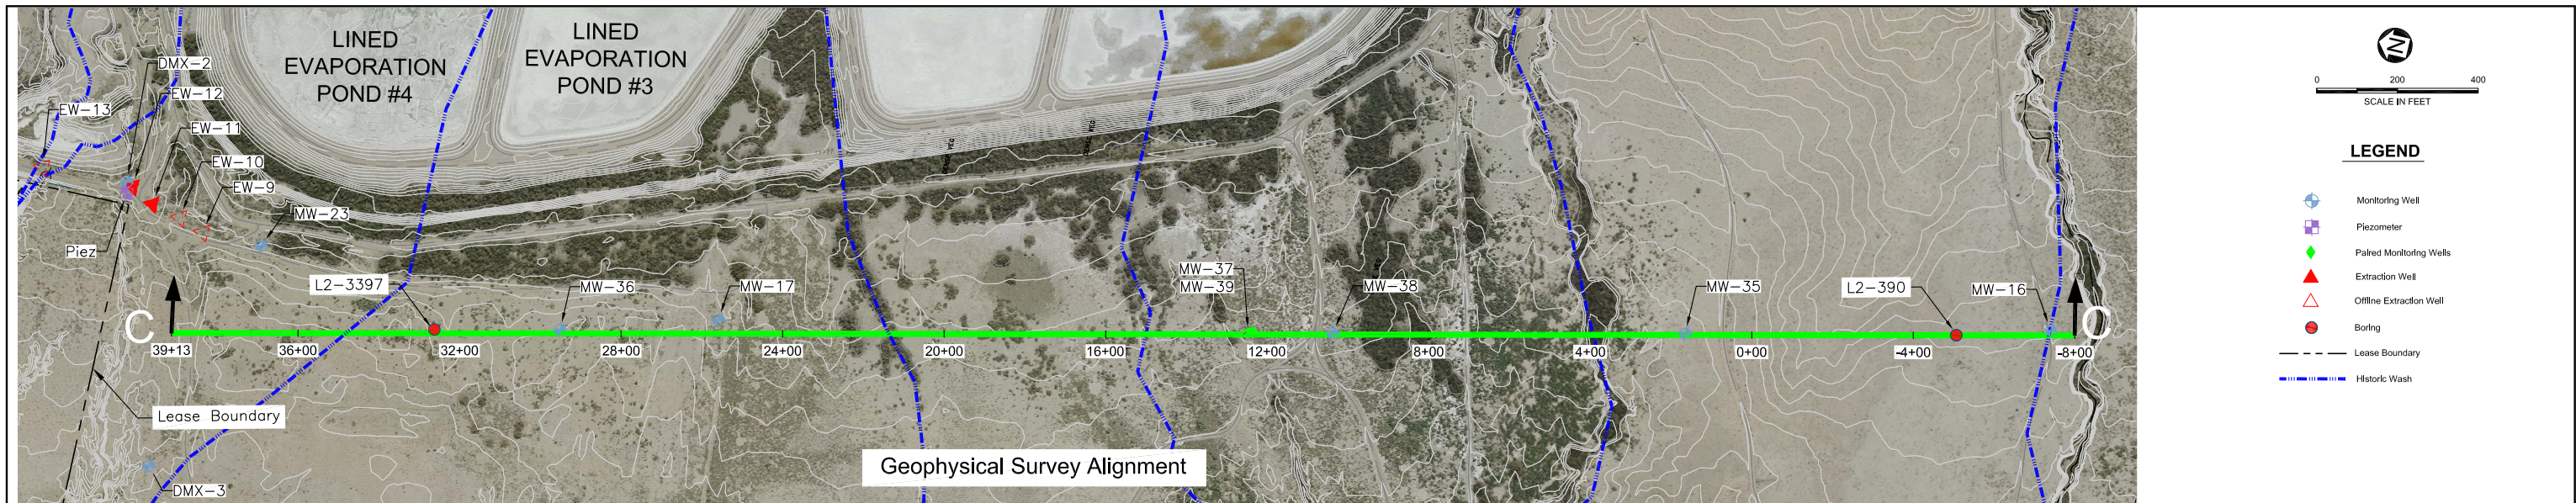




SECTION D-D'

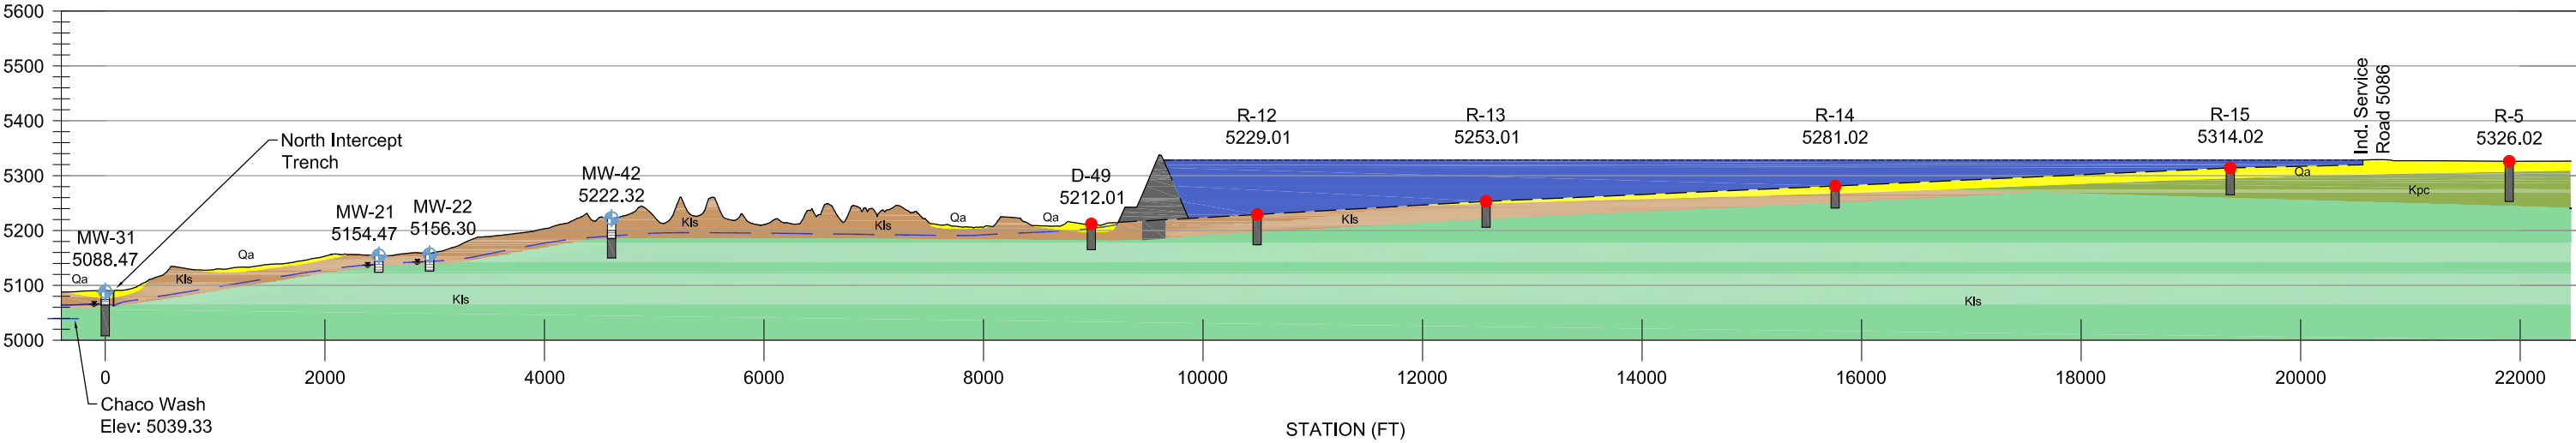

LEGEND

- Monitoring Well
- Soil Boring
- Well and Screen
- Boring
- MW-31 Name Surface Elevation 5088.47
- March 2012 Groundwater elevation (Solid where known, dashed where inferred)
- 2010 Surface Topography (Dashed where inferred)
- Surface Water Elevation
- Morgan Lake Dam
- Morgan Lake
- Qa Alluvium
- Kpc Pictured Cliffs Sandstone
- Kls Weathered Lewis Shale
- Kls Unweathered Lewis Shale
- Kls-LS Limestone

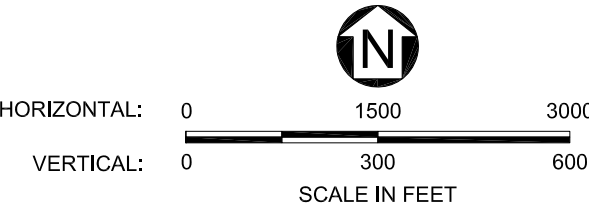

REFERENCE: AERIAL: PROVIDED BY APS (AERIAL MAPPING COMPANY) FLIGHT DATE MAY 7TH, 2010, DATUM: NEW MEXICO STATE PLANE, TRANSVERSE MERCATOR-WEST ZONE, US SURVEY FOOT, N.A.D. 1983, N.A.V.D. 88. TOPOGRAPHY: FLOWN BY "AERO-GRAPHICS, INC." ON NOVEMBER 22, 2006, 40 WEST OAKLAND AVENUE, SALT LAKE CITY, UTAH 84115, DATUM: NEW MEXICO STATE PLANE, NAD83/NAVD88, WEST ZONE, US SURVEY FOOT USGS TOPOGRAPHIC QUAD: FRUITLAND, THE HOGBACK NORTH, NM, 1979. WELL AND CHACO WASH SURVEY, N.A.D.1983, N.A.V.D. 88 BY SOUDER MILLER JULY 2012



DATUM:	CONTROL POINT	NORTHING	EASTING	ELEVATION
	EMMA	N2,066,529.495	E2,528,708.477	5382.251'
	HV53	N2,070,581.505	E2,529,275.542	5331.214'
	HV61	N2,070,581.682	E2,520,166.590	5085.898'


P:\WRES\Arizona\_Public\_Service\23446329\_APS\_FCPP\_Wells\_&\_Geology\5\_0\_Technical\5\_6\_CADD\Figures\ A18643.dwg - Feb 11,2013

Geologic Cross Section D-D'  
Arizona Public Service  
Four Corners Power Plant



Figure 5



SECTION E-E'

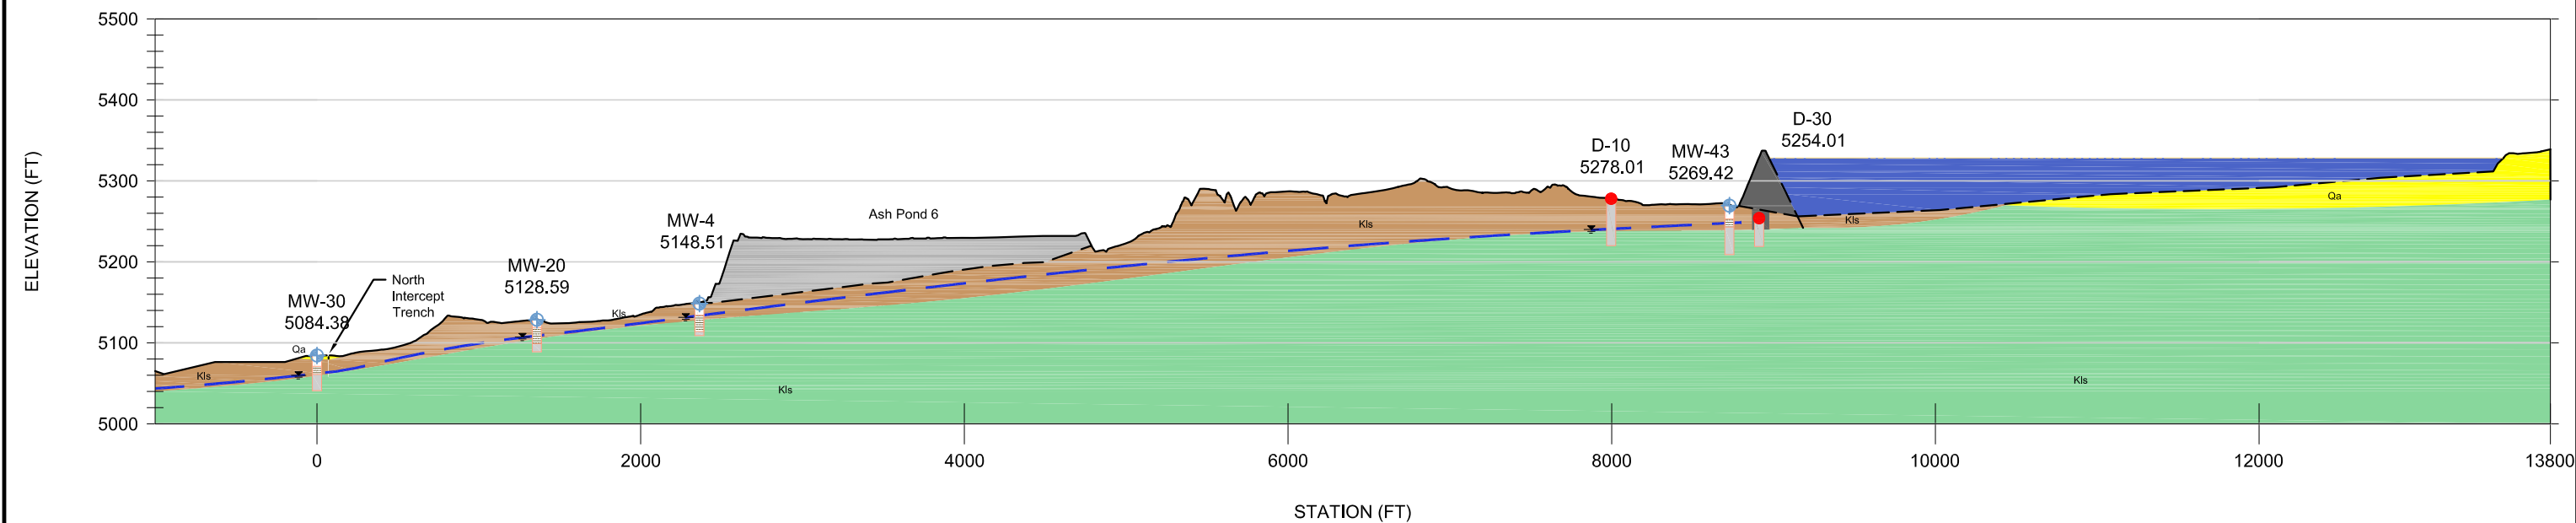

LEGEND

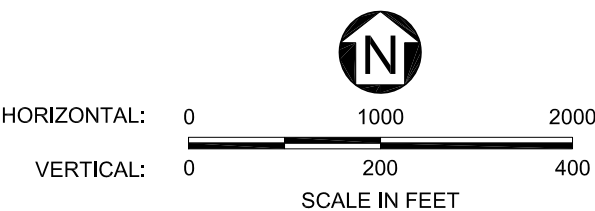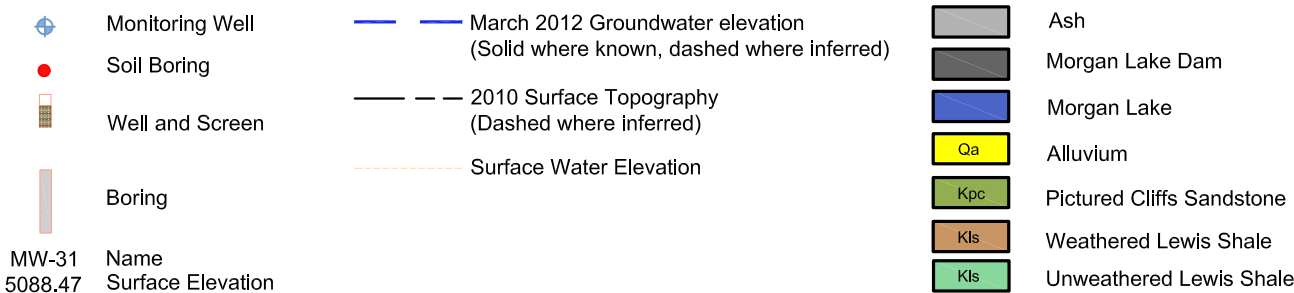

REFERENCE: AERIAL: PROVIDED BY APS (AERIAL MAPPING COMPANY) FLIGHT DATE MAY 7TH, 2010, DATUM: NEW MEXICO STATE PLANE, TRANSVERSE MERCATOR-WEST ZONE, US SURVEY FOOT, N.A.D. 1983, N.A.V.D. 88. TOPOGRAPHY: FLOWN BY "AERO-GRAPHICS, INC." ON NOVEMBER 22, 2006, 40 WEST OAKLAND AVENUE, SALT LAKE CITY, UTAH 84115, DATUM: NEW MEXICO STATE PLANE, NAD83/NAVD88, WEST ZONE, US SURVEY FOOT USGS TOPOGRAPHIC QUAD: FRUITLAND, THE HOGBACK NORTH, NM, 1979. WELL AND CHACO WASH SURVEY, N.A.D.1983, N.A.V.D. 88 BY SOUDER MILLER JULY 2012

DATUM:	CONTROL POINT	NORTHING	EASTING	ELEVATION
	EMMA	N2,066,529.495	E2,528,708.477	5382.251'
	HV53	N2,070,581.505	E2,529,275.542	5331.214'
	HV61	N2,070,581.682	E2,520,166.590	5085.898'


P:\WRES\Arizona\_Public\_Service\23446329\_APS\_FCPP\_Wells\_&\_Geology\5\_0\_Technical\5\_6\_CADD\Figures\A18644.dwg - Feb 11,2013



Geologic Cross Section E-E'  
Arizona Public Service  
Four Corners Power Plant


Figure 6

# SECTION F-F'

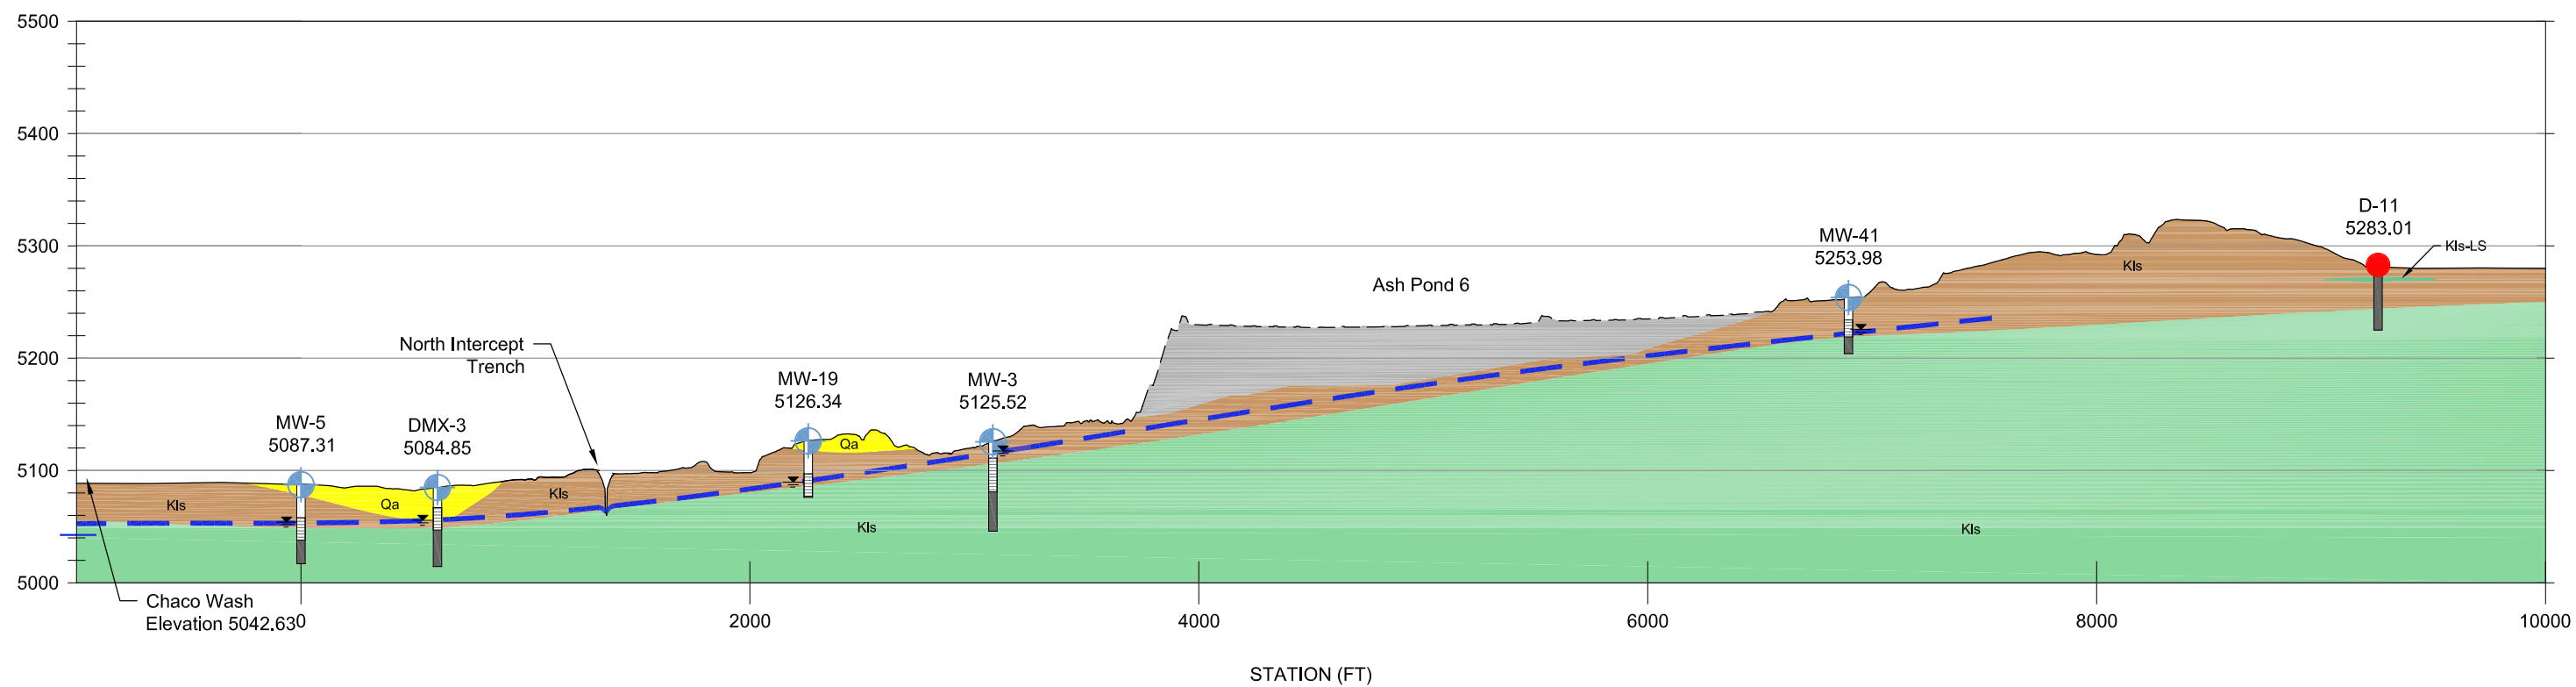

## LEGEND

- |  |   |  |  |  |                           |
|--|---|--|--|--|---------------------------|
|  | Monitoring Well                               |  | March 2012 Groundwater elevation<br>(Solid where known, dashed where inferred) |  | Ash                       |
|  | Soil Boring                                   |  | 2010 Surface Topography<br>(Dashed where inferred)                             |  | Alluvium                  |
|  | Well and Screen                               |  |  |  | Pictured Cliffs Sandstone |
|  | Boring  |  |  |  | Weathered Lewis Shale     |
|  | MW-31<br>5088.47<br>Name<br>Surface Elevation |  |  |  | Unweathered Lewis Shale   |
|  |   |  |  |  | Limestone                 |

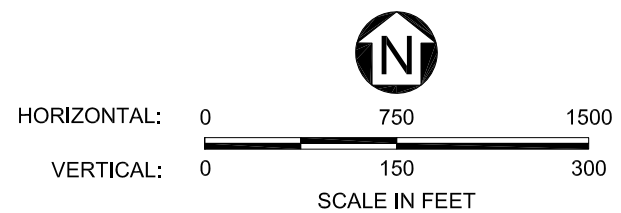

REFERENCE: AERIAL: PROVIDED BY APS (AERIAL MAPPING COMPANY) FLIGHT DATE MAY 7TH, 2010, DATUM: NEW MEXICO STATE PLANE, TRANSVERSE MERCATOR-WEST ZONE, US SURVEY FOOT, N.A.D. 1983, N.A.V.D. 88. TOPOGRAPHY: FLOWN BY "AERO-GRAPHICS, INC." ON NOVEMBER 22, 2006, 40 WEST OAKLAND AVENUE, SALT LAKE CITY, UTAH 84115, DATUM: NEW MEXICO STATE PLANE, NAD83/NAVD88, WEST ZONE, US SURVEY FOOT USGS TOPOGRAPHIC QUAD: FRUITLAND, THE HOGBACK NORTH, NM, 1979. WELL AND CHACO WASH SURVEY, N.A.D.1983, N.A.V.D. 88 BY SOUDER MILLER JULY 2012




DATUM:	CONTROL POINT	NORTHING	EASTING	ELEVATION
	EMMA	N2,066,529.495	E2,528,708.477	5382.251'
	HV53	N2,070,581.505	E2,529,275.542	5331.214'
	HV61	N2,070,581.682	E2,520,166.590	5085.898'

P:\WRES\Arizona\_Public\_Service\23446329\_APS\_FCPP\_Wells\_-\_Geology\5\_0\_Technical\5\_6\_CADD\Figures\ A18645.dwg - Feb 08,2013

Geologic Cross Section F-F'  
Arizona Public Service  
Four Corners Power Plant


Figure 7

# SECTION G-G'

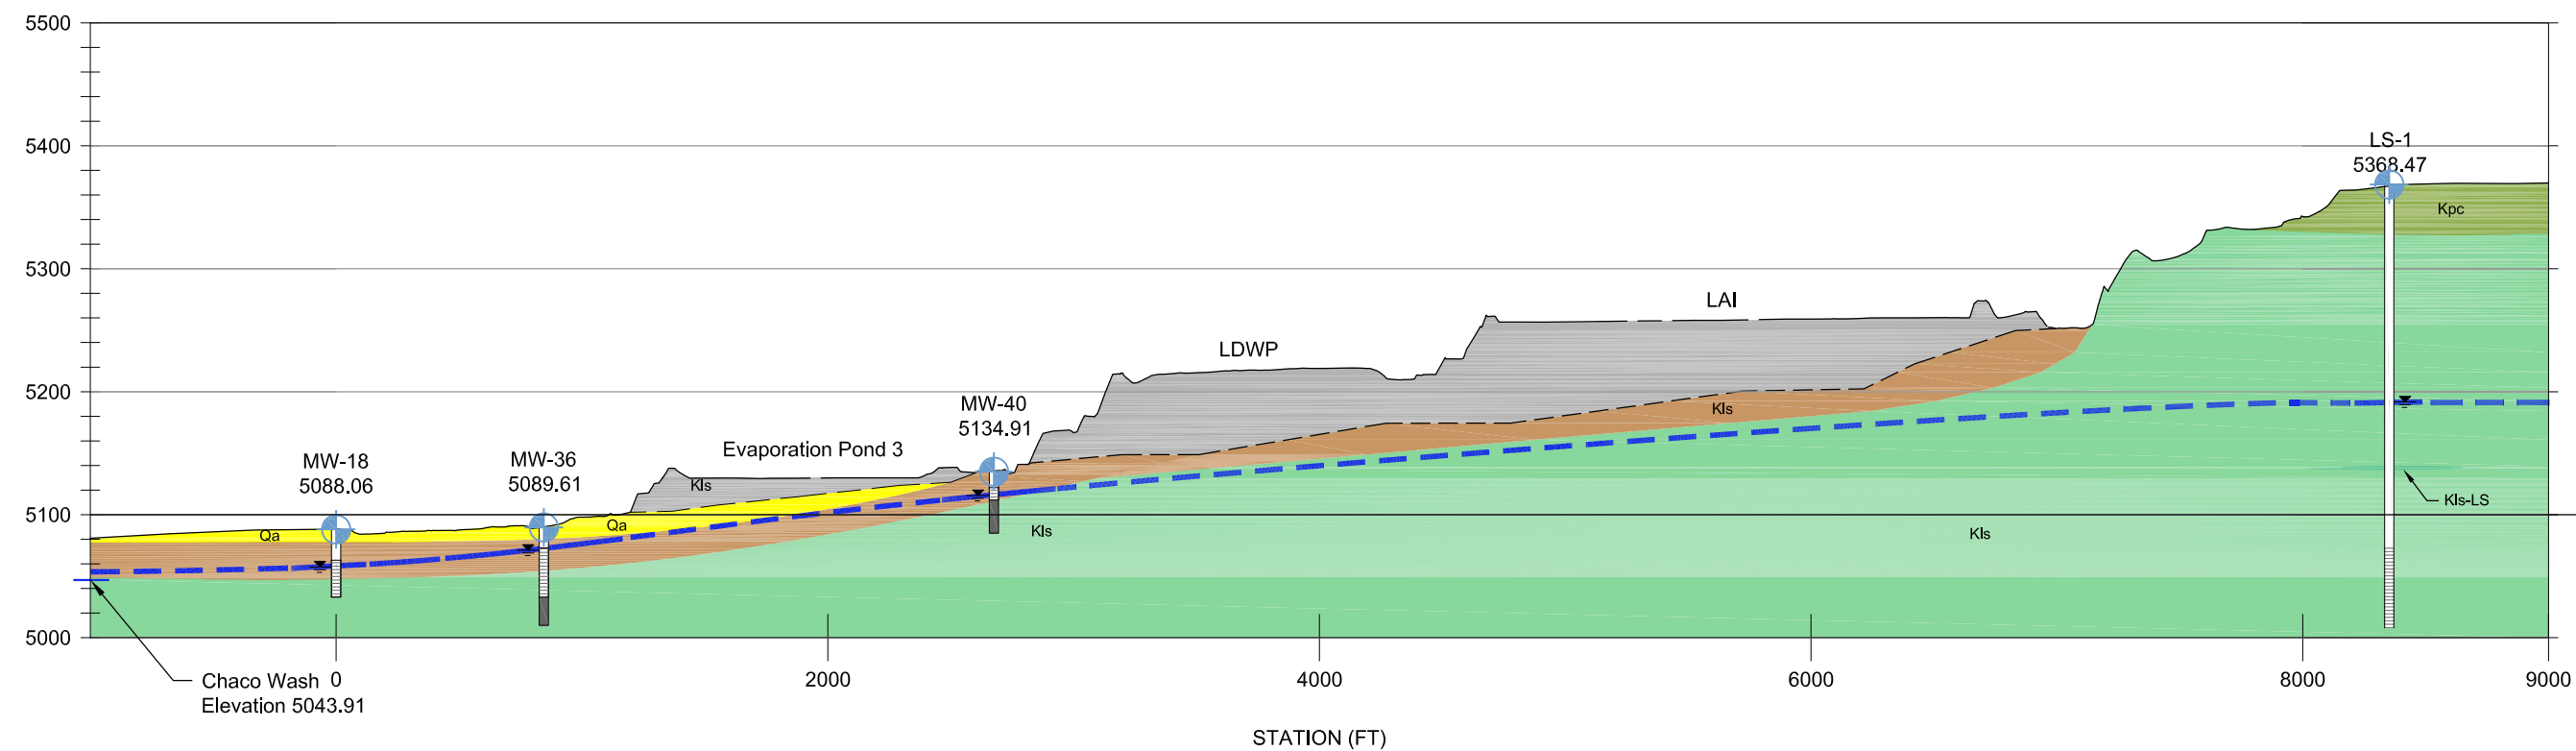

## LEGEND

- Monitoring Well
- Soil Boring
- Well and Screen
- Boring
- MW-31  
5088.47
- Name  
Surface Elevation
- March 2012 Groundwater elevation  
(Solid where known, dashed where inferred)
- 2010 Surface Topography  
(Dashed where inferred)
- Ash
- Qa  
Alluvium
- Kpc  
Pictured Cliffs Sandstone
- Kls  
Weathered Lewis Shale
- Kls  
Unweathered Lewis Shale
- Kls-LS  
Limestone

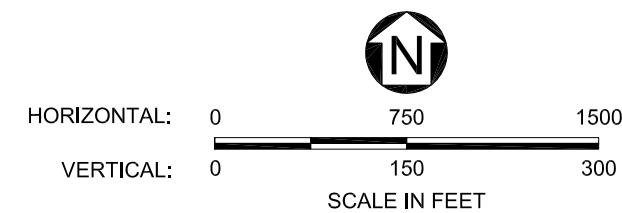

REFERENCE: AERIAL: PROVIDED BY APS (AERIAL MAPPING COMPANY) FLIGHT DATE MAY 7TH, 2010, DATUM: NEW MEXICO STATE PLANE, TRANSVERSE MERCATOR-WEST ZONE, US SURVEY FOOT, N.A.D. 1983, N.A.V.D. 88. TOPOGRAPHY: FLOWN BY "AERO-GRAPHICS, INC." ON NOVEMBER 22, 2006, 40 WEST OAKLAND AVENUE, SALT LAKE CITY, UTAH 84115, DATUM: NEW MEXICO STATE PLANE, NAD83/NAVD88, WEST ZONE, US SURVEY FOOT USGS TOPOGRAPHIC QUAD: FRUITLAND, THE HOGBACK NORTH, NM, 1979. WELL AND CHACO WASH SURVEY, N.A.D.1983, N.A.V.D. 88 BY SOUDER MILLER JULY 2012




DATUM:	CONTROL POINT	NORTHING	EASTING	ELEVATION
	EMMA	N2,066,529.495	E2,528,708.477	5382.251'
	HV53	N2,070,581.505	E2,529,275.542	5331.214'
	HV61	N2,070,581.682	E2,520,166.590	5085.898'

P:\WRES\Arizona\_Public\_Service\23446329\_APS\_FCPP\_Wells\_&\_Geology\5\_0\_Technical\5\_6\_CADD\Figures\ A18646.dwg - Feb 08,2013

Geologic Cross Section G-G'  
Arizona Public Service  
Four Corners Power Plant


Figure 8

# SECTION H-H'

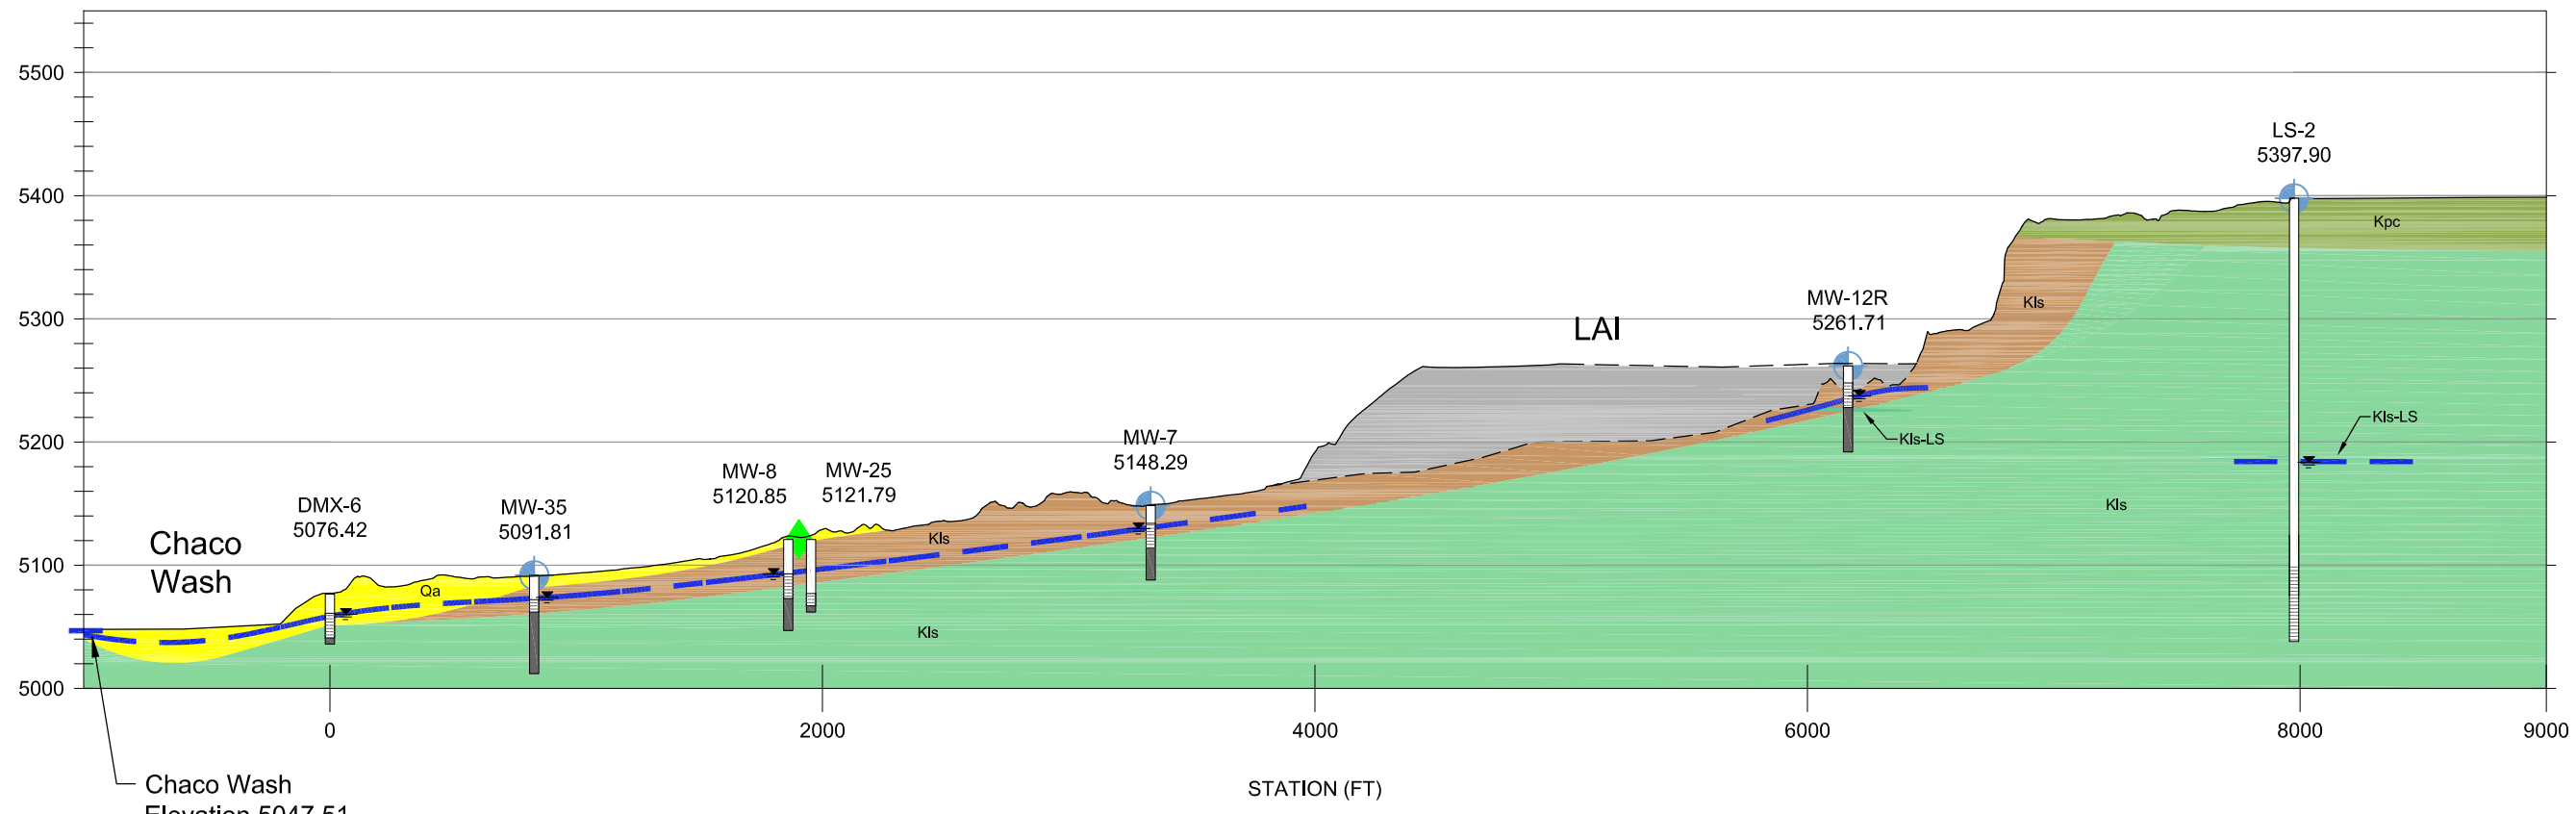

## LEGEND

- Monitoring Well
- Paired Monitoring Well
- Well and Screen
- Boring
- MW-31  
5088.47
- Name  
Surface Elevation
- March 2012 Groundwater elevation  
(Solid where known, dashed where inferred)
- 2010 Surface Topography  
(Dashed where inferred)
- Ash
- Qa  
Alluvium
- Kpc  
Pictured Cliffs Sandstone
- Kls  
Weathered Lewis Shale
- Kls  
Unweathered Lewis Shale
- Kls-LS  
Limestone

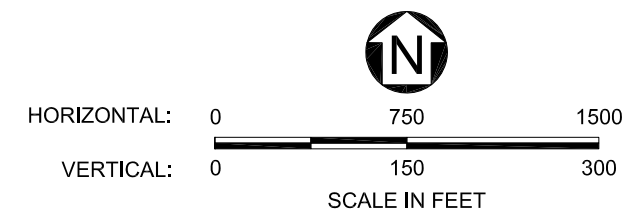

REFERENCE: AERIAL: PROVIDED BY APS (AERIAL MAPPING COMPANY) FLIGHT DATE MAY 7TH, 2010, DATUM: NEW MEXICO STATE PLANE, TRANSVERSE MERCATOR-WEST ZONE, US SURVEY FOOT, N.A.D. 1983, N.A.V.D. 88. TOPOGRAPHY: FLOWN BY "AERO-GRAPHICS, INC." ON NOVEMBER 22, 2006, 40 WEST OAKLAND AVENUE, SALT LAKE CITY, UTAH 84115, DATUM: NEW MEXICO STATE PLANE, NAD83/NAVD88, WEST ZONE, US SURVEY FOOT USGS TOPOGRAPHIC QUAD: FRUITLAND, THE HOGBACK NORTH, NM, 1979. WELL AND CHACO WASH SURVEY, N.A.D.1983, N.A.V.D. 88 BY SOUDER MILLER JULY 2012

DATUM:	CONTROL POINT	NORTHING	EASTING	ELEVATION
	EMMA	N2,066,529.495	E2,528,708.477	5382.251'
	HV53	N2,070,581.505	E2,529,275.542	5331.214'
	HV61	N2,070,581.682	E2,520,166.590	5085.898'


P:\WRES\Arizona\_Public\_Service\23446329\_APS\_FCPP\_Wells\_&\_Geology\5\_0\_Technical\5\_6\_CADD\Figures\ A18647.dwg - Feb 08,2013

Geologic Cross Section H-H'  
Arizona Public Service  
Four Corners Power Plant

Figure 9



SECTION I-I'

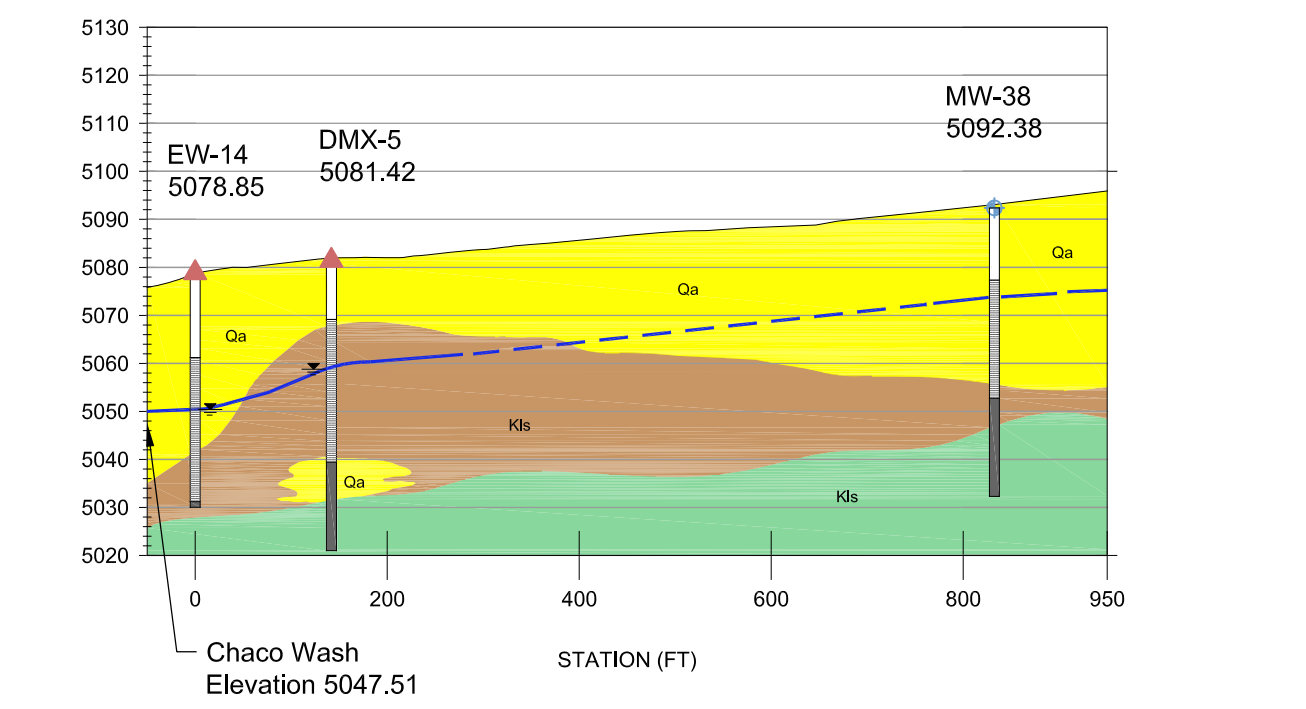

LEGEND

Monitoring Well

Extraction Well

Well and Screen

Boring

March 2012 Groundwater elevation  
(Solid where known, dashed where inferred)

2010 Surface Topography  
(Dashed where inferred)

Alluvium

Pictured Cliffs Sandstone

Weathered Lewis Shale

Unweathered Lewis Shale

Limestone

MW-31  
5088.47

Name  
Surface Elevation

HORIZONTAL: 0 200 400

VERTICAL: 0 40 80

SCALE IN FEET


REFERENCE: AERIAL: PROVIDED BY APS (AERIAL MAPPING COMPANY) FLIGHT DATE MAY 7TH, 2010, DATUM: NEW MEXICO STATE PLANE, TRANSVERSE MERCATOR-WEST ZONE, US SURVEY FOOT, N.A.D. 1983, N.A.V.D. 88. TOPOGRAPHY: FLOWN BY "AERO-GRAPHICS, INC." ON NOVEMBER 22, 2006, 40 WEST OAKLAND AVENUE, SALT LAKE CITY, UTAH 84115, DATUM: NEW MEXICO STATE PLANE, NAD27/NGVD29, WEST ZONE, US SURVEY FOOT USGS TOPOGRAPHIC QUAD: FRUITLAND, THE HOGBACK NORTH, NM, 1979. WELL AND CHACO WASH SURVEY, N.A.D.1983, N.A.V.D. 88 BY SOUDER MILLER JULY 2012

URS	DATUM:	CONTROL POINT	NORTHING	EASTING	ELEVATION
		EMMA	N2,066,529.495	E2,528,708.477	5382.251'
		HV53	N2,070,581.505	E2,529,275.542	5331.214'
		HV61	N2,070,581.682	E2,520,166.590	5085.898'
P:\WRES\Arizona_Public_Service\23446329_APS_FCPP_Wells_&_Geology\5_0_Technical\5_6_CADD\Figures\ A18656.dwg - Feb 08,2013					



GEOLOGIC CROSS SECTION I-I'  
Arizona Public Service  
Four Corners Power Plant

Figure 10

SECTION J-J'

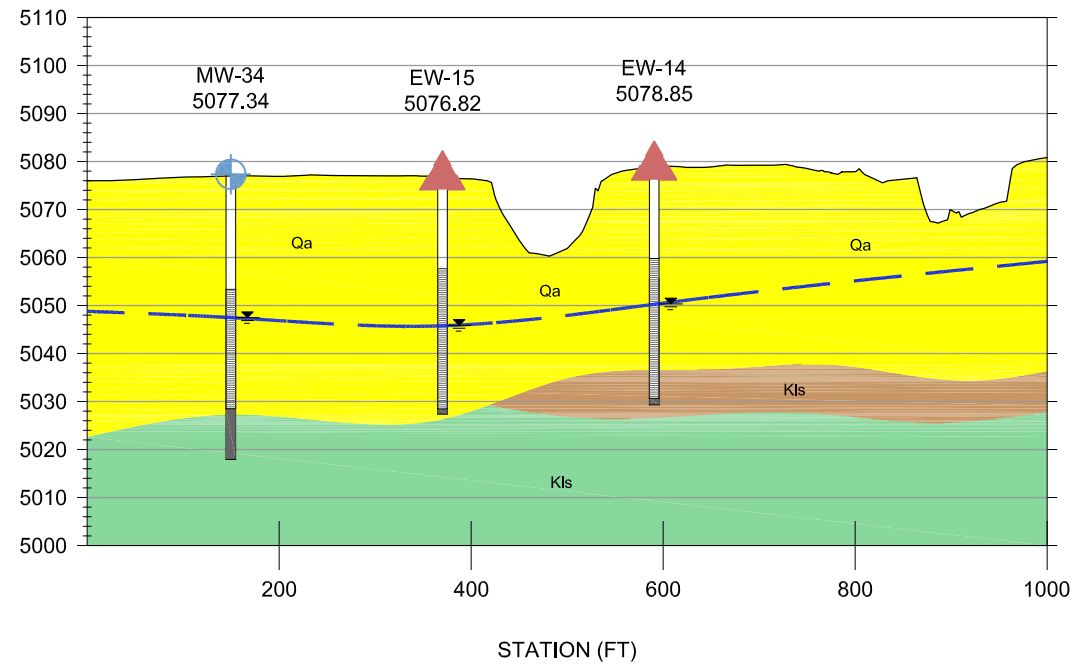

LEGEND

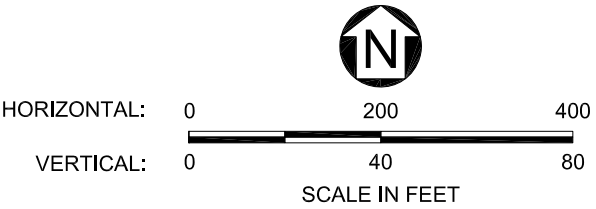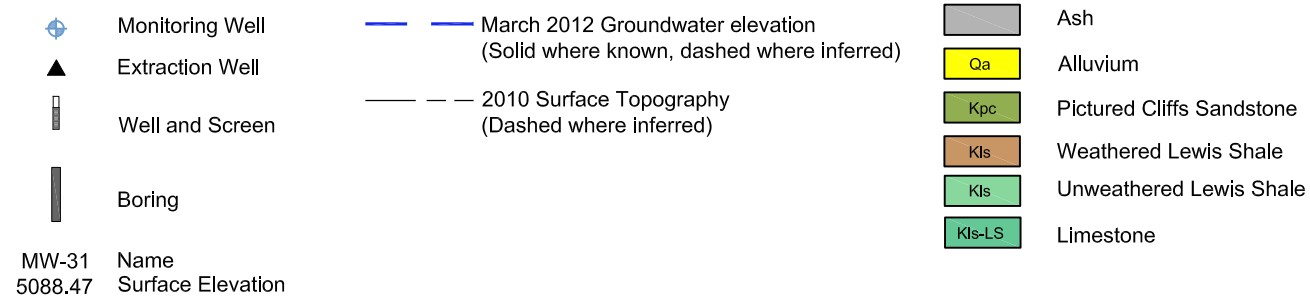

REFERENCE: AERIAL: PROVIDED BY APS (AERIAL MAPPING COMPANY) FLIGHT DATE MAY 7TH, 2010, DATUM: NEW MEXICO STATE PLANE, TRANSVERSE MERCATOR-WEST ZONE, US SURVEY FOOT, N.A.D. 1983, N.A.V.D. 88. TOPOGRAPHY: FLOWN BY "AERO-GRAPHICS, INC." ON NOVEMBER 22, 2006, 40 WEST OAKLAND AVENUE, SALT LAKE CITY, UTAH 84115, DATUM: NEW MEXICO STATE PLANE, NAD83/NAVD88, WEST ZONE, US SURVEY FOOT USGS TOPOGRAPHIC QUAD: FRUITLAND, THE HOGBACK NORTH, NM, 1979. WELL AND CHACO WASH SURVEY, N.A.D.1983, N.A.V.D. 88 BY SOUDER MILLER JULY 2012


URS	DATUM:	CONTROL POINT	NORTHING	EASTING	ELEVATION
		EMMA	N2,066,529.495	E2,528,708.477	5382.251'
		HV53	N2,070,581.505	E2,529,275.542	5331.214'
		HV61	N2,070,581.682	E2,520,166.590	5085.898'

P:\WRES\Arizona\_Public\_Service\23446329\_APS\_FCPP\_Wells\_&\_Geology\5\_0\_Technical\5\_6\_CADD\Figures\ A18677.dwg - Feb 08,2013

Geologic Cross Section J-J'  
Arizona Public Service  
Four Corners Power Plant

Figure 11



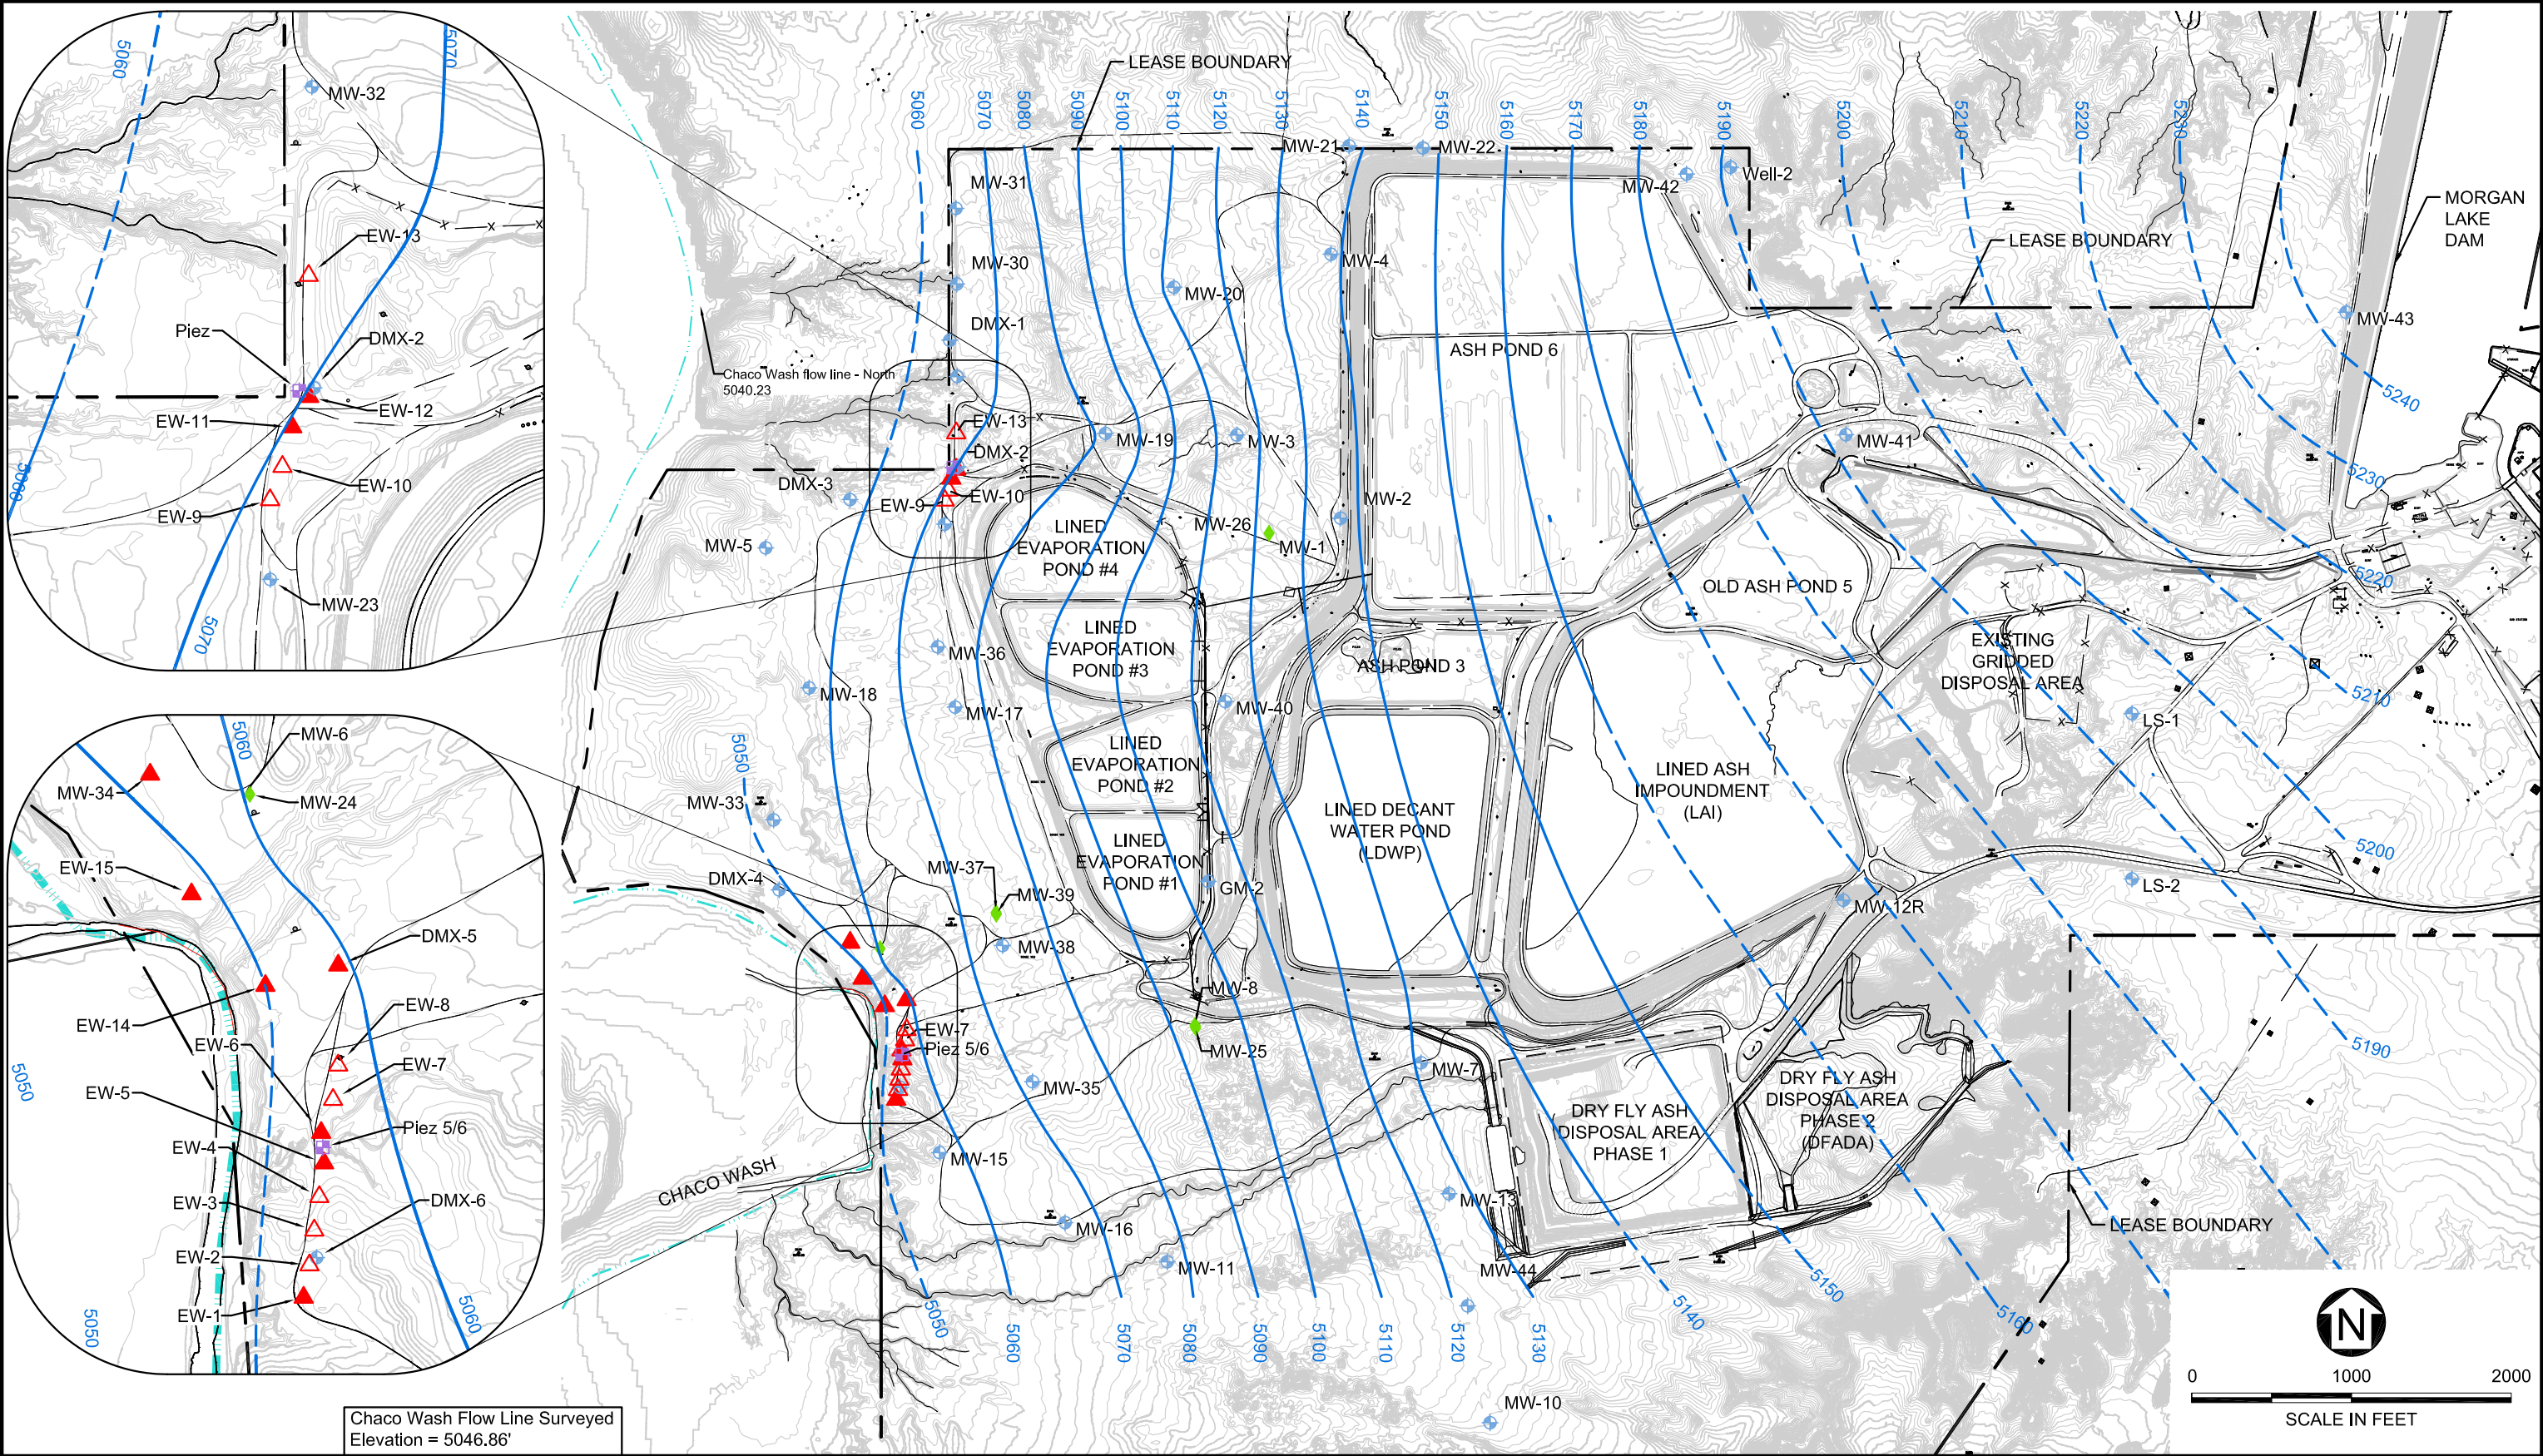

REFERENCE: AERIAL: PROVIDED BY APS (AERIAL MAPPING COMPANY) FLIGHT DATE MAY 7TH, 2010, DATUM: NEW MEXICO STATE PLANE, TRANSVERSE MERCATOR-WEST ZONE, US SURVEY FOOT, N.A.D. 1983, N.A.V.D. 88. TOPOGRAPHY: FLOWN BY "AERO-GRAPHICS, INC." ON NOVEMBER 22, 2006, 40 WEST OAKLAND AVENUE, SALT LAKE CITY, UTAH 84115, DATUM: NEW MEXICO STATE PLANE, NAD27/NGVD29, WEST ZONE, US SURVEY FOOT USGS TOPOGRAPHIC QUAD: FRUITLAND, THE HOGBACK NORTH, NM, 1979, WELL AND CHACO WASH SURVEY, N.A.D.1983, N.A.V.D. 88 BY SOUDER MILLER JULY 2012

DATUM:	CONTROL POINT	NORTHING	EASTING	ELEVATION
	EMMA	N2,066,529.495	E2,528,708.477	5382.251'
	HV53	N2,070,581.505	E2,529,275.542	5331.214'
	HV61	N2,070,581.682	E2,520,166.590	5085.898'

LEGEND

- Monitoring Well
- Piezometer
- Paired Monitoring Wells
- Extraction Well
- Offline Extraction Well
- Chaco Wash

GWE

DTW

NC


Groundwater Elevation  
Depth To Water  
(in feet below top of casing)  
Wells Not Used For Contouring  
Groundwater Contour  
Dashed where inferred  
(Data collected on 02/22/12)  
(MW-12R, MW-40 through MW-44 Data Collected 03/29/12)

March 2012 Groundwater Elevation Contour Map  
Arizona Public Service  
Four Corners Power Plant

Figure 12






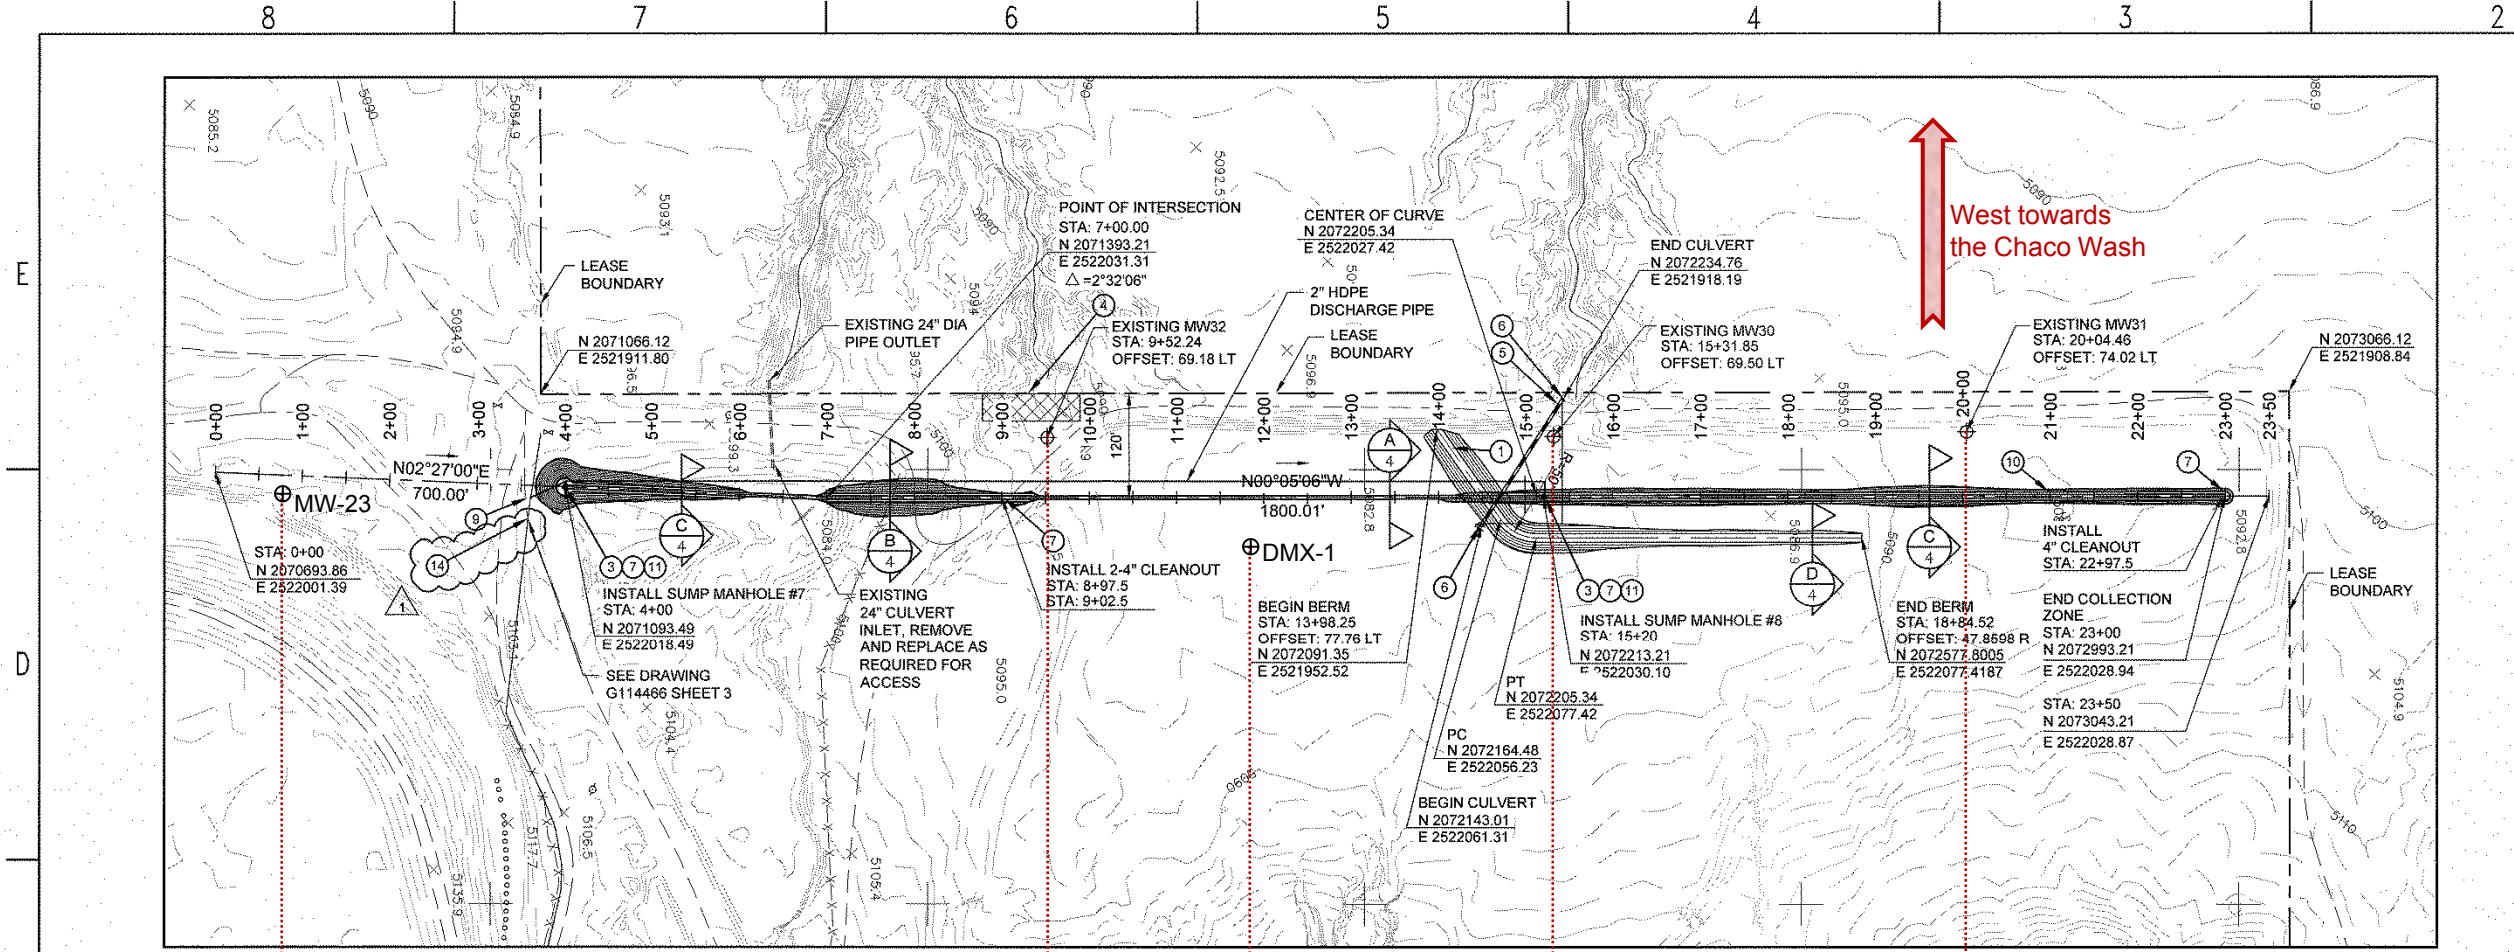

PLAN

0 100 200  
SCALE IN FEET

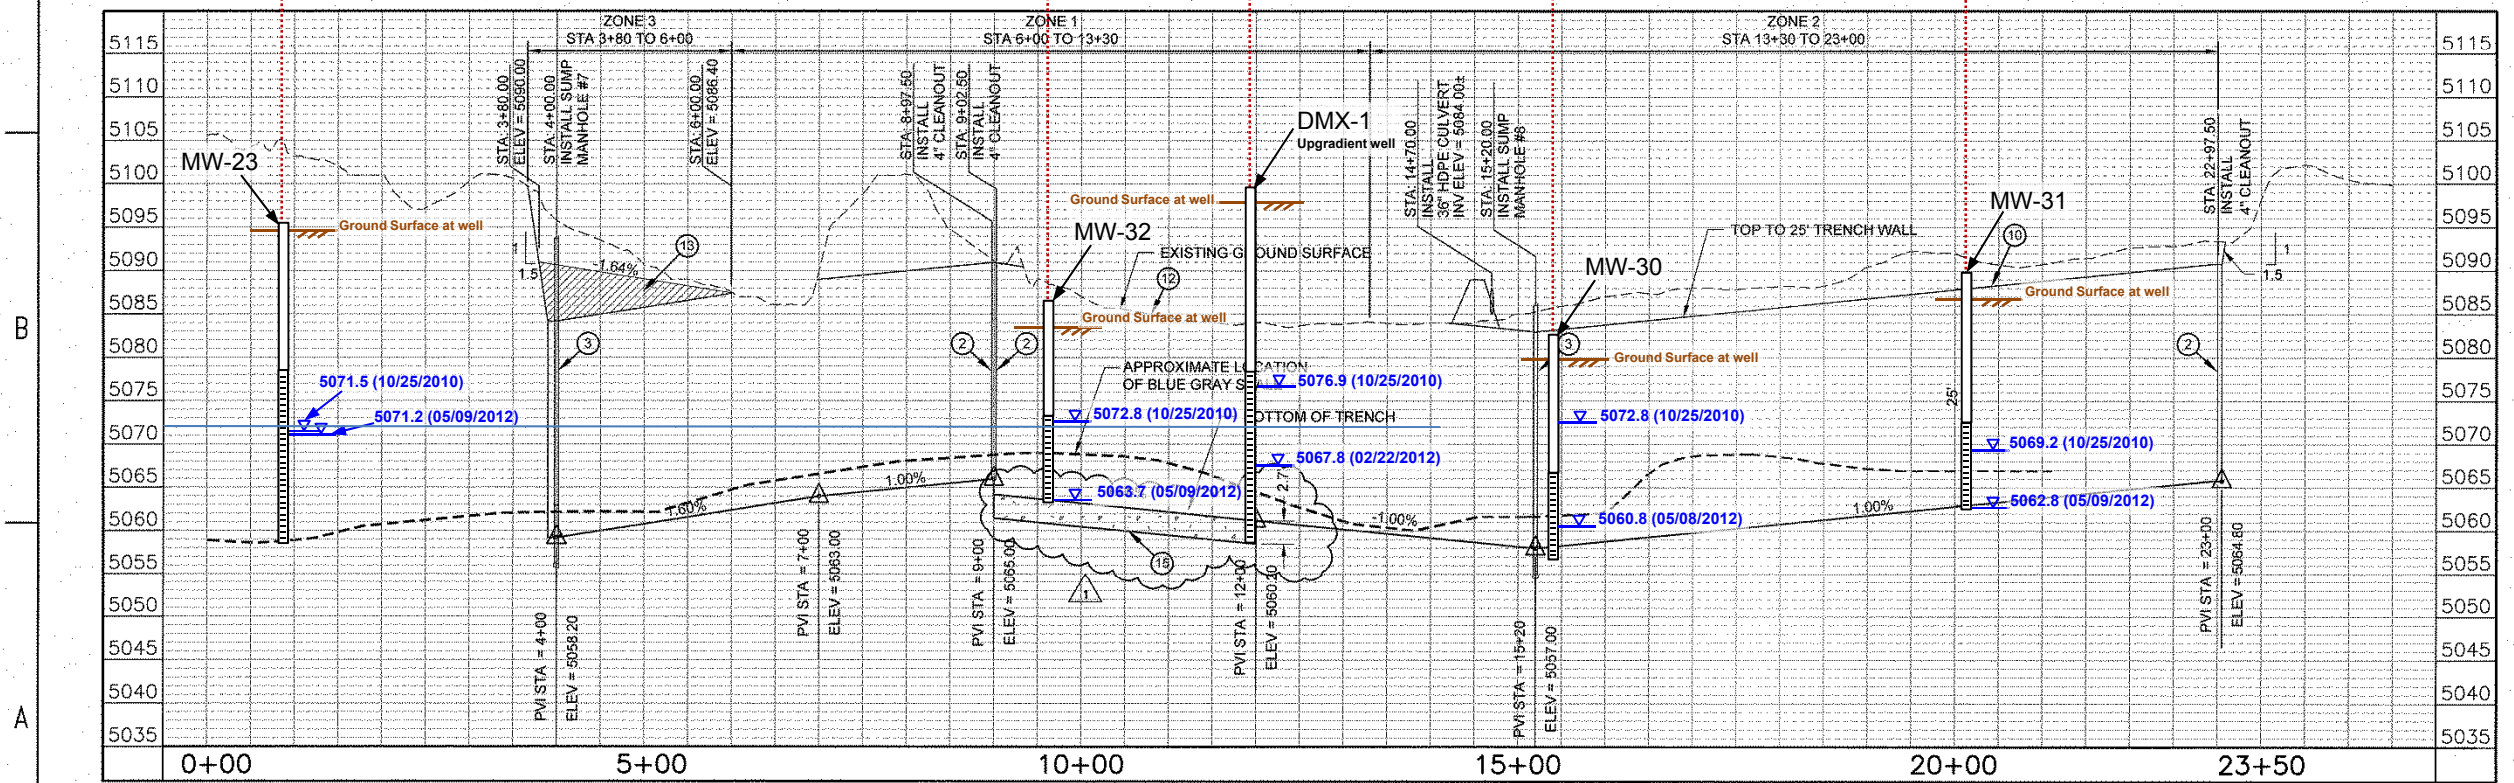

SEEPAGE TRENCH  
PROFILE

HORIZONTAL 0 100 200  
SCALE IN FEET

VERTICAL 0 10 20  
SCALE IN FEET

**URS**  
7720 N. 19th Street Suite 100  
Phoenix, Arizona 85020  
(602) 371-1100

KEY NOTES:

- 1 TO DEFLECT SURFACE STORMWATER FLOW, CONSTRUCT BERM TO ELEVATION 5088.0 WITH 10' WIDE TOP AND 3:1 SIDE SLOPES. SEE SECTION D, SHEET 4.
- 2 INSTALL CLEANOUT SEE DETAIL 6, SHEET 4.
- 3 INSTALL SUMP MANHOLE SEE DETAIL 1, SHEET 4.
- 4 CONTRACTOR TO PLACE SPOIL MATERIAL INTO AREA SHOWN TO ELEVATION 5088.0.
- 5 INSTALL 36" HDPE CULVERT WITH FLARED END SECTION, 170 LF AT 1% SLOPE. MATCH EXISTING GRADE AT INLET, OUTLET ELEVATION SET BY 1% SLOPE. WHERE TOP OF PIPE IS EXPOSED ADD 1 FOOT MINIMUM COVER WITH 3:1 SIDE SLOPES.
- 6 CULVERT ENTRANCE COVERED WITH STRUCTURAL FILL PENDING STORMWATER ANALYSIS ACCEPTANCE. SEE DETAILS 8, SHEET 4.
- 7 CONSTRUCT A 10' DIA FLAT AREA AROUND 4" CLEANOUT, AND 48" DIA SUMP MANHOLE
- 8 NOT USED
- 9 2" DISCHARGE PIPING TIE-IN AT EXISTING FLOW MEASUREMENT MANHOLE. UPSTREAM INSIDE EXISTING MANHOLE. INSTALL NEW FLOW METER UPSTREAM OF TIE-IN, IN NEW DISCHARGE PIPING.
- 10 RESTORE APPROXIMATE ORIGINAL CONTOUR OF MASS EXCAVATION FOR TRENCH ACCESS WITH 3 FT MINIMUM STRUCTURAL FILL. SEE SECTION C, SHEET 4 (ZONE 2).
- 11 INSTALL 6' HIGH CHAIN LINK FENCE AND GATES; SEE DETAIL 7, SHEET 4.
- 12 RESTORE APPROXIMATE ORIGINAL CONTOUR OF MASS EXCAVATION FOR TRENCH ACCESS WITH 3 FT MINIMUM STRUCTURAL FILL. SEE SECTION A, SHEET 4 (ZONE 1).
- 13 RESTORE FILL TO PROVIDE POSITIVE DRAINAGE, SEE PROFILE FOR ELEVATIONS AND SLOPE.
- 14 NEW 2" DISCHARGE PIPE TIE-IN.
- 15 WEATHERED ZONE REPLACED WITH 120 CY OF CLSM.

**Figure 13**  
Oct. 2010 vs. May 2012  
Water Levels  
North Intercept Trench

1	01/13/12	AS-BUILTS	KLP	AKR	JDM	CDW	FAC90371
2	10-29-10	CONSTRUCTABILITY REVIEW	KLP	AKR	JDM	CDW	FAC90371

NO. DATE REVISION DWN CHD EXD RVWD APVD W.A.

FOUR CORNERS POWER PLANT  
SEEPAGE TRENCH  
PLAN AND PROFILE




SCALE AS NOTED	DATE 10-29-10
DWN KLP	APPROVED DENNIS DEL GROSSO
CHD AKR	ENGINEERING SUPERVISOR
EXD JDM	FAC90371
RVWD CDW	UNIT DISC TYPE SYS NUMBER SHEET
	F123 C 47 AWS 161704 3

THIS DRAWING IS CONFIDENTIAL AND SHALL NOT BE USED OR REPRODUCED IN ANY PART WITHOUT WRITTEN CONSENT OF PINNACLE WEST CAPITAL CORPORATION.

DRAWING: P:\MRES\Arizona\_Public\_Services\23446947\_APS\_FOPP\_Seepage\1\5.0\_Technical\5.6\_CADD\APS\_EDCS\_Drawing\2\_DRAWING\_REVISIONS\F123-C-47-1123-C-47-AWS-161704-3.dwg

Two working days before use, call for the blue stamp.  
**263-1100**  
Blue Stamp Center  
CALL COLLECT



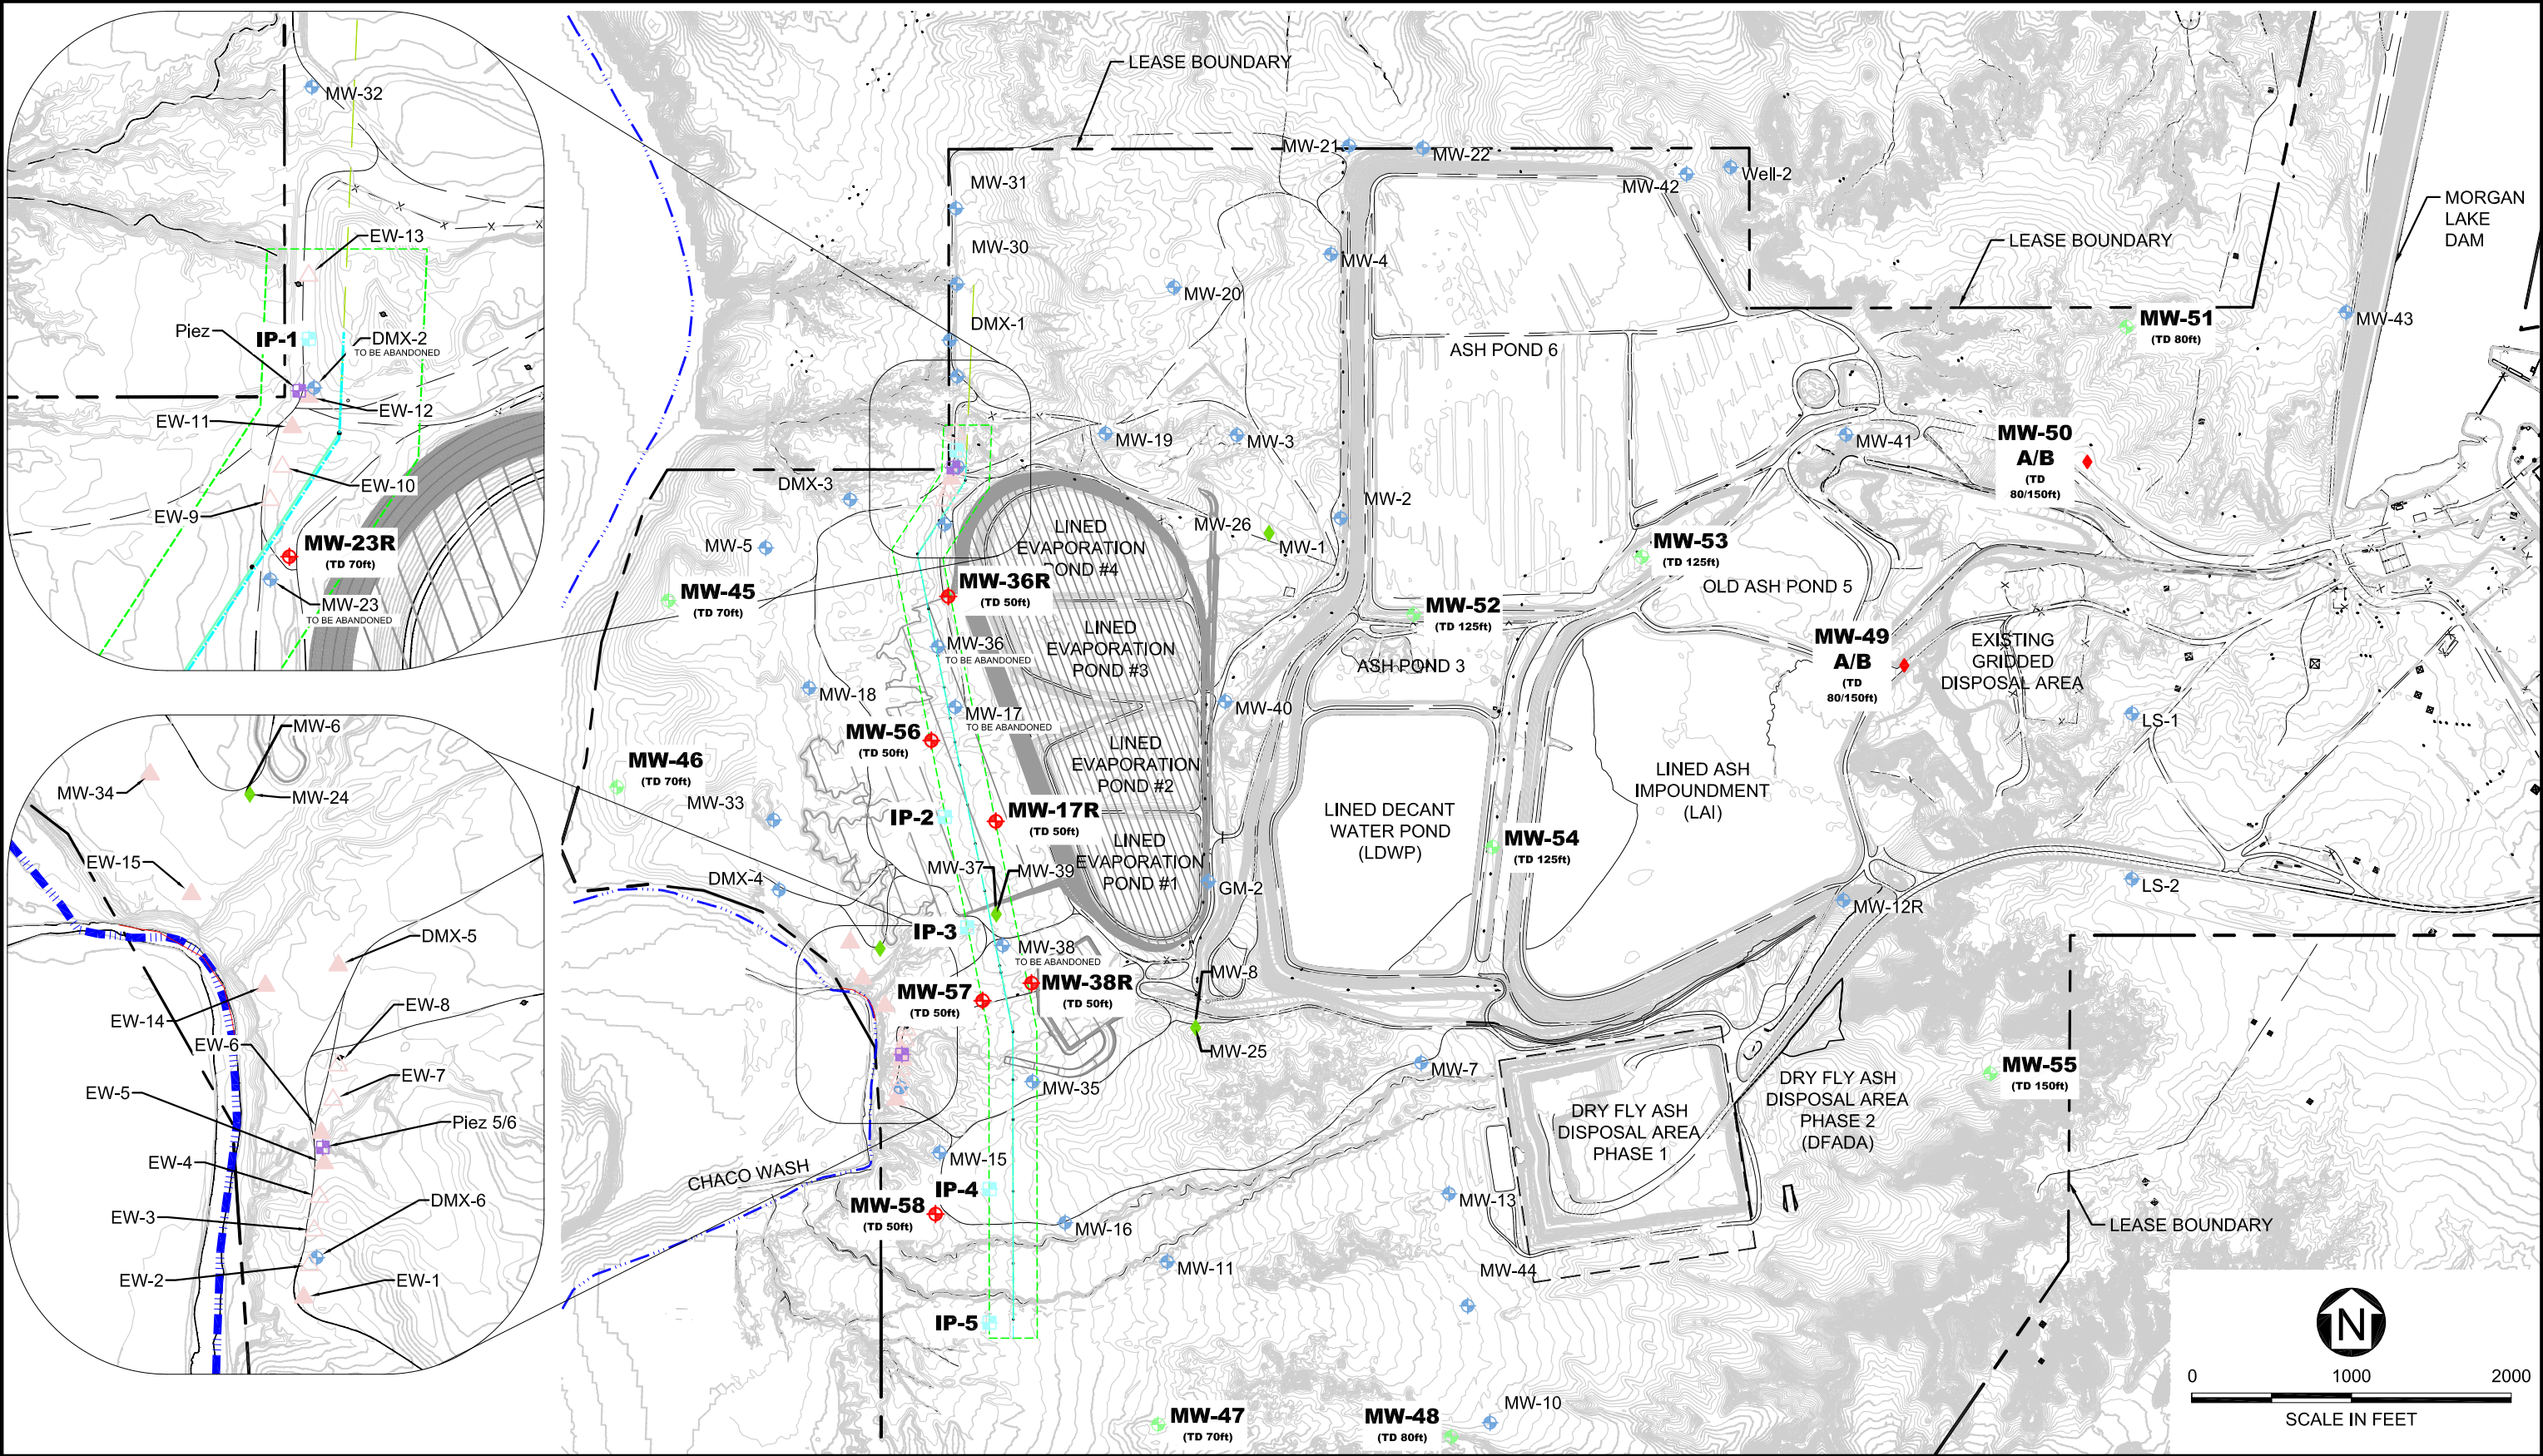

REFERENCE: AERIAL: PROVIDED BY APS (AERIAL MAPPING COMPANY) FLIGHT DATE MAY 7TH, 2010, DATUM: NEW MEXICO STATE PLANE, TRANSVERSE MERCATOR-WEST ZONE, US SURVEY FOOT, N.A.D. 1983, N.A.V.D. 88. TOPOGRAPHY: FLOWN BY "AERO-GRAPHICS, INC." ON NOVEMBER 22, 2006, 40 WEST OAKLAND AVENUE, SALT LAKE CITY, UTAH 84115, DATUM: NEW MEXICO STATE PLANE, NAD27/NGVD29, WEST ZONE, US SURVEY FOOT USGS TOPOGRAPHIC QUAD: FRUITLAND, THE HOGBACK NORTH, NM, 1979. WELL AND CHACO WASH SURVEY, N.A.D.1983, N.A.V.D. 88 BY SOUDER MILLER JULY 2012

DATUM:	CONTROL POINT	NORTHING	EASTING	ELEVATION
	EMMA	N2,066,529.495	E2,528,708.477	5382.251'
	HV53	N2,070,581.505	E2,529,275.542	5331.214'
	HV61	N2,070,581.682	E2,520,166.590	5085.898'

LEGEND

- |                      |                               |                              |
|----------------------|-------------------------------|------------------------------|
| Monitor Well         | Extraction Well               | Proposed Monitor Well        |
| Piezometer           | Offline Extraction Well       | SIT Replacement Monitor Well |
| Paired Monitor Wells | Proposed SIT Piezometer       | Limits of SIT Construction   |
| Chaco Wash           | Proposed Paired Monitor Wells | SIT Alignment                |

Proposed Monitor Well Locations  
Arizona Public Service  
Four Corners Power Plant

Figure 14






**Four Corners Power Plant**  
Geohydrology Data Submittal  
February 13, 2013

Exhibit 1  
Geologic Logs








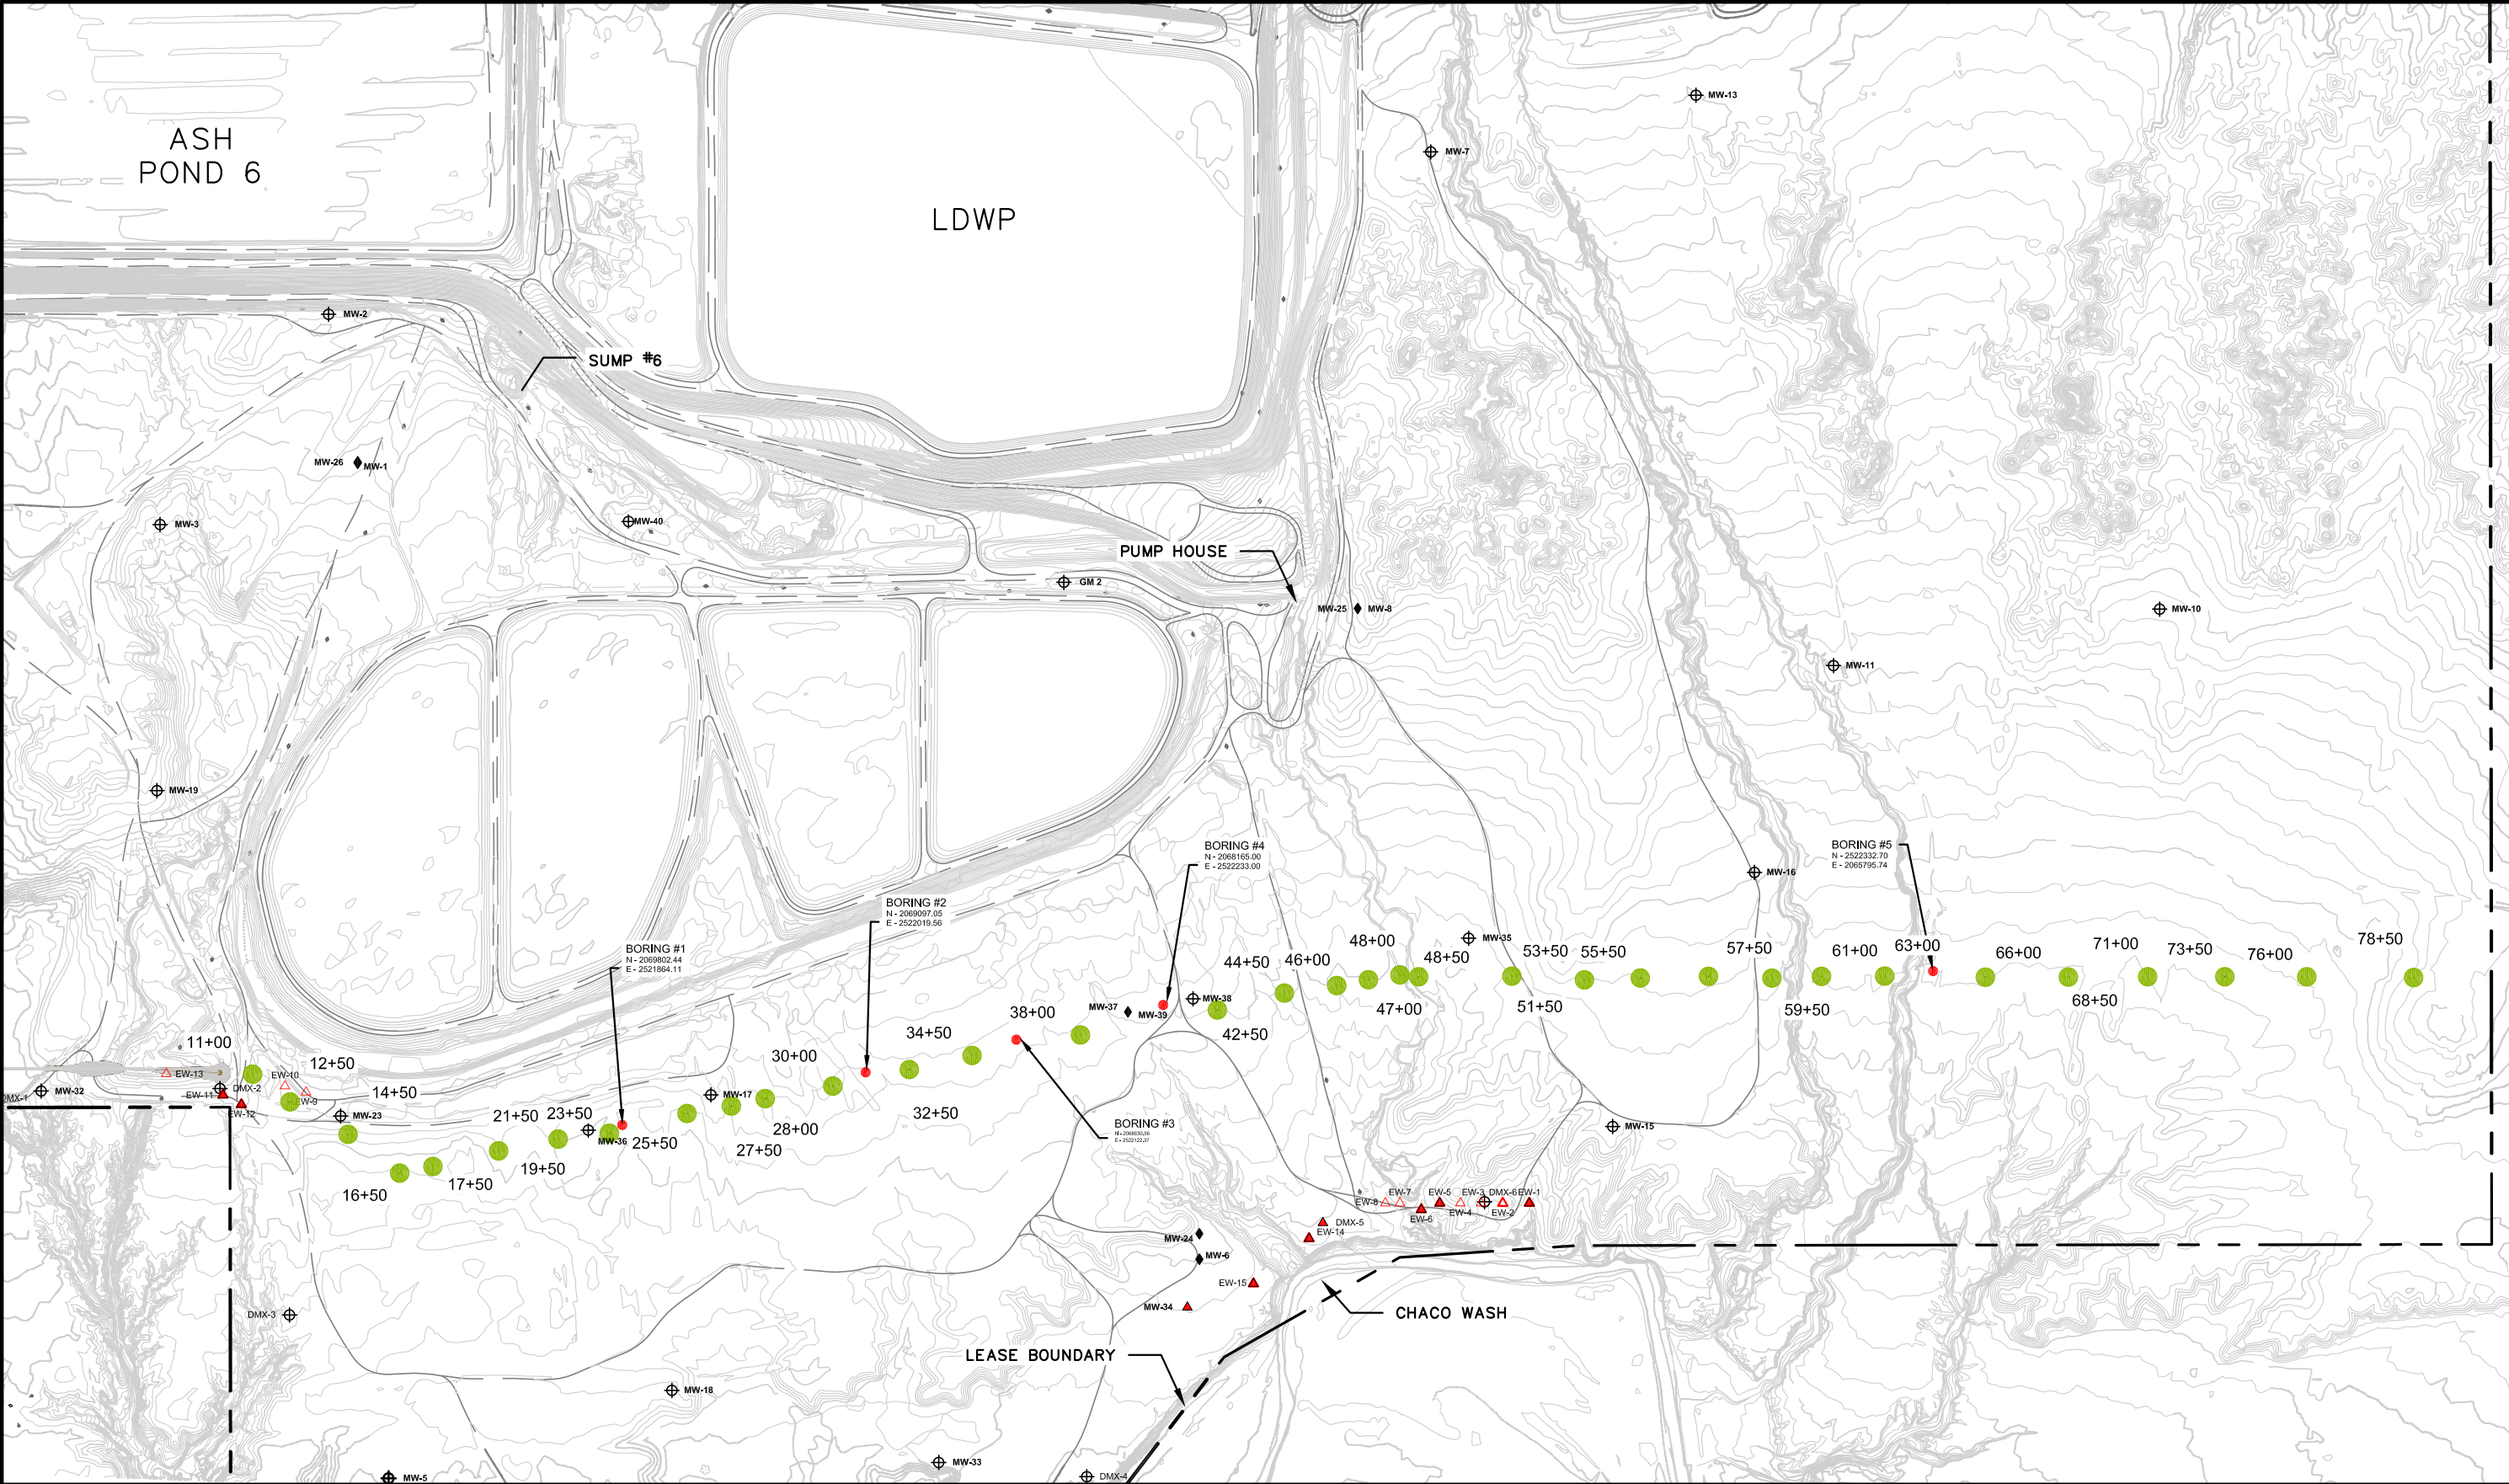

REFERENCE: DATUM: NEW MEXICO STATE PLANE, NAD83,  
WEST ZONE, US SURVEY FOOT.

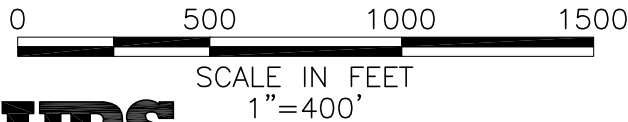

**LEGEND:**

- |   |                              |   |                        |
|---|------------------------------|---|------------------------|
|  MW-16 | <b>Monitoring Well</b>       |  EW-15 | <b>Extraction Well</b> |
|  MW-25 | <b>Monitoring Well</b>       |  EW-8  | <b>Extraction Well</b> |
|        | <b>Boring - October 2012</b> |   |                        |

**NOT FOR CONSTRUCTION  
DRAFT 1-31-13**

**BORING AND TEST PIT LOCATIONS**

South Intercept Trench  
Four Corners Power Plant

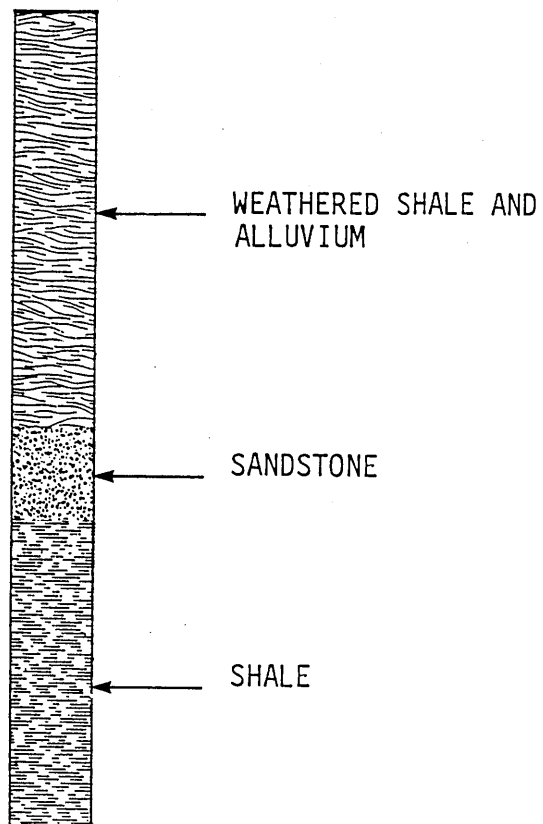


Figure 2

APPENDIX A

MONITOR WELL LITHOLOGIC LOGS

# LITHOLOGIC LOG




KEY TO BORINGS

# LITHOLOGIC LOG

SURFACE ELEVATION 5137.05(e) FT.


MEASURING POINT 5139.10(e) FT.

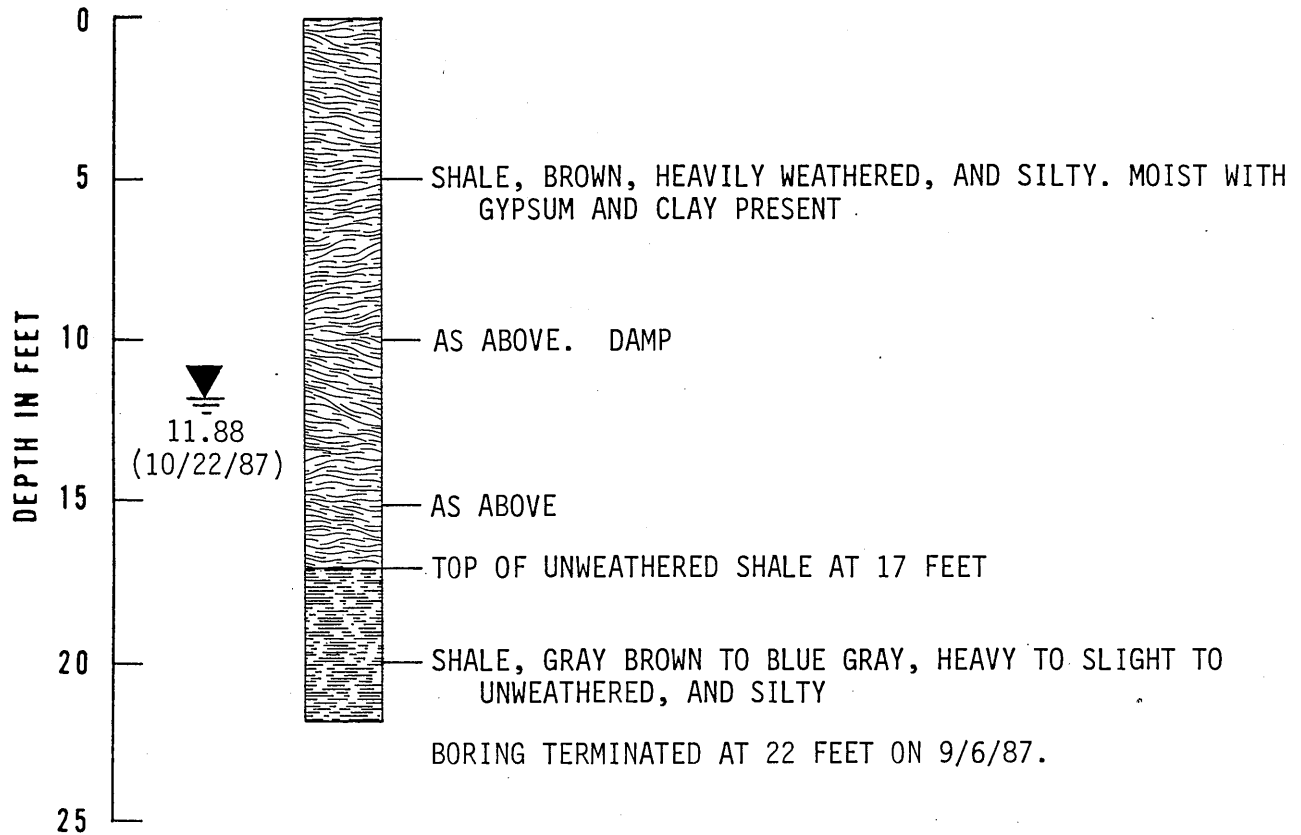

BORING MW-1

# LITHOLOGIC LOG

SURFACE ELEVATION 5147.93 FT.  
MEASURING POINT 5149.43 FT.

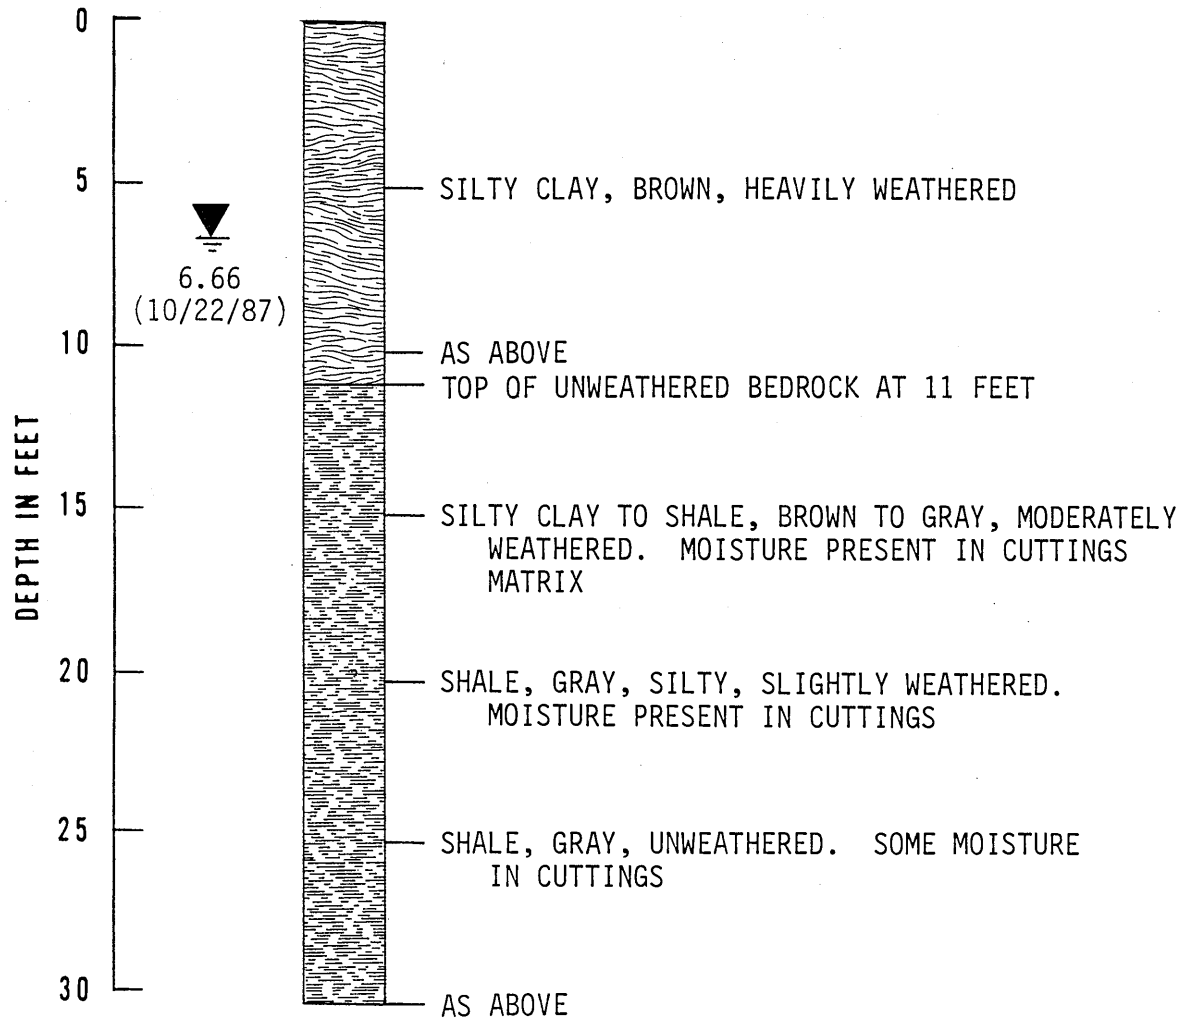


BORING TERMINATED AT 30 FEET ON 3/13/87.

BORING MW-2




LITHOLOGIC LOG

SURFACE ELEVATION 5124.06 FT.  
MEASURING POINT 5125.81 FT.

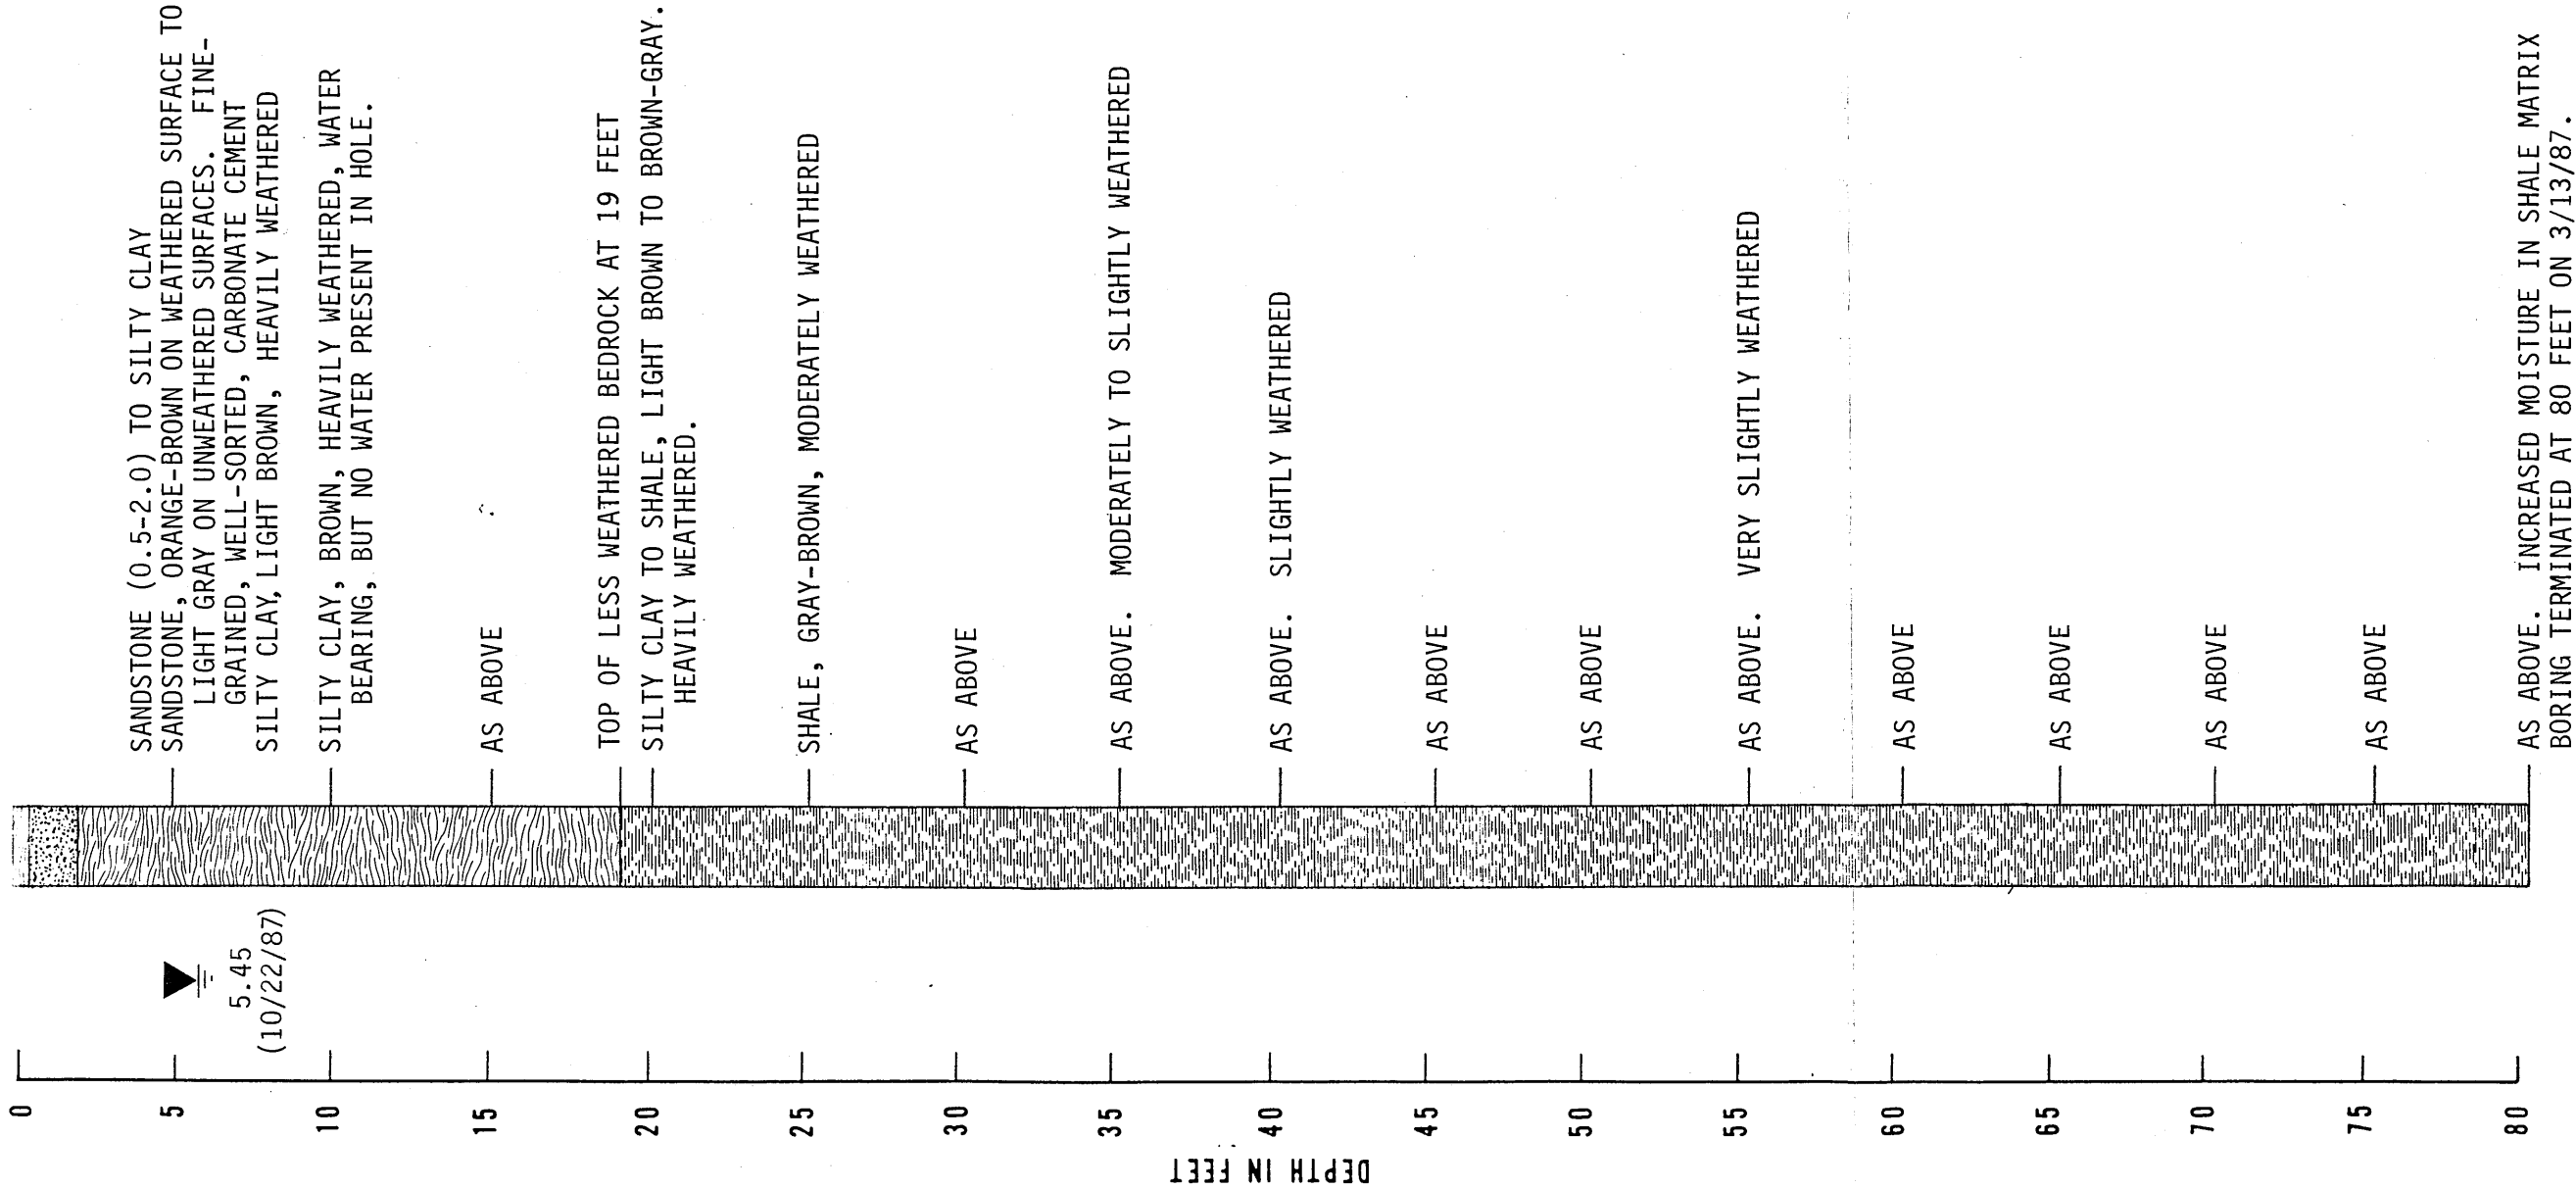

# LITHOLOGIC LOG


SURFACE ELEVATION 5146.38 FT.  
MEASURING POINT 5147.88 FT.

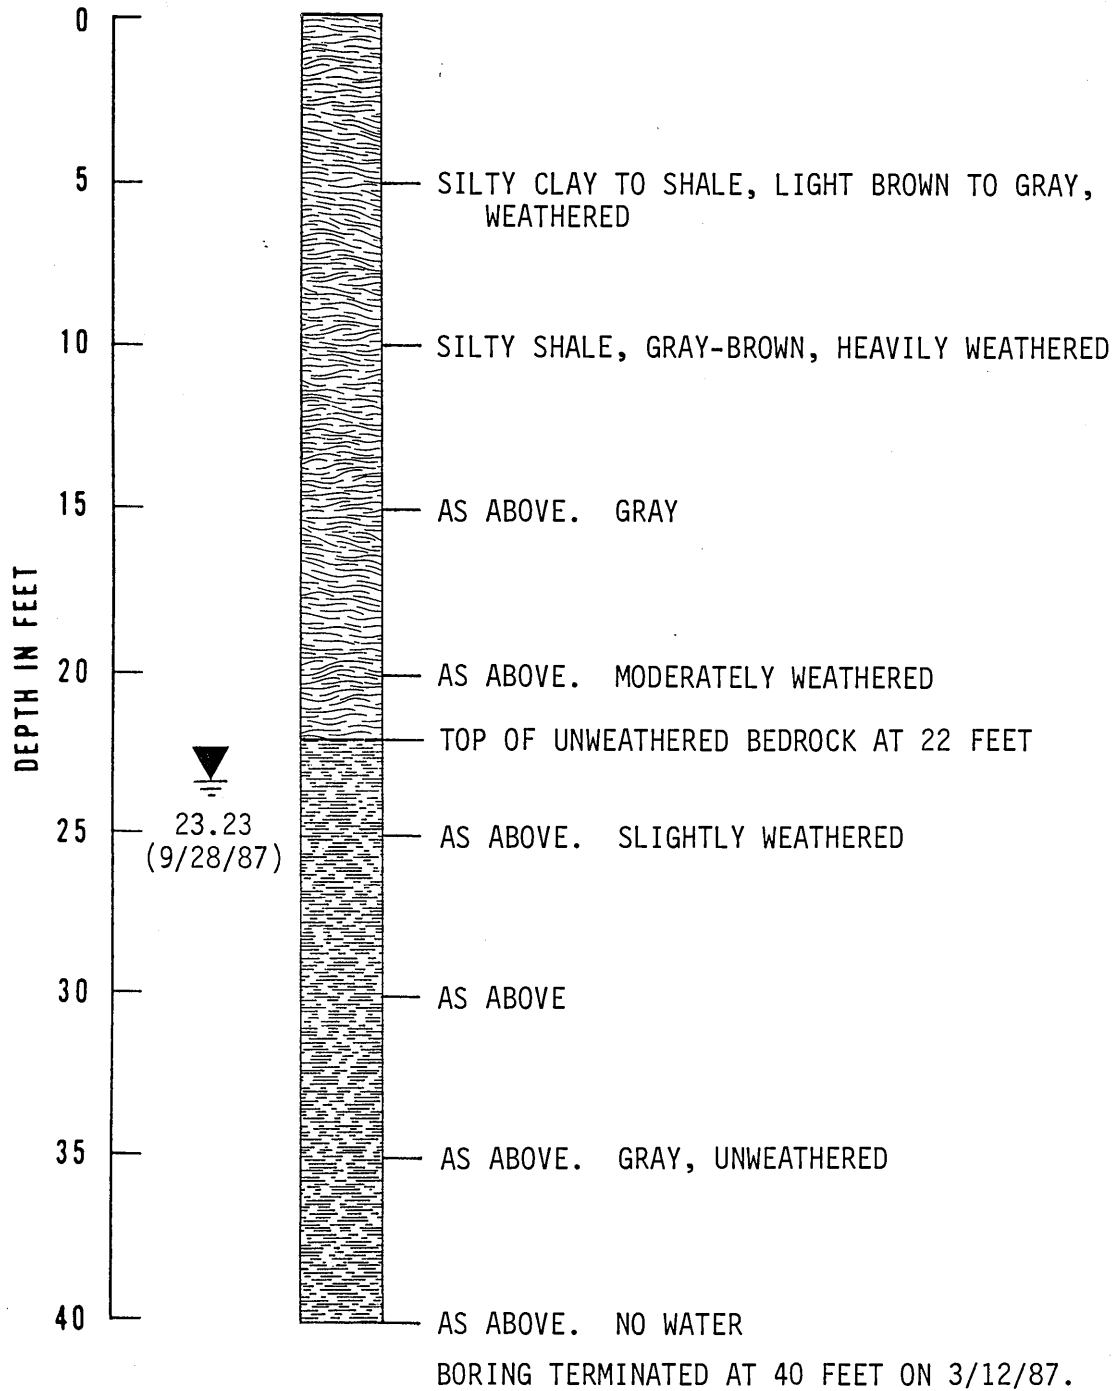

BORING MW-4

LITHOLOGIC LOG


SURFACE ELEVATION 5084.45 FT.  
MEASURING POINT 5086.45 FT.

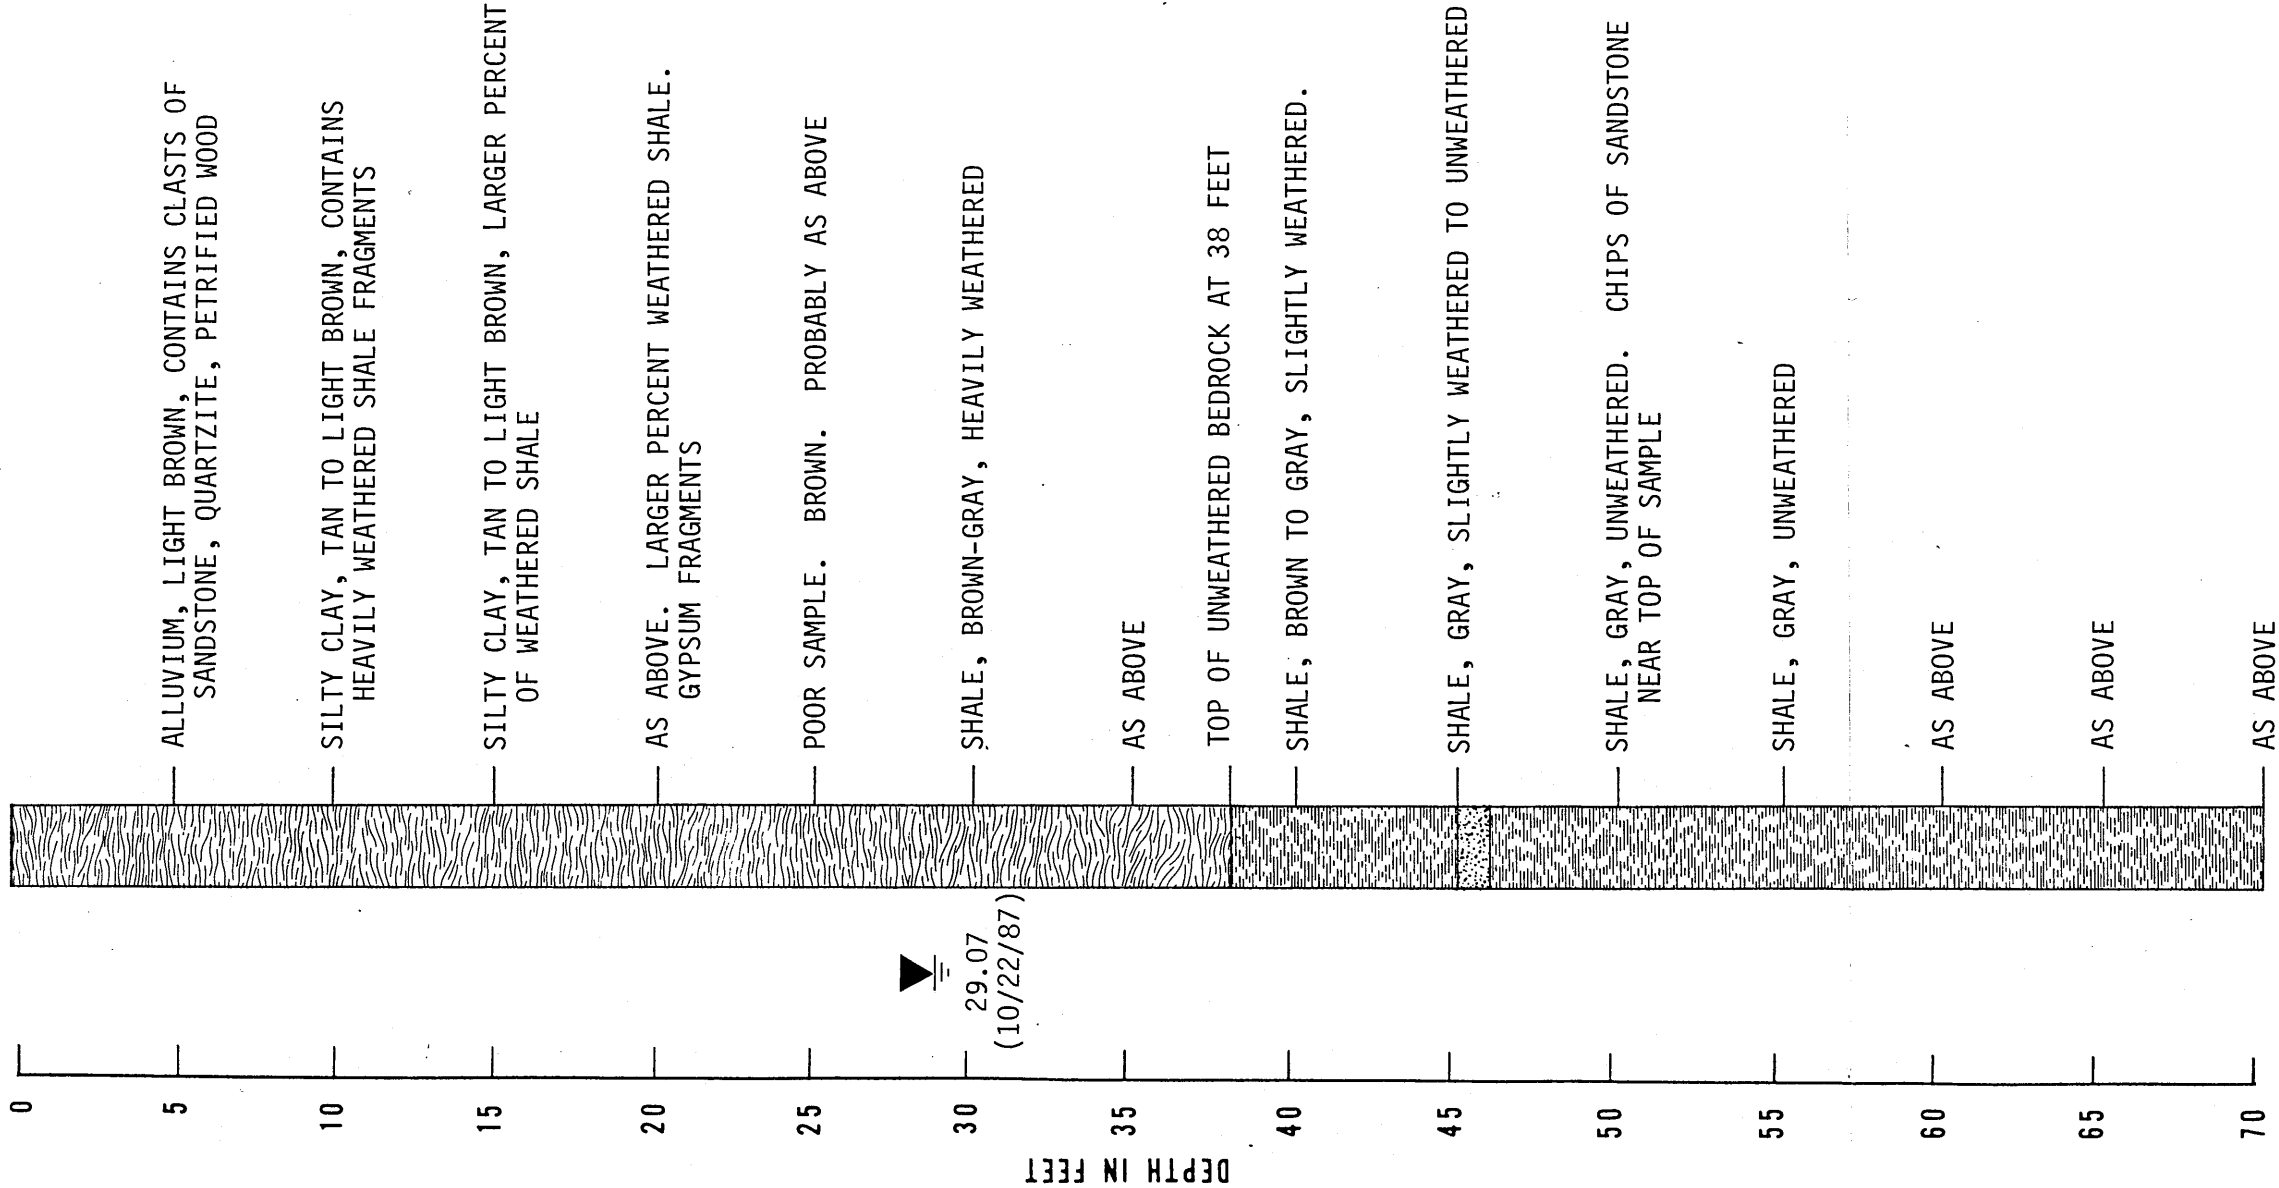

BORING TERMINATED AT 70 FEET ON 3/12/87.  
NOTE: LITHOLOGIC LOG IS BASED ON RESULTS FROM THE 1st HOLE THAT WAS DRILLED. A 2nd HOLE, OFFSET 25 FEET, WAS DRILLED FOR CONSTRUCTING THE MONITOR WELL.


LITHOLOGIC LOG

SURFACE ELEVATION 5078.20 FT.  
MEASURING POINT 5079.70 FT.

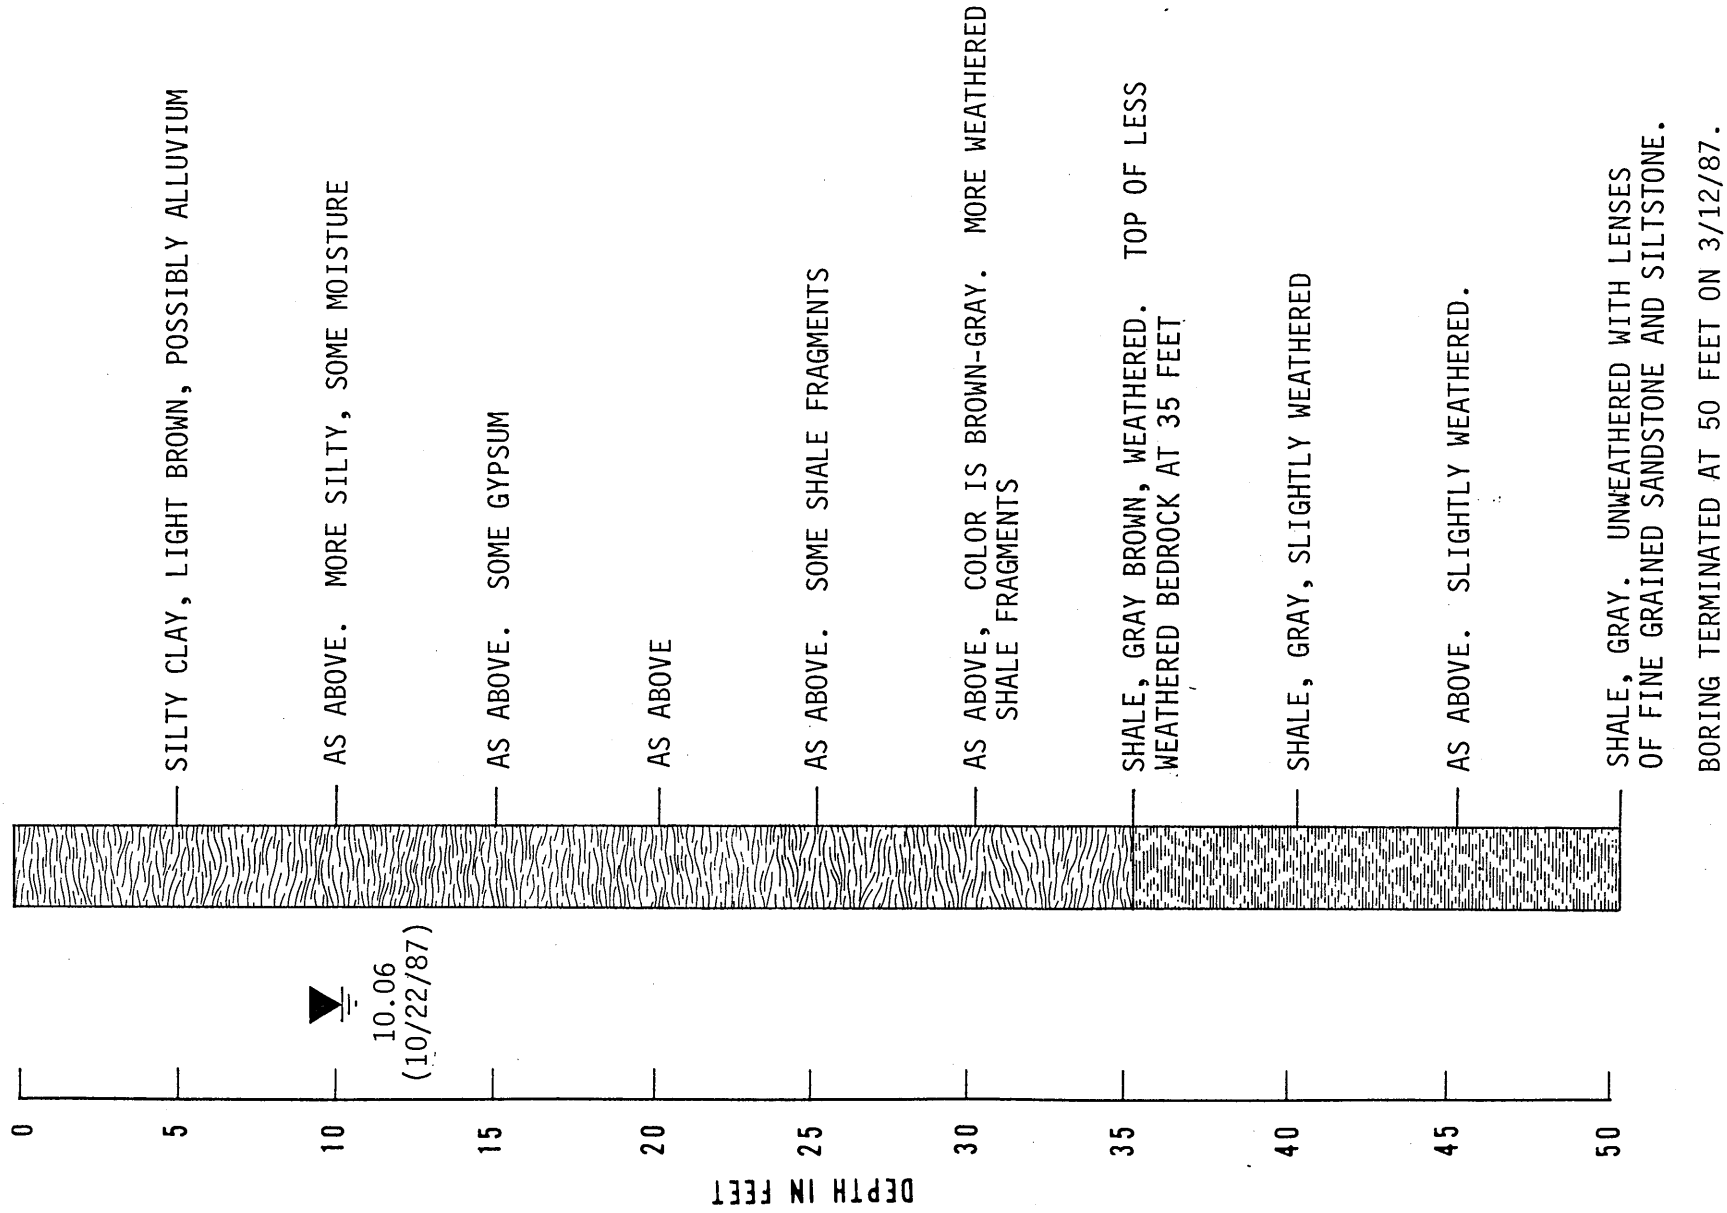

LITHOLOGIC LOG


SURFACE ELEVATION 5146.62 FT.  
MEASURING POINT 5148.52 FT.

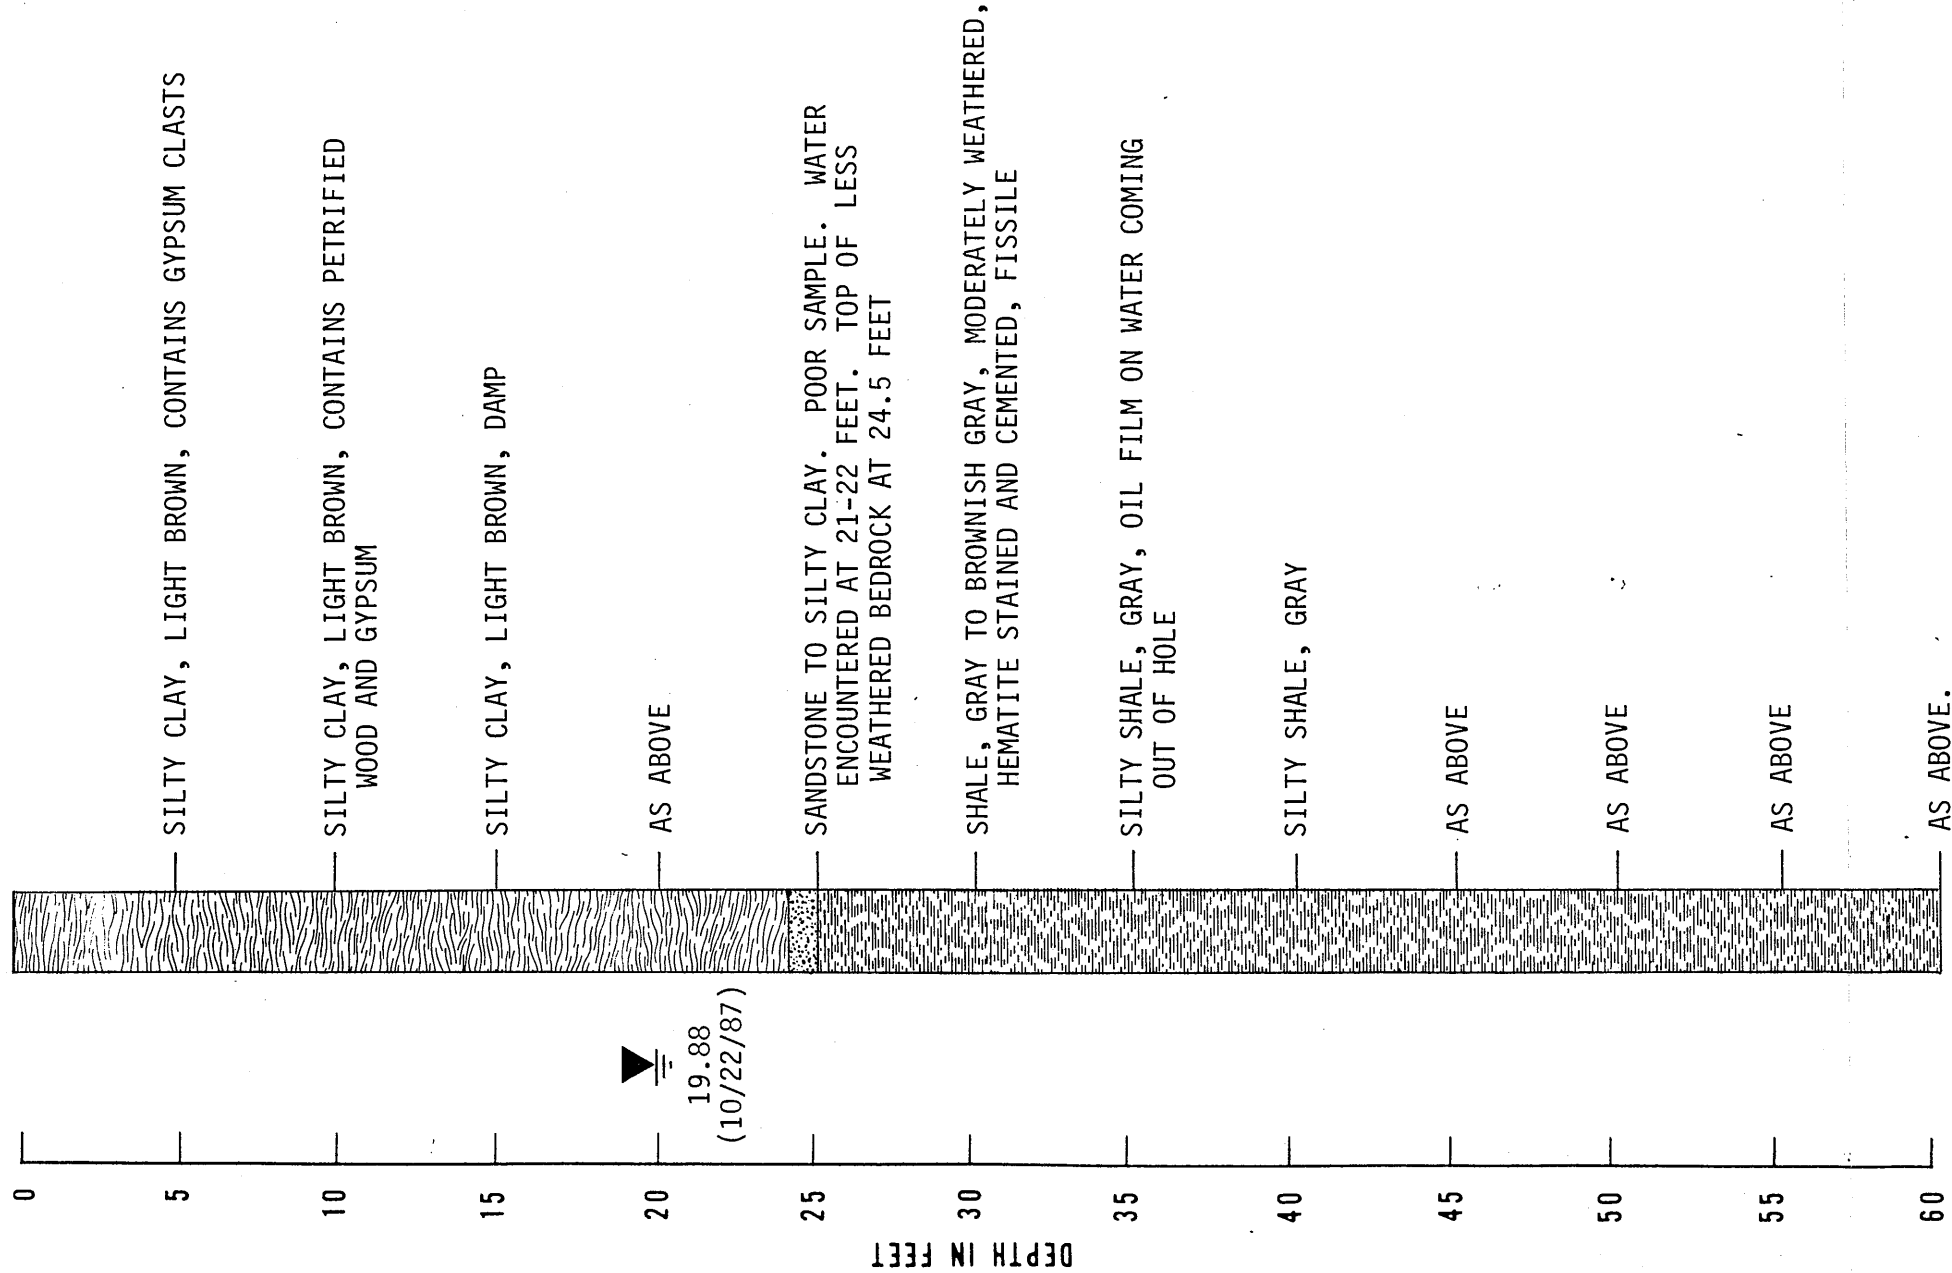

BORING TERMINATED AT 60 FEET ON 3/11/87.  
NOTE: LITHOLOGIC LOG IS BASED ON RESULTS FROM THE 1st HOLE THAT WAS DRILLED. A 2nd HOLE, OFFSET BY 15 FEET, WAS DRILLED FOR CONSTRUCTING THE MONITOR WELL.

LITHOLOGIC LOG

SURFACE ELEVATION 5118.95 FT.  
MEASURING POINT 5120.95 FT.

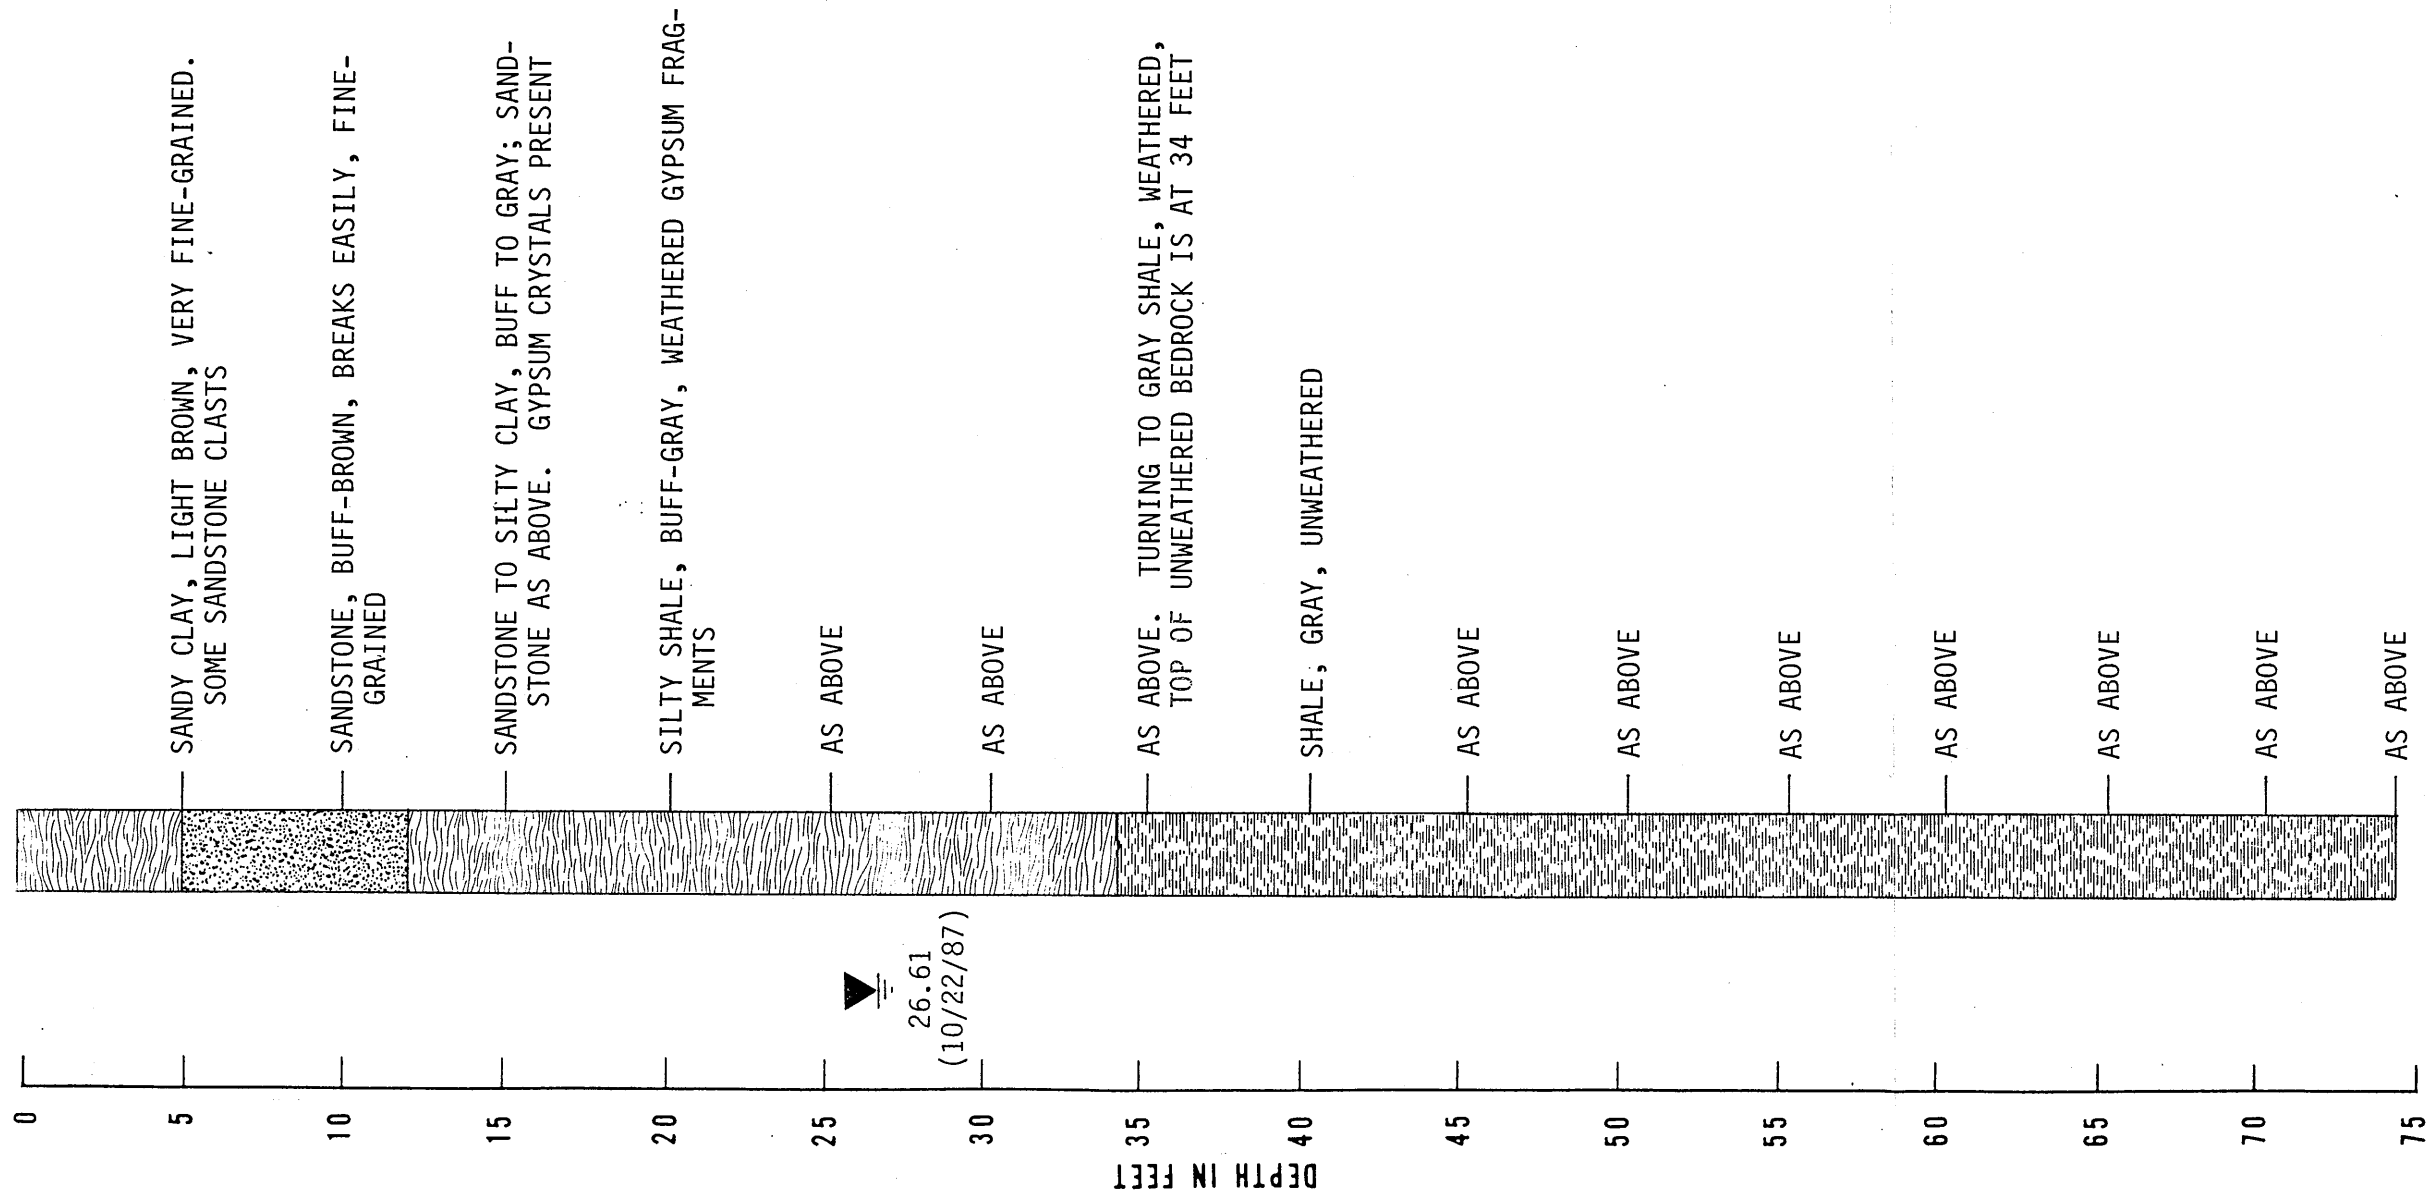


BORING TERMINATED AT 74 FEET ON 3/11/87.  
NOTE: LITHOLOGIC LOG IS BASED ON RESULTS FROM  
THE 1st HOLE THAT WAS DRILLED. A 2nd  
HOLE, OFFSET BY 35 FEET, WAS DRILLED FOR  
CONSTRUCTING THE MONITOR WELL.

# LITHOLOGIC LOG

SURFACE ELEVATION 5173 FT. (est.)

MEASURING POINT

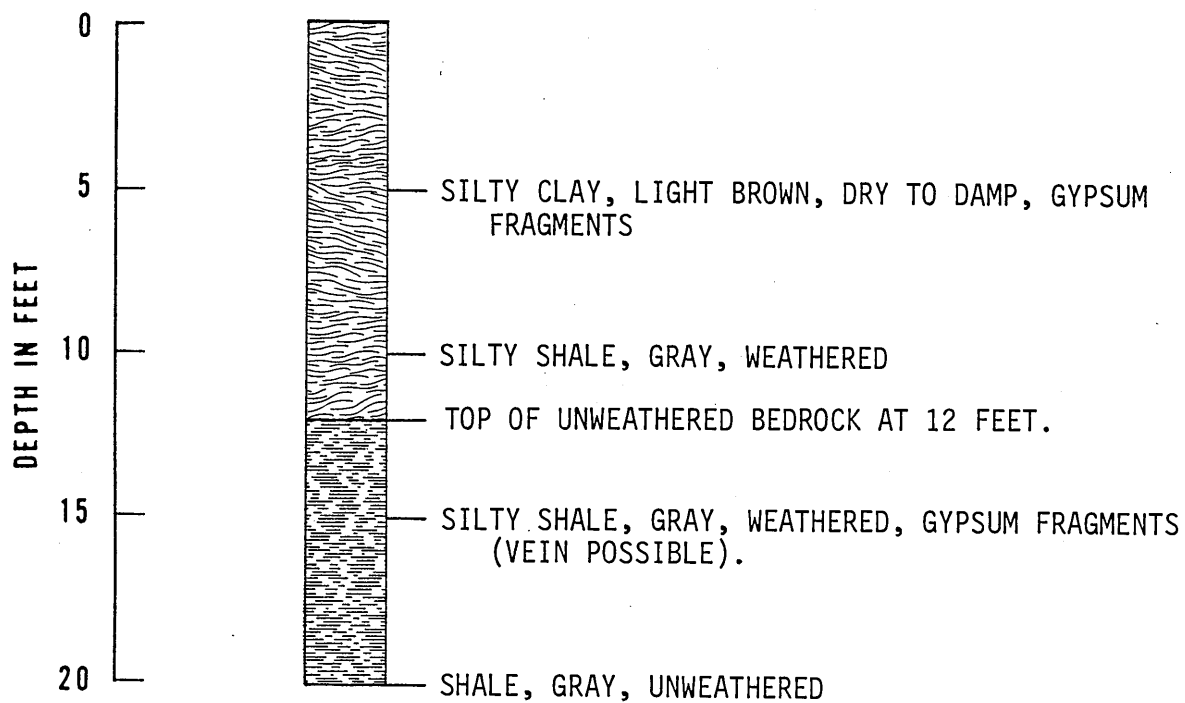


BORING TERMINATED AT 20 FEET ON 3/11/87.  
HOLE WAS BACKFILLED WITH CUTTINGS AND  
ABANDONED.

BORING MW-9

# LITHOLOGIC LOG

SURFACE ELEVATION 5147.38 FT.  
MEASURING POINT 5148.88 FT.

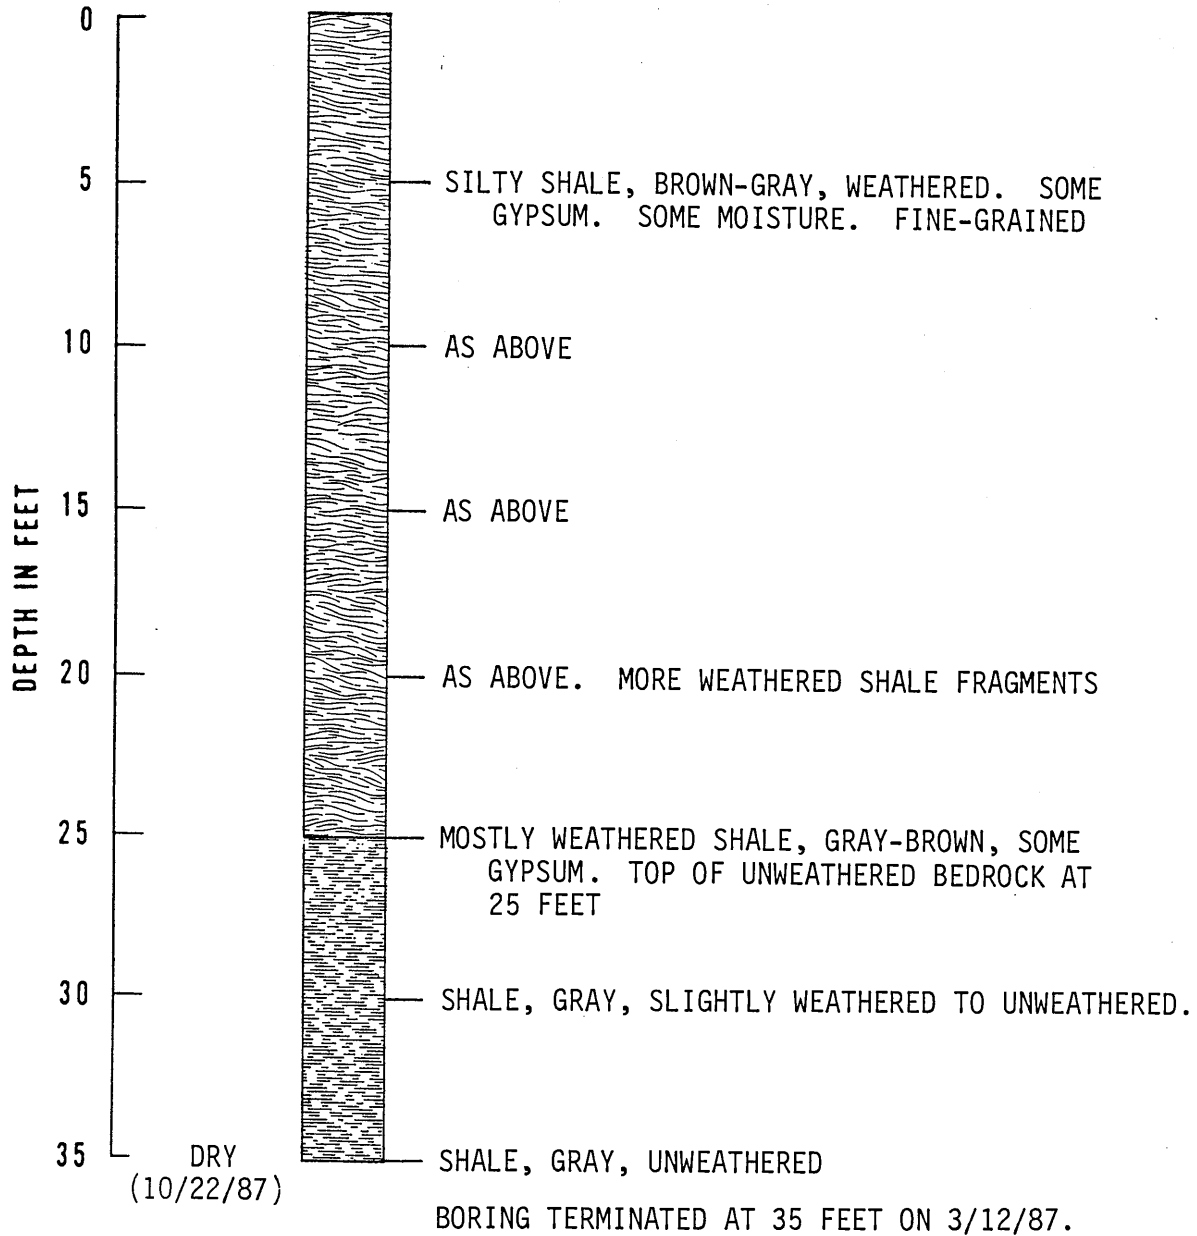


BORING MW-10




LITHOLOGIC LOG

SURFACE ELEVATION 5109.01 FT.  
MEASURING POINT 5111.31 FT.

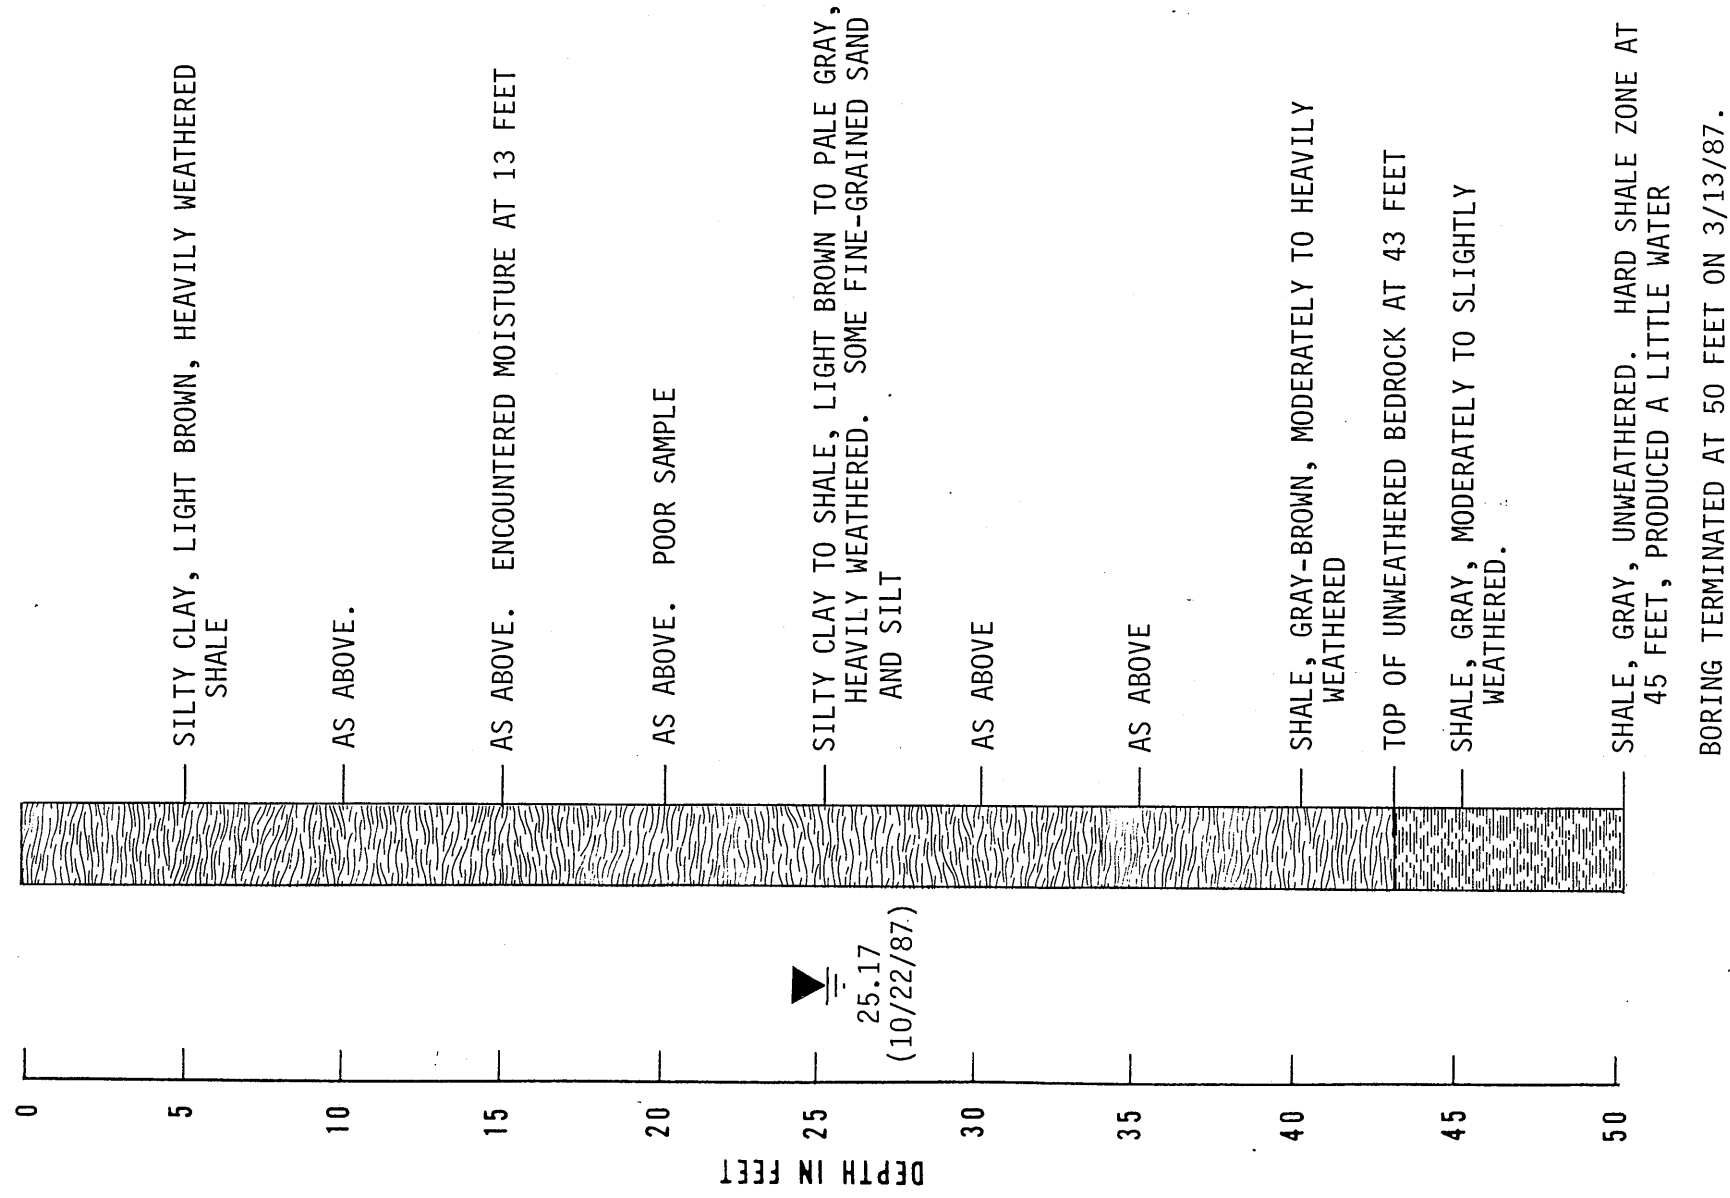

LITHOLOGIC LOG


SURFACE ELEVATION 5196.63 FT.  
MEASURING POINT 5198.43 FT.

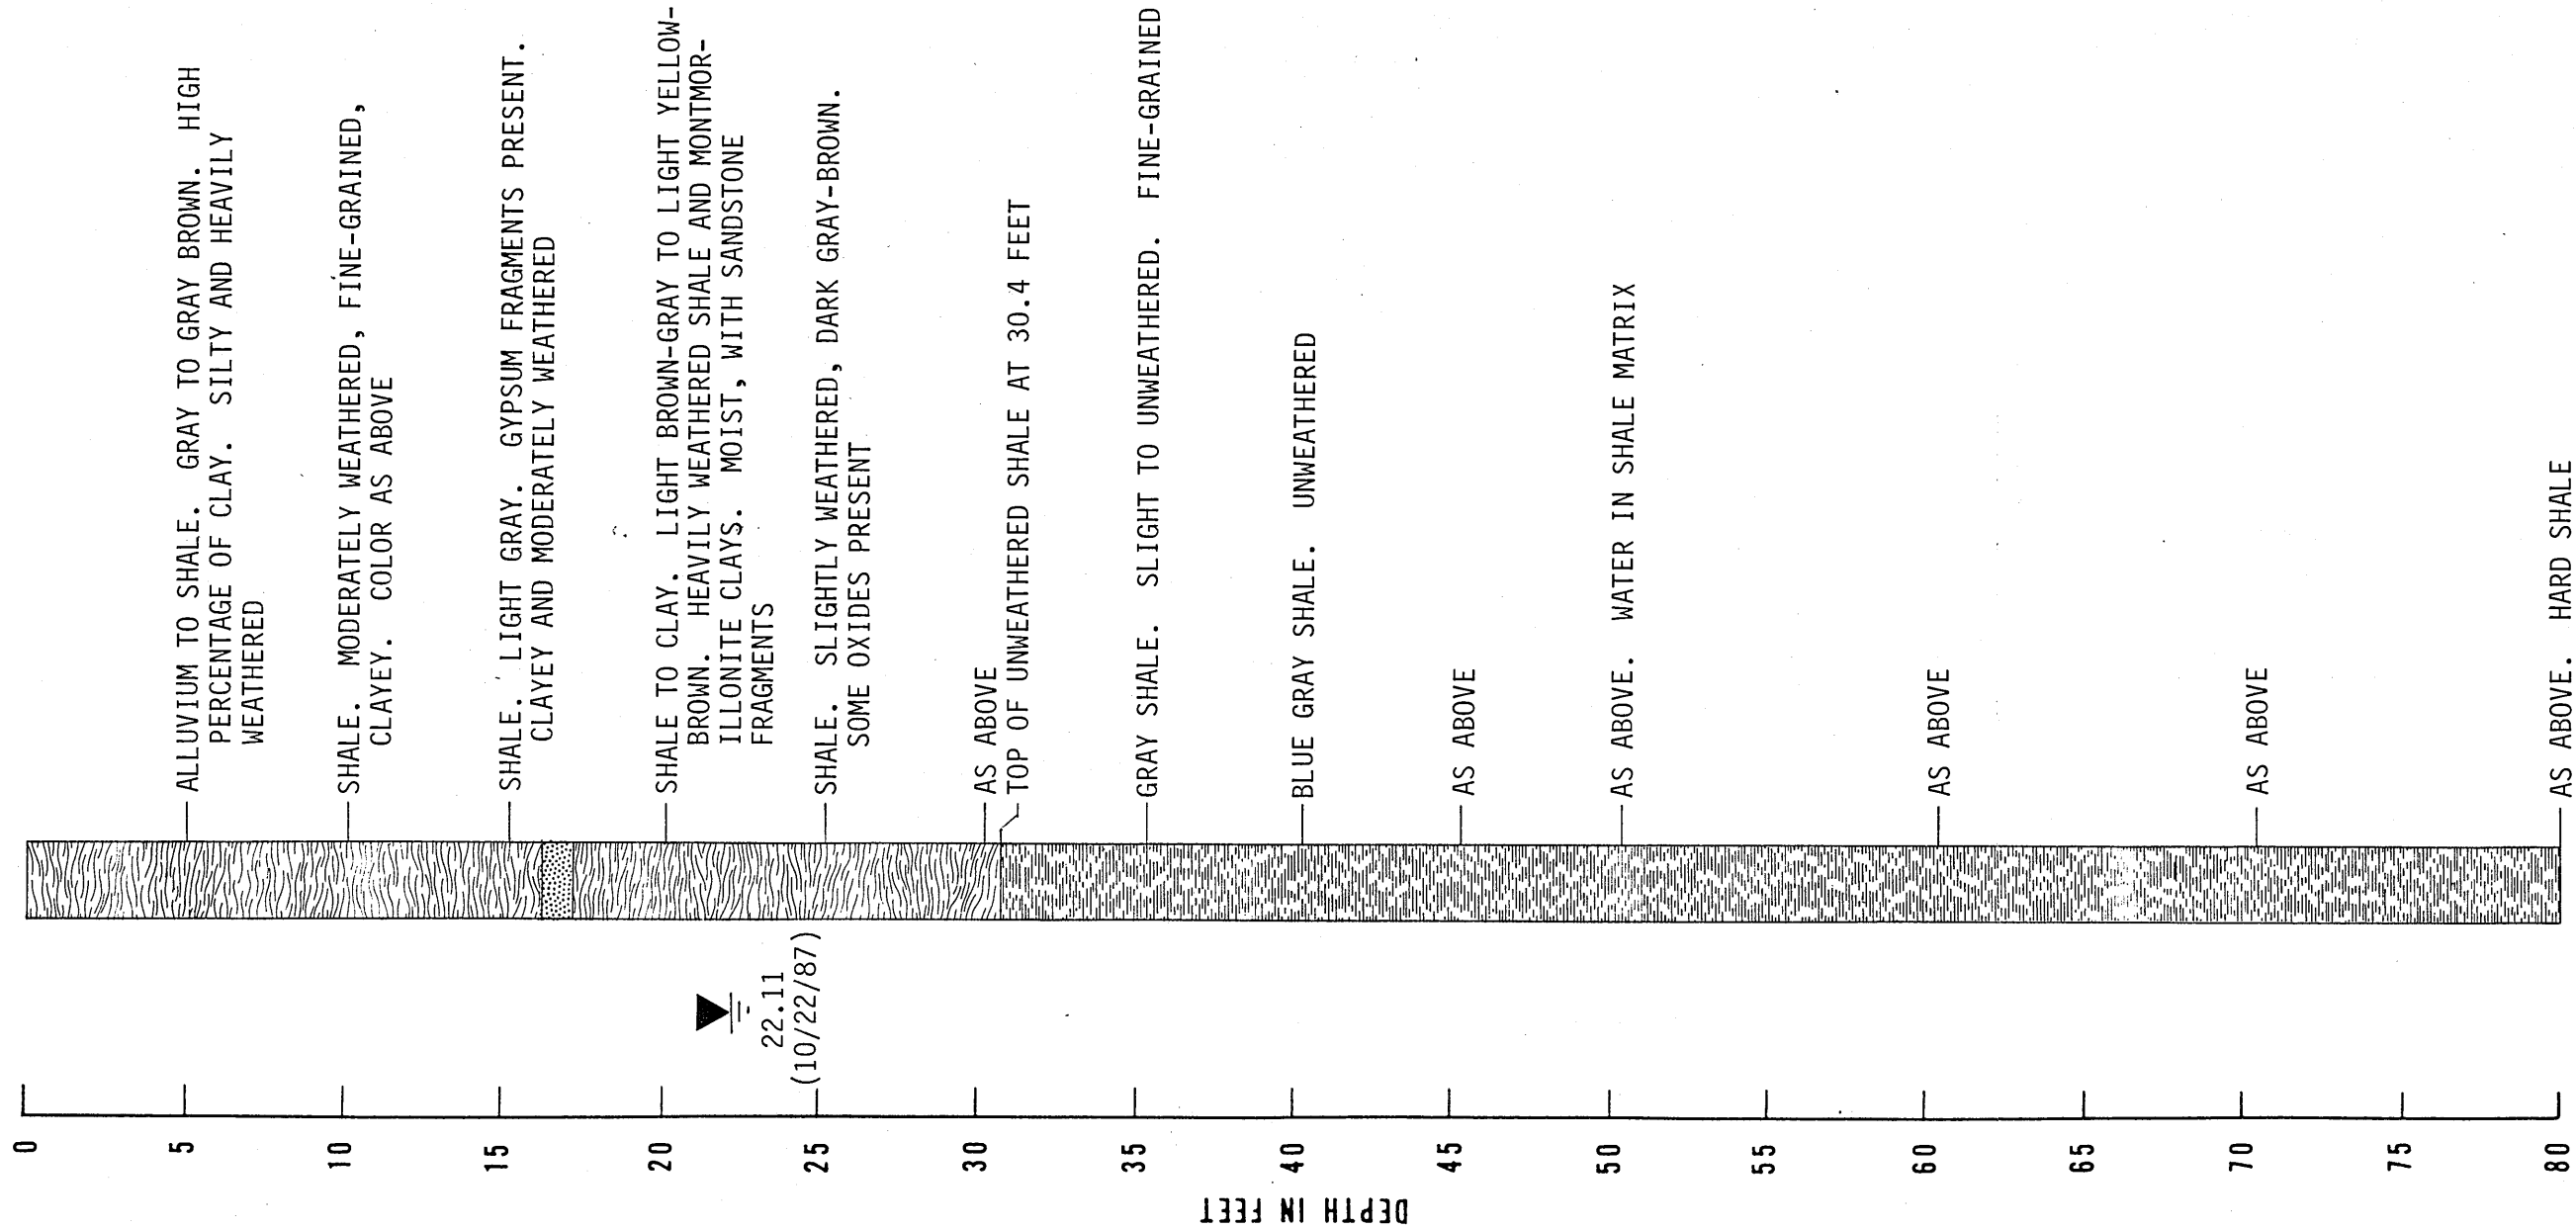

BORING TERMINATED AT 80 FEET ON 8/31/87.  
NOTE: LITHOLOGIC LOG WAS BASED ON THE FIRST HOLE THAT WAS DRILLED. A 2nd HOLE, OFFSET 10 FEET, WAS DRILLED ON 9/1/87 FOR CONSTRUCTING THE MONITOR WELL.

LITHOLOGIC LOG

SURFACE ELEVATION 5147.39 FT.  
MEASURING POINT 5149.14 FT.

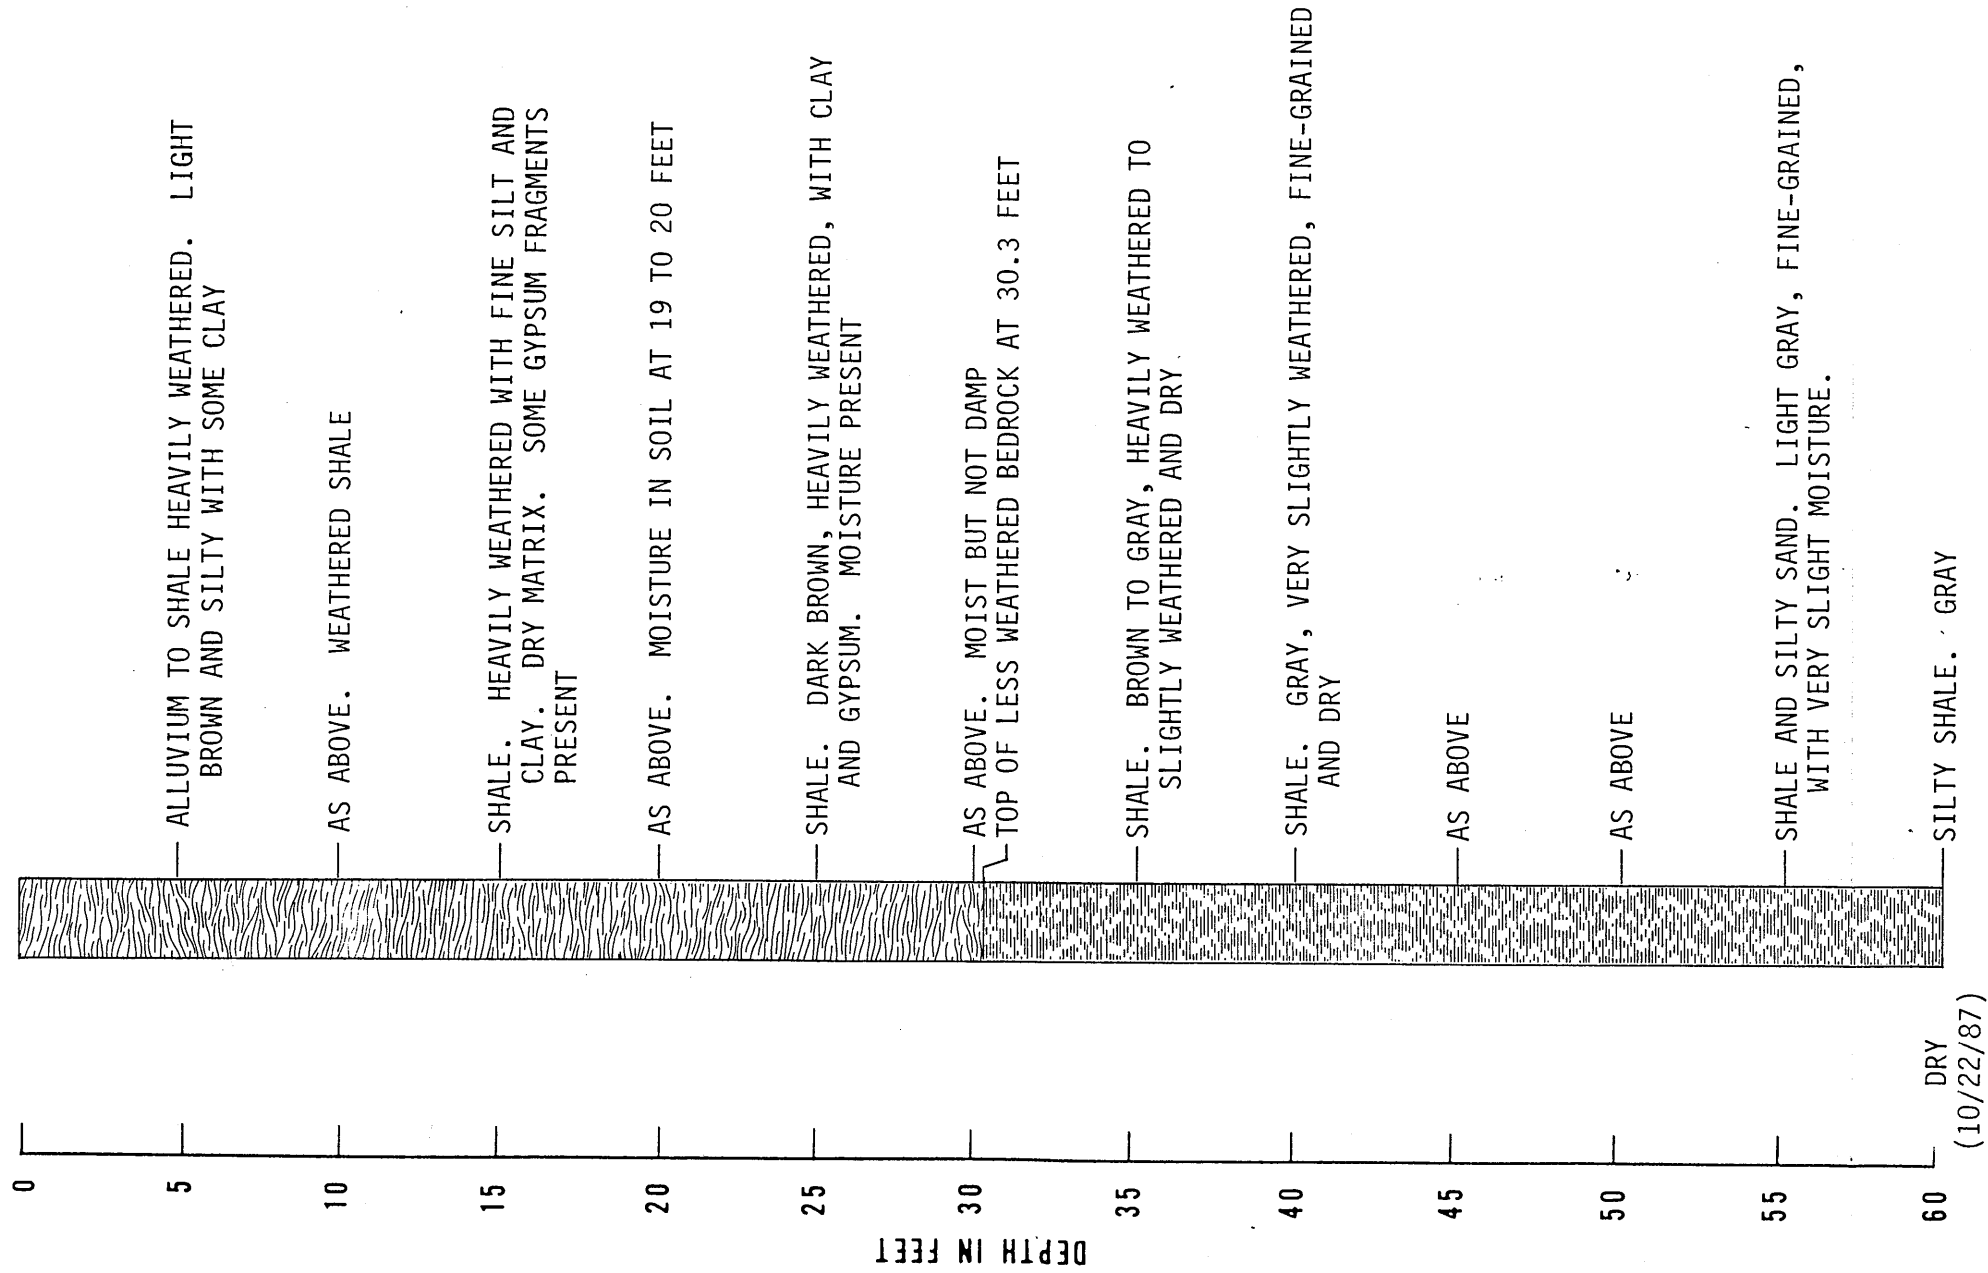


BORING TERMINATED AT 60 FEET ON 8/31/87.

# LITHOLOGIC LOG

SURFACE ELEVATION 5177.28 FT.

MEASURING POINT 5179.31 FT.

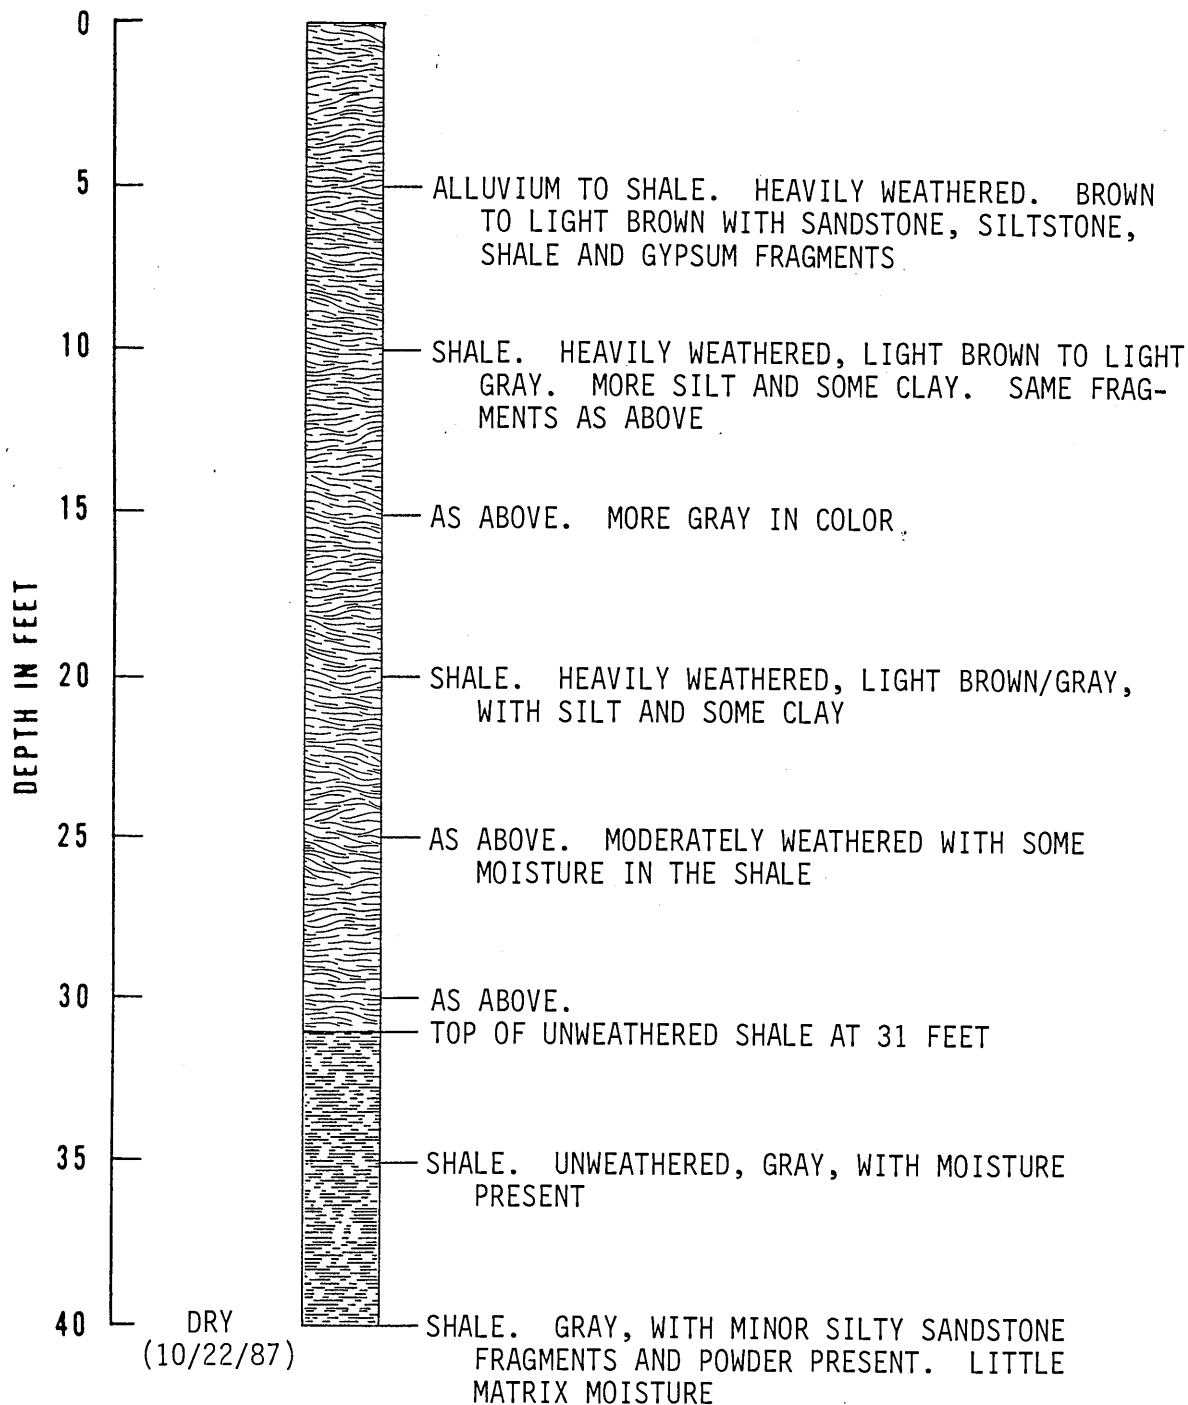


BORING TERMINATED AT 40 FEET ON 8/31/87.

BORING MW-14

LITHOLOGIC LOG


SURFACE ELEVATION 5089.86 FT.  
MEASURING POINT 5091.46 FT.

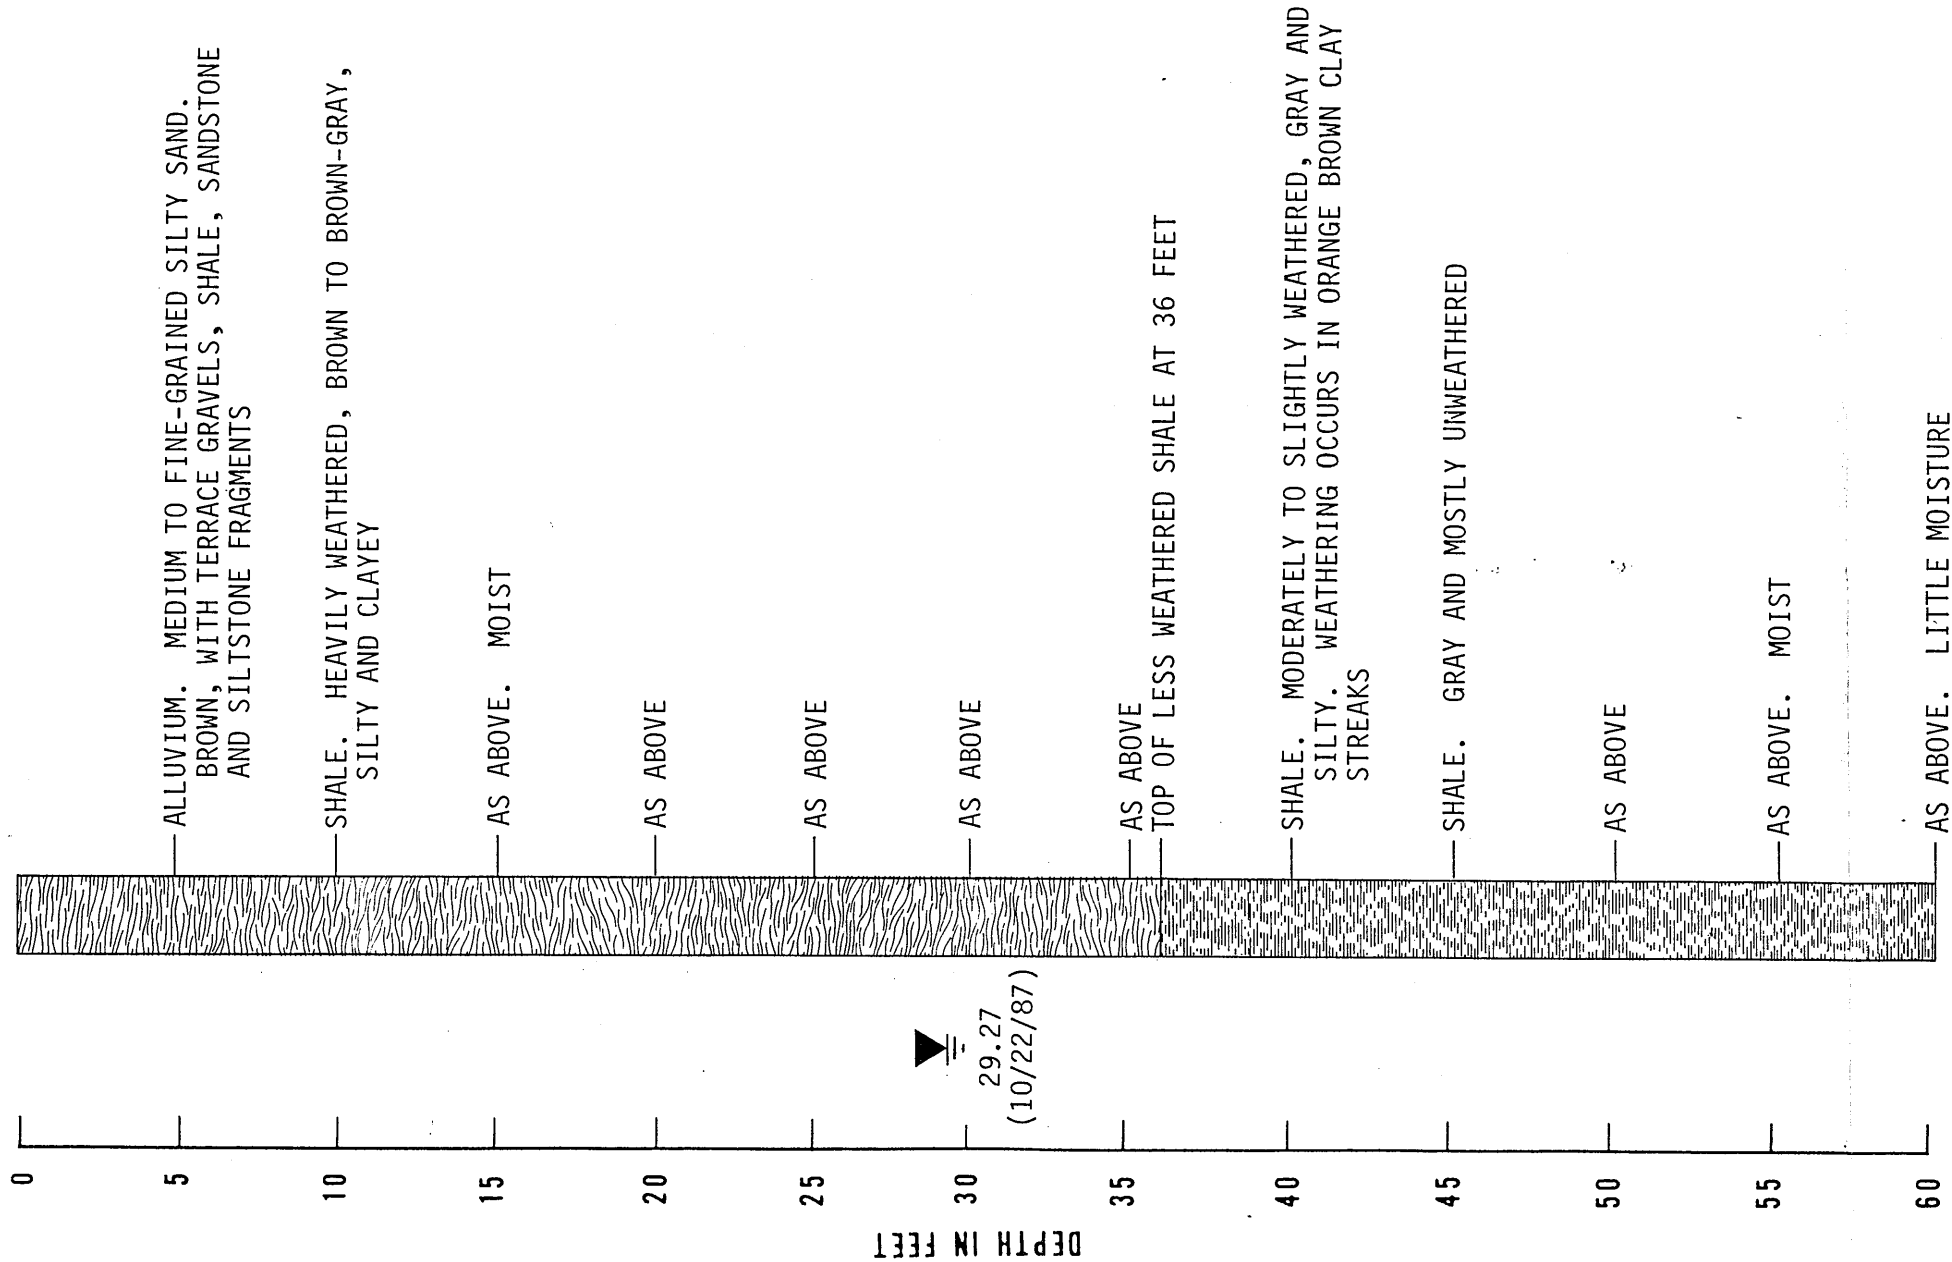

BORING TERMINATED AT 60 FEET ON 9/1/87.

LITHOLOGIC LOG


SURFACE ELEVATION 5096.44 FT.  
MEASURING POINT 5099.94 FT.

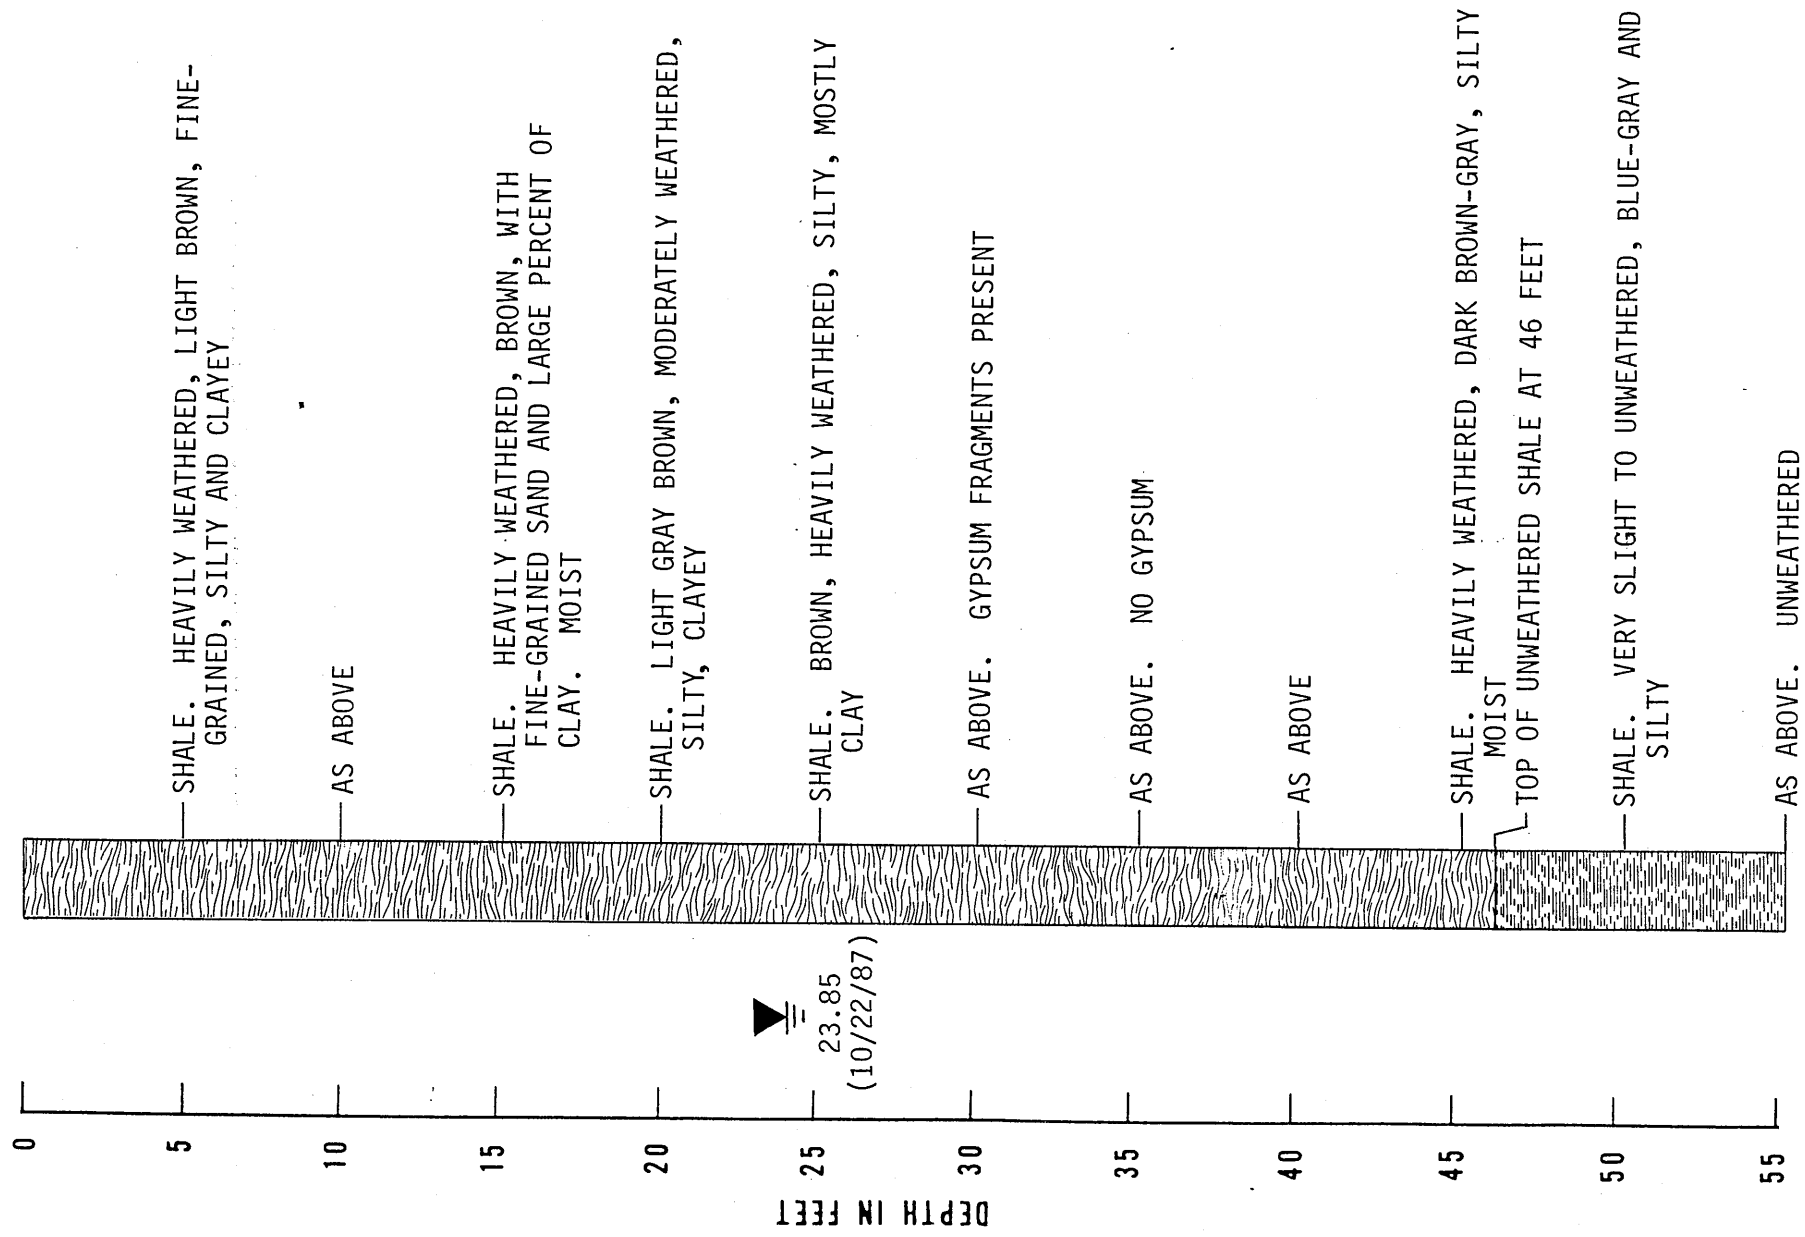

BORING TERMINATED AT 55 FEET ON 9/2/87.

LITHOLOGIC LOG


SURFACE ELEVATION 5092.03 FT.  
MEASURING POINT 5094.78 FT.

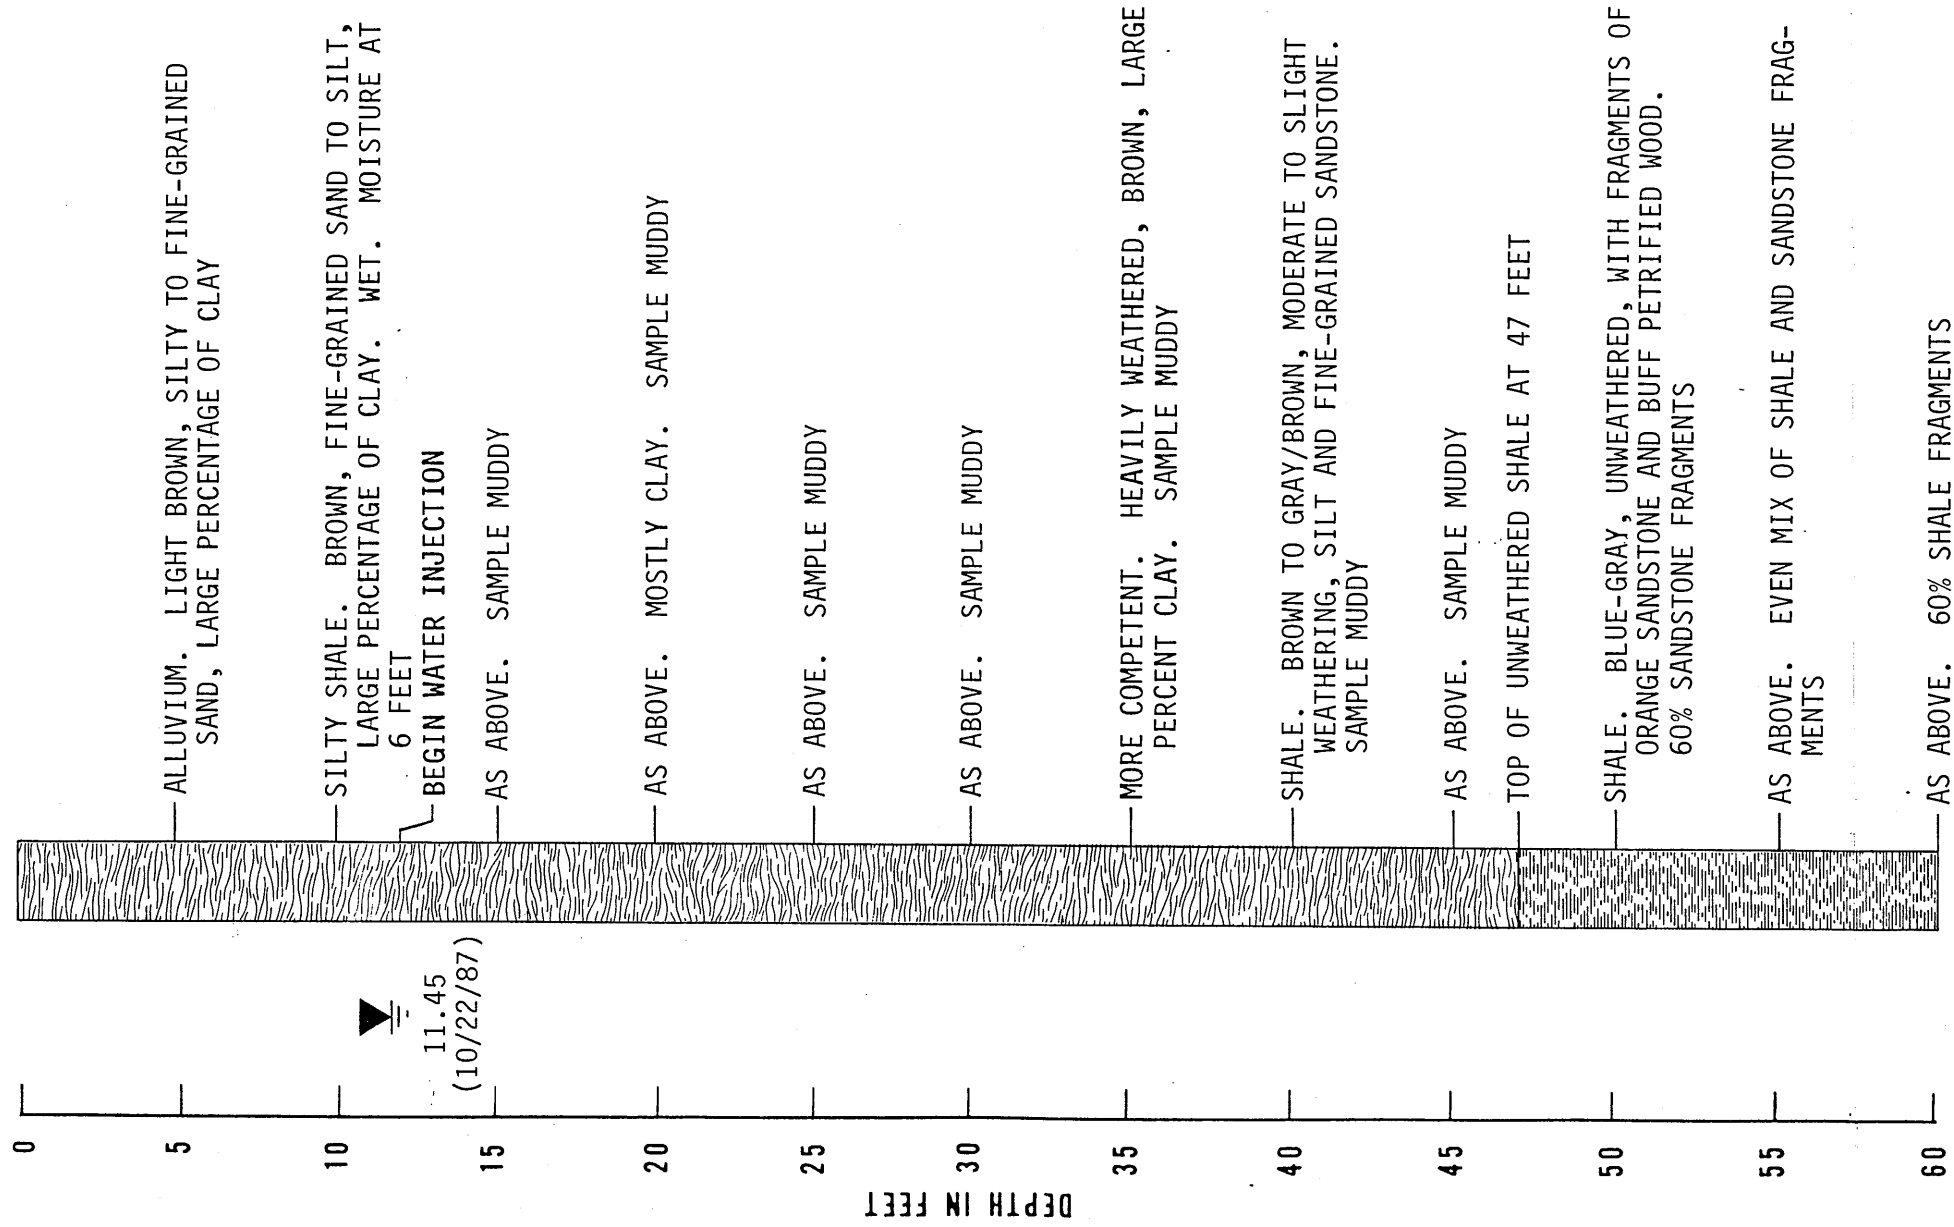

BORING TERMINATED AT 60 FEET ON 9/2/87.

LITHOLOGIC LOG

SURFACE ELEVATION 5085.78 FT.  
MEASURING POINT 5087.48 FT.

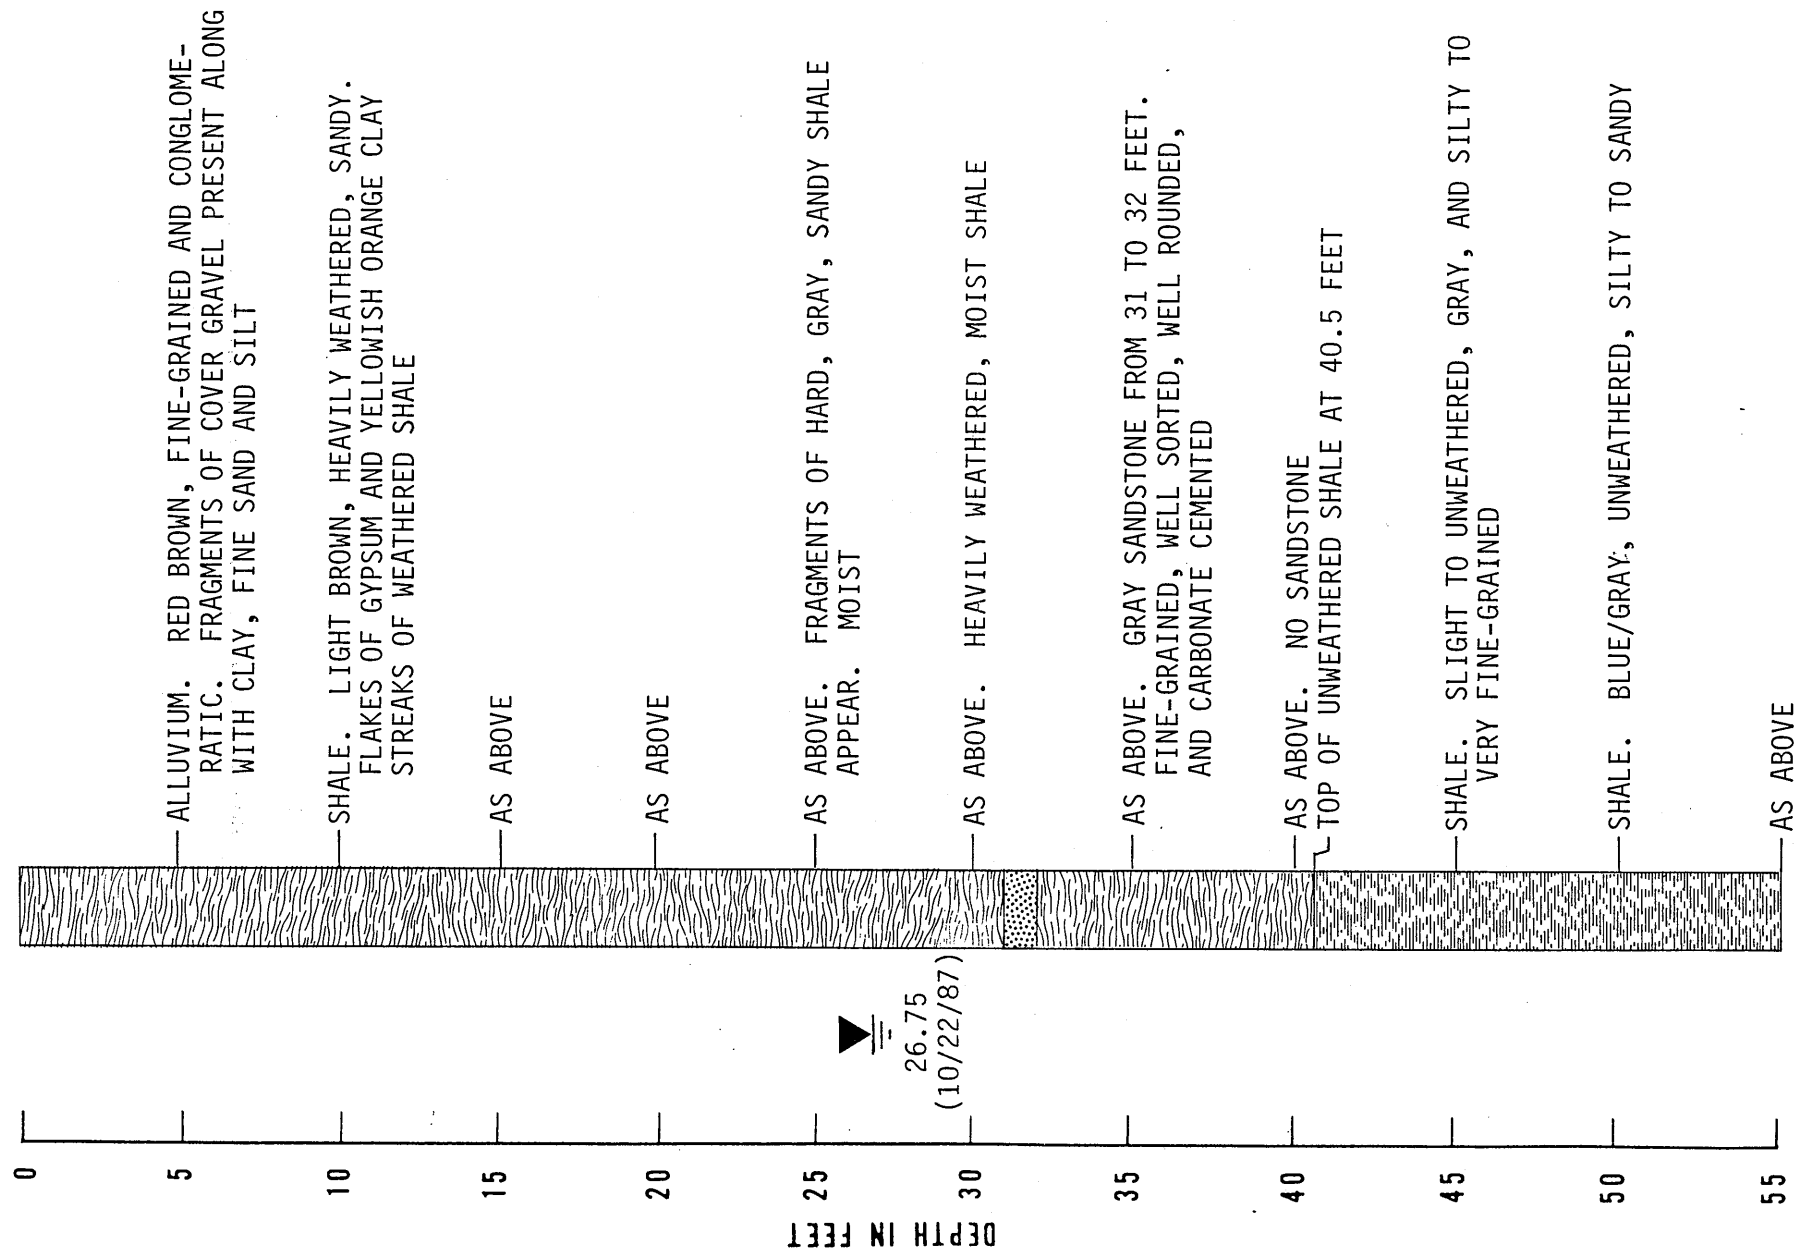


BORING TERMINATED AT 55 FEET ON 9/3/87.



LITHOLOGIC LOG


SURFACE ELEVATION 5123.73 FT.  
MEASURING POINT 5125.78 FT.

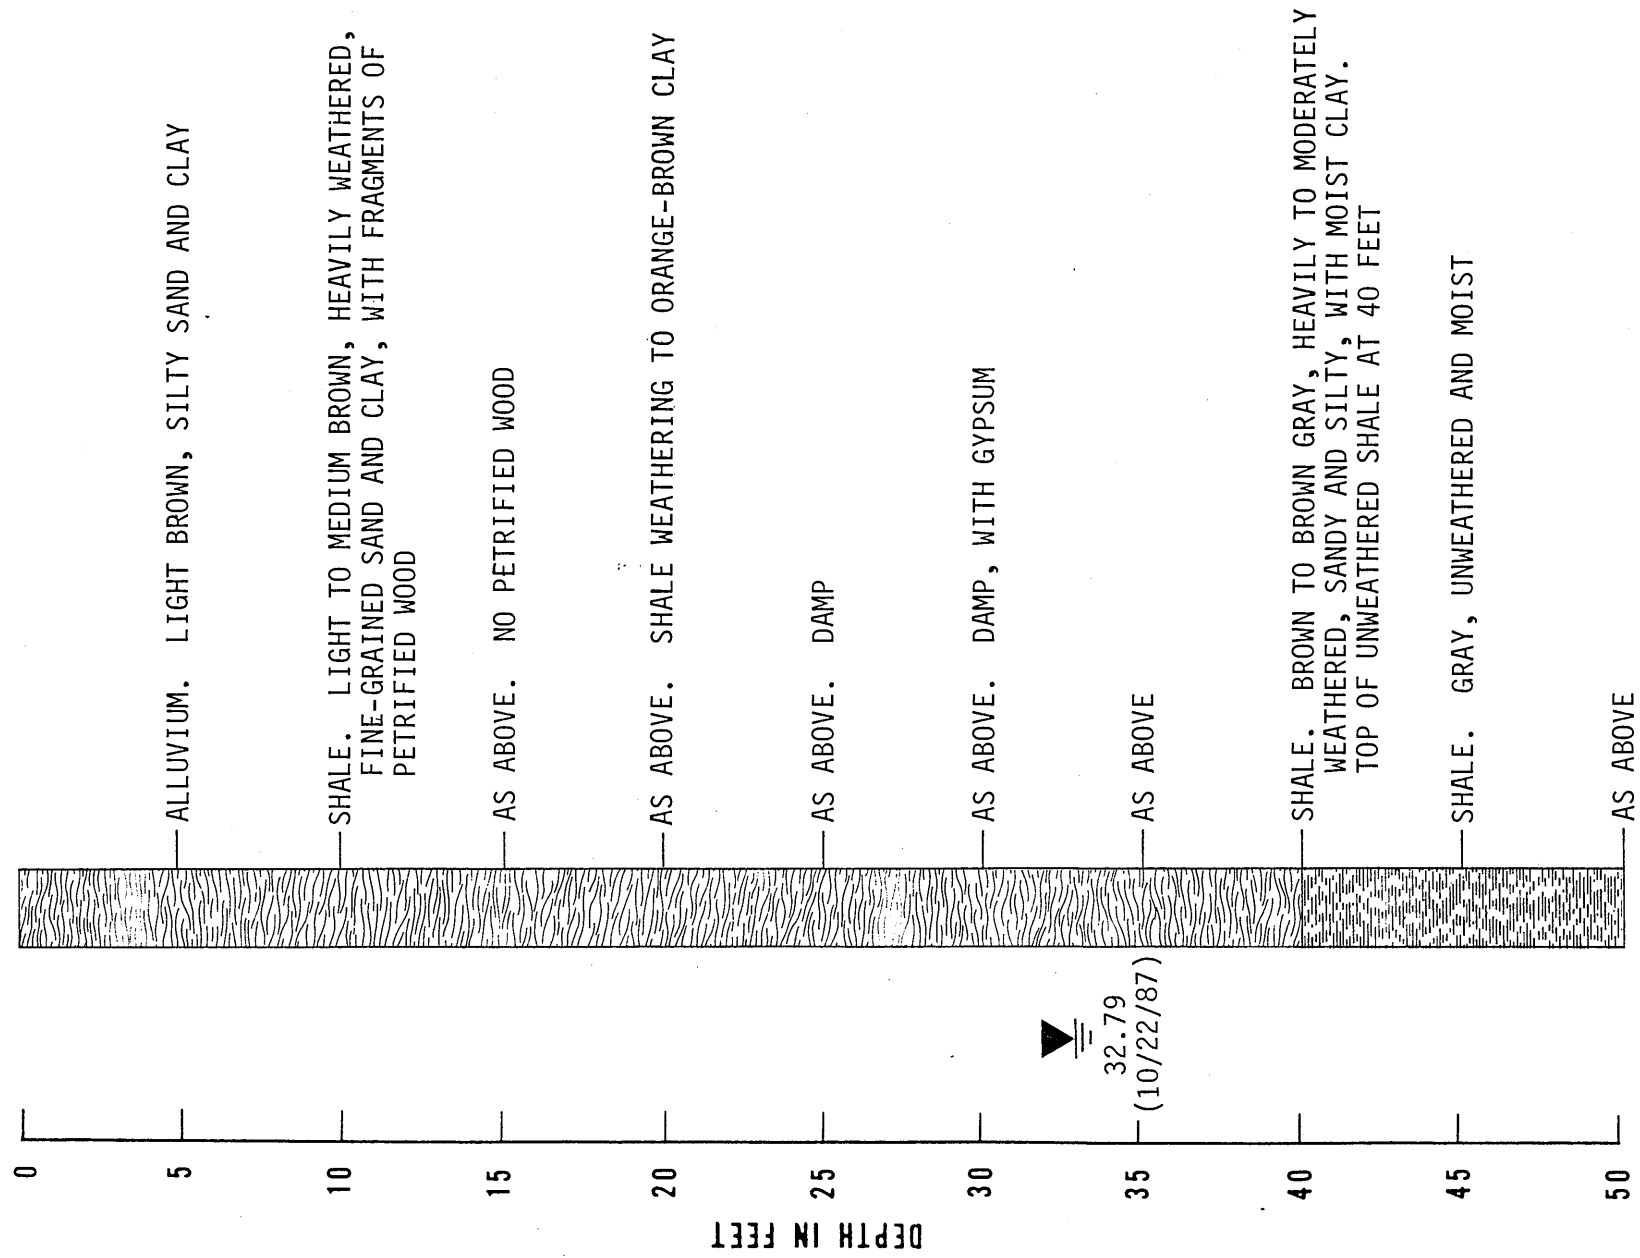

BORING TERMINATED AT 50 FEET ON 9/3/87.

# LITHOLOGIC LOG

SURFACE ELEVATION 5125.63 FT.  
MEASURING POINT 5128.33 FT.

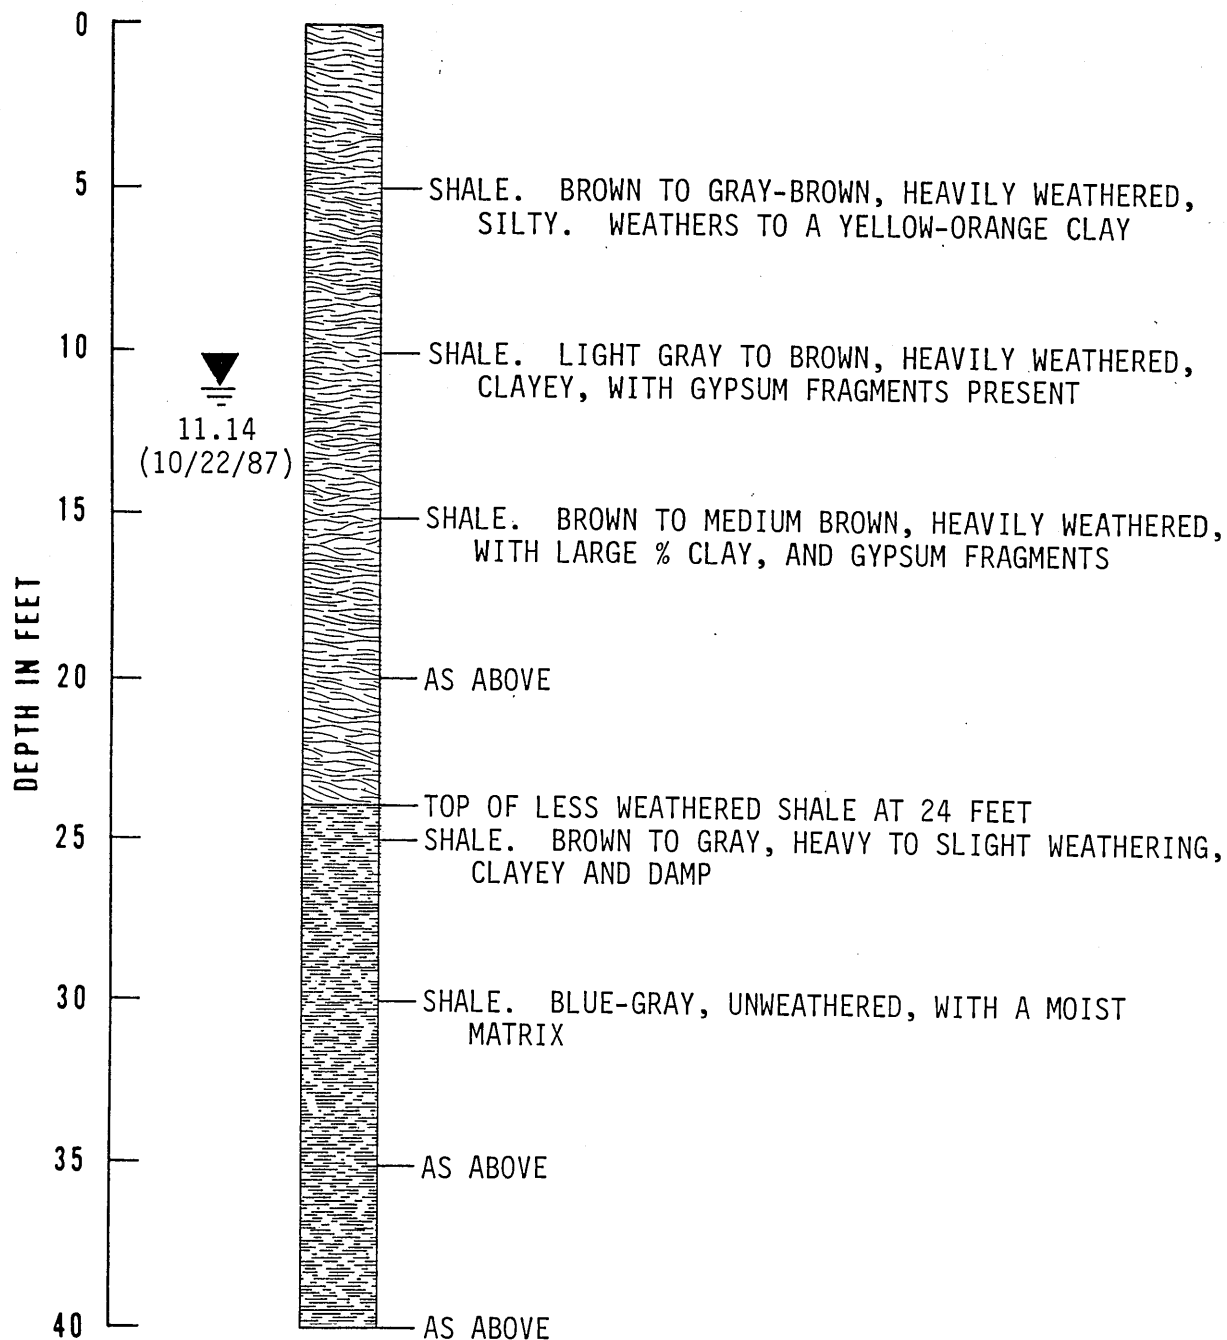


BORING TERMINATED AT 40 FEET ON 9/3/87.

BORING MW-20

# LITHOLOGIC LOG

SURFACE ELEVATION 5150.95 FT.  
MEASURING POINT 5153.05 FT.

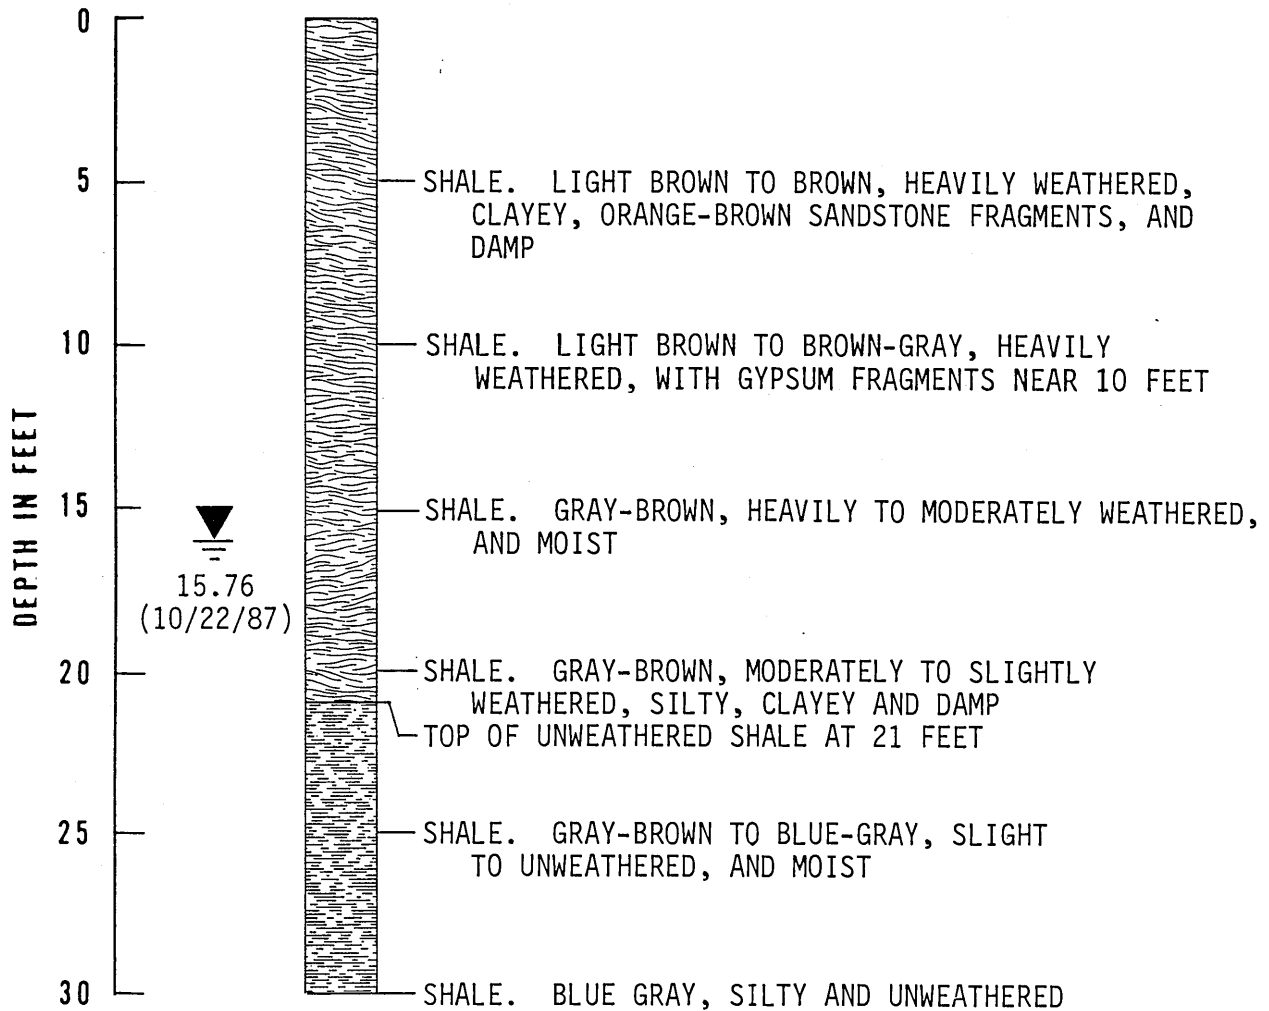


BORING TERMINATED AT 30 FEET ON 9/4/87.

BORING MW-21

# LITHOLOGIC LOG

SURFACE ELEVATION 5152.38 FT.  
MEASURING POINT 5154.48 FT.

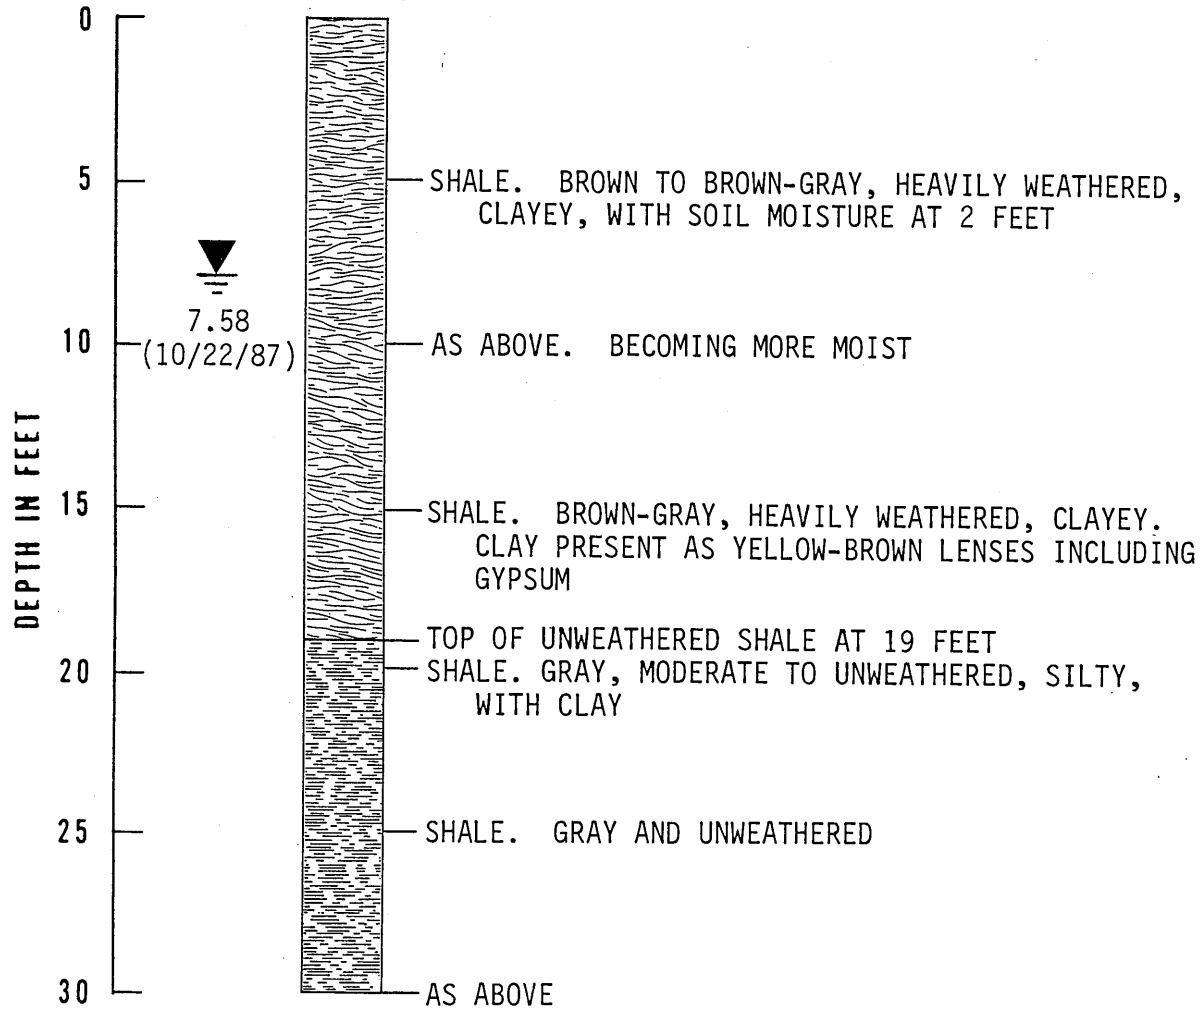


BORING TERMINATED AT 30 FEET ON 9/4/87.

BORING MW-22



LITHOLOGIC LOG


SURFACE ELEVATION 5094.56 FT.  
MEASURING POINT 5096.66 FT.

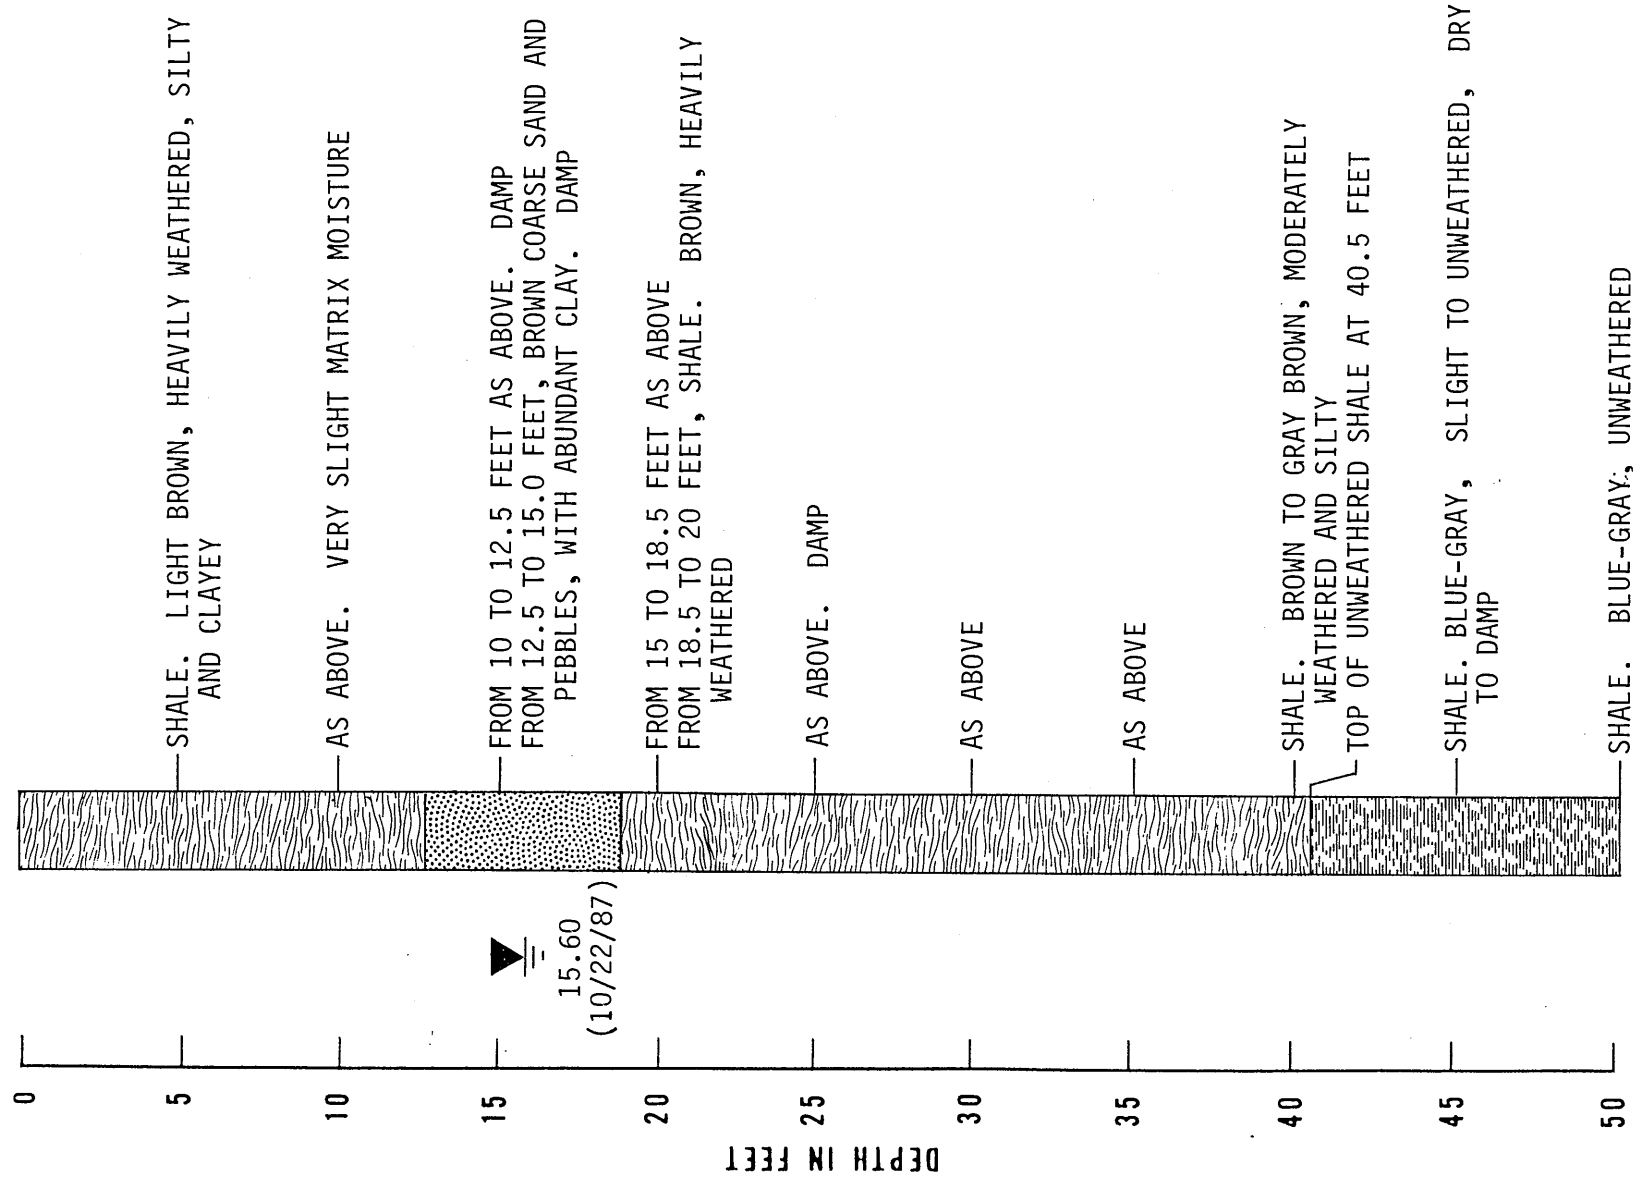

BORING TERMINATED AT 50 FEET ON 9/4/87.

LITHOLOGIC LOG


SURFACE ELEVATION 5078.02 FT.  
MEASURING POINT 5079.89 FT.

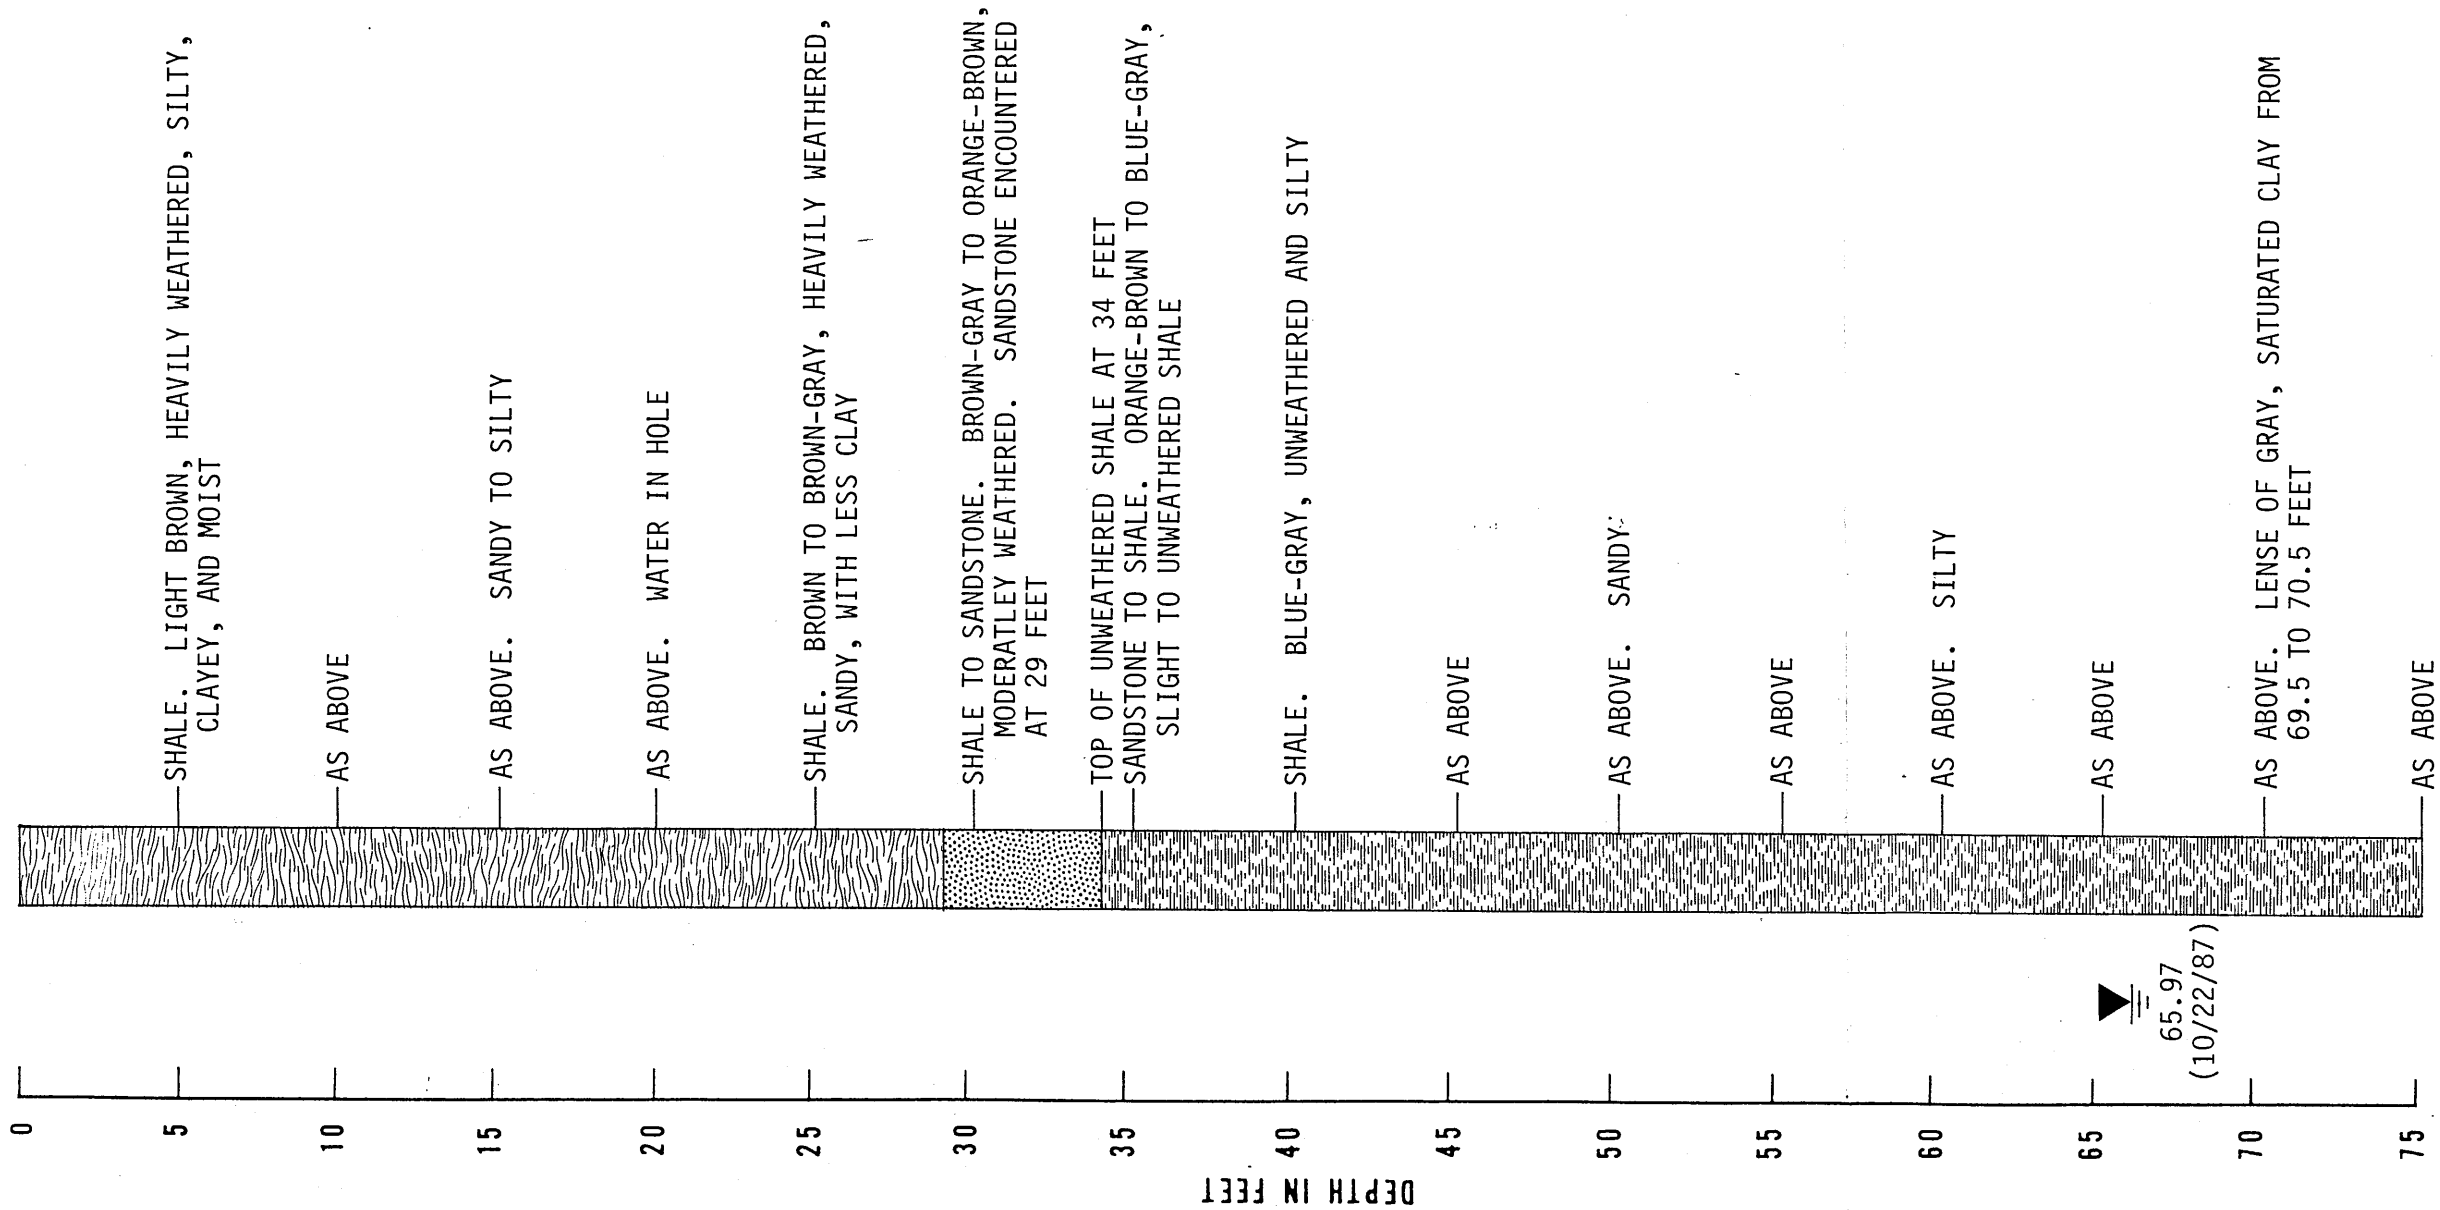

BORING TERMINATED AT 75 FEET ON 9/5/87.

LITHOLOGIC LOG


SURFACE ELEVATION 5119.50 FT.  
MEASURING POINT 5121.55 FT.

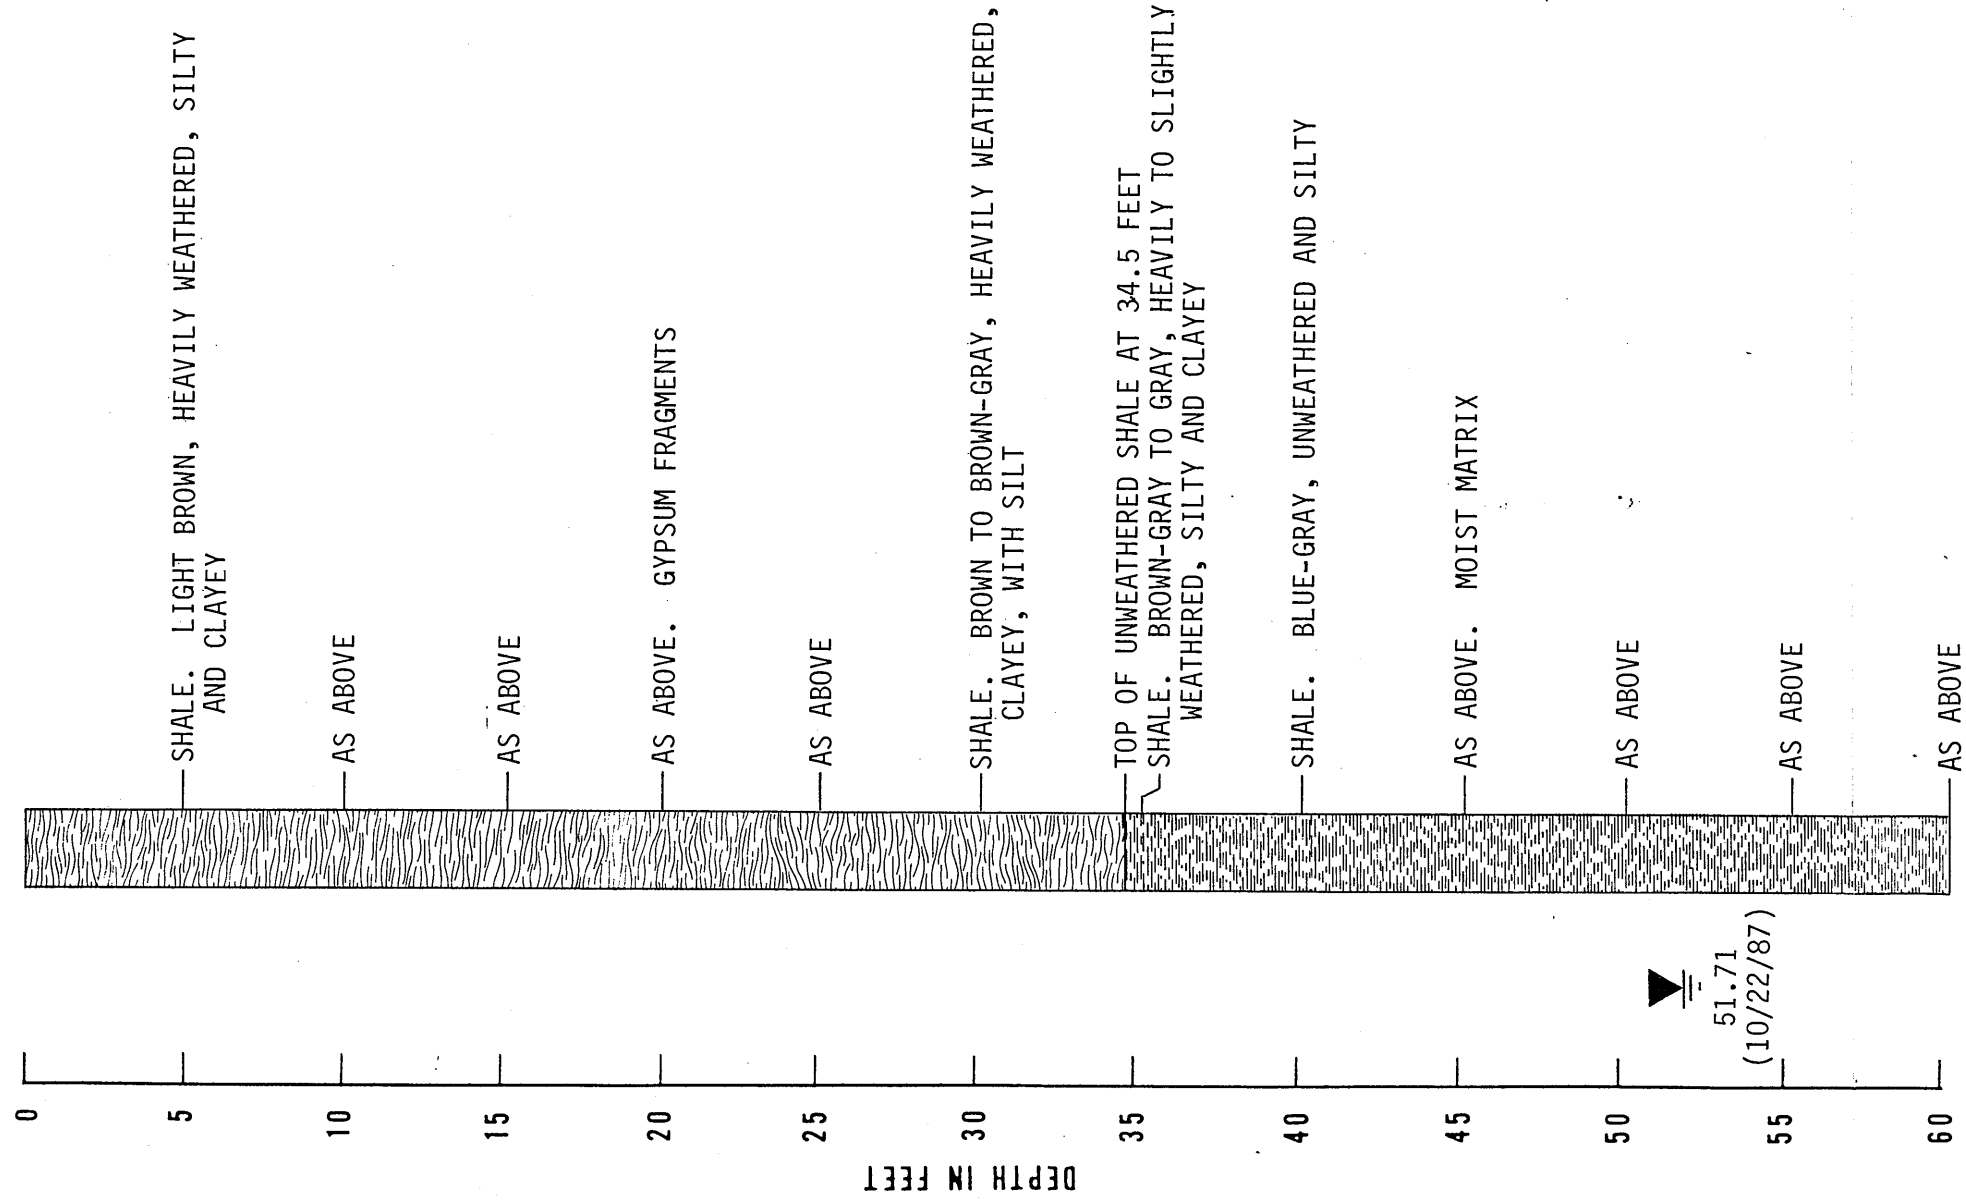



BORING TERMINATED AT 60 FEET ON 9/5/87.

LITHOLOGIC LOG

SURFACE ELEVATION 5137.05 FT.  
MEASURING POINT 5138.85 FT.

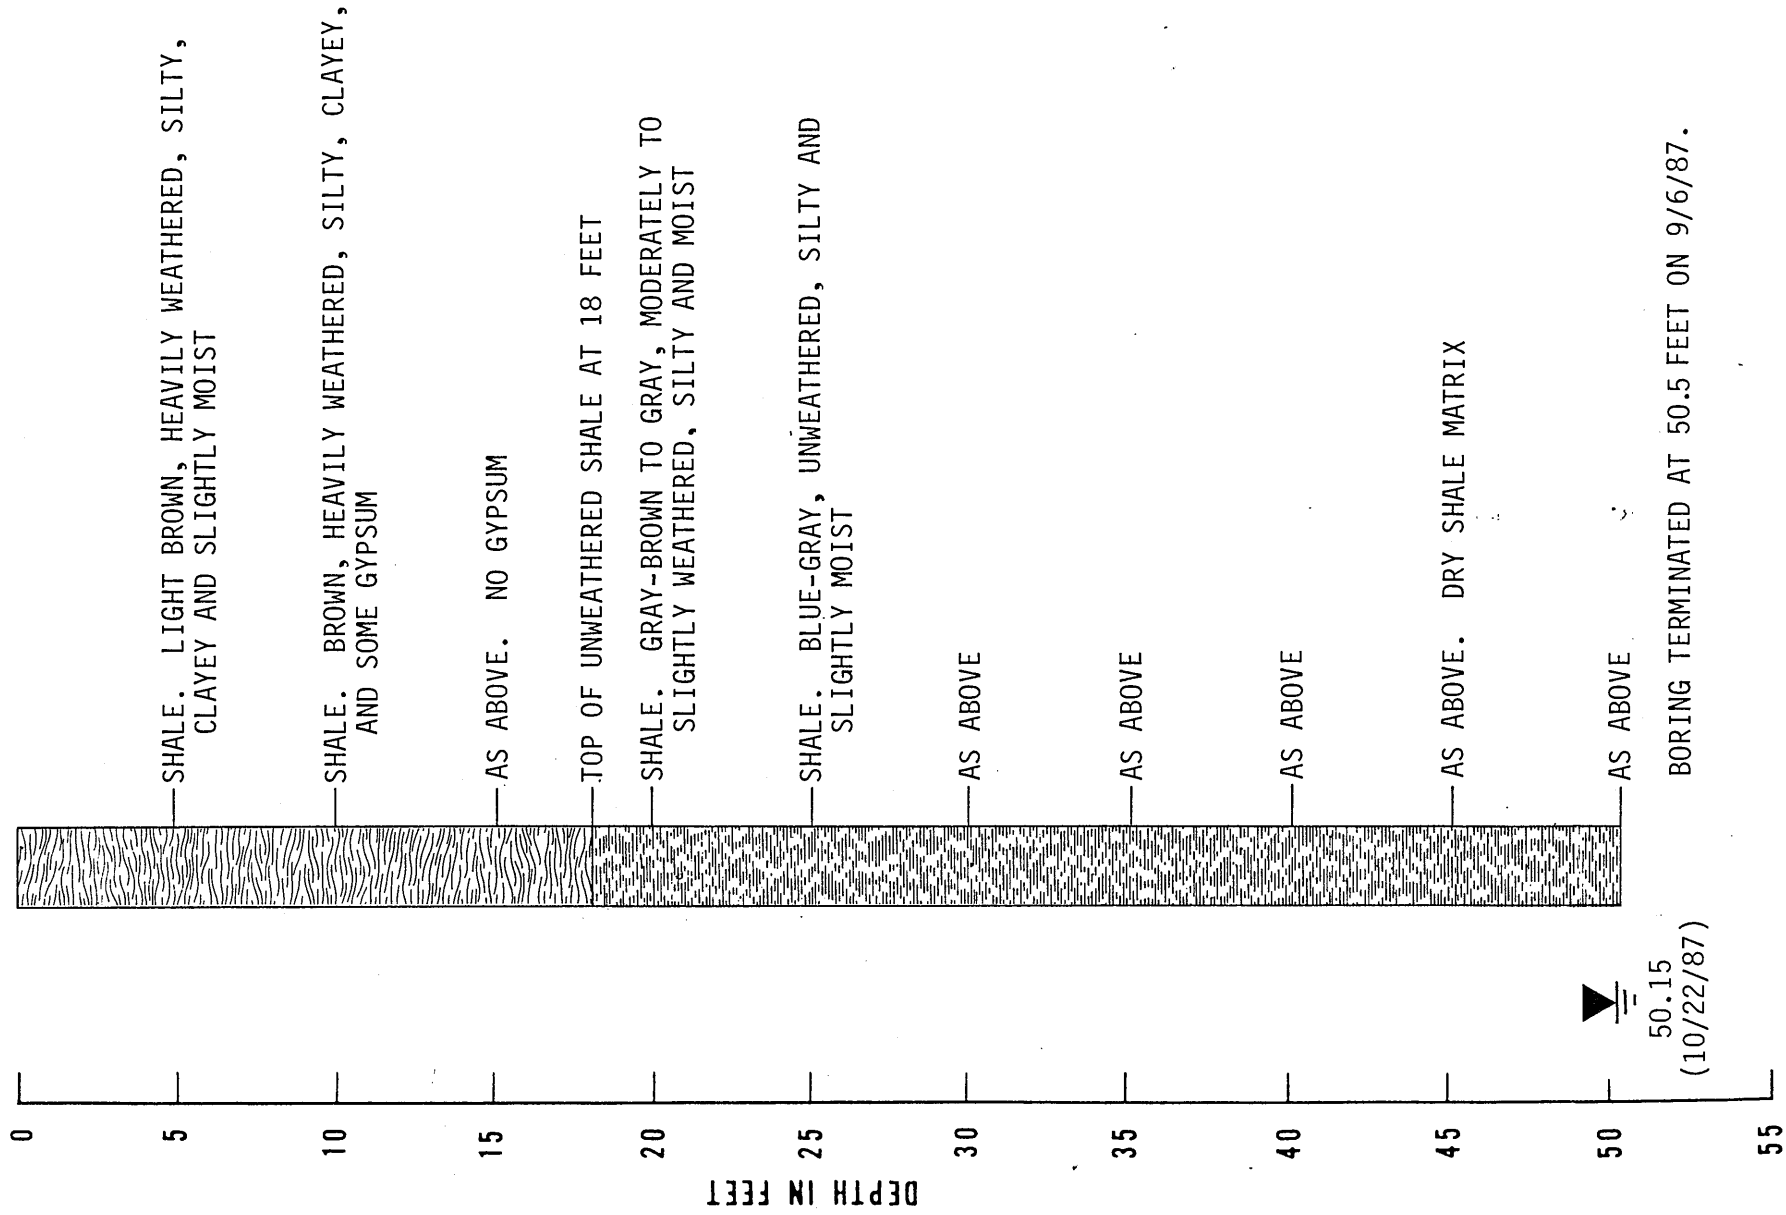



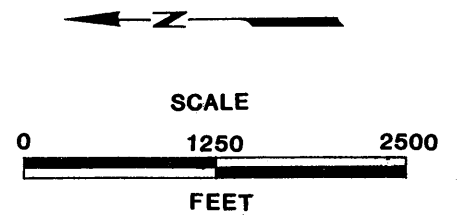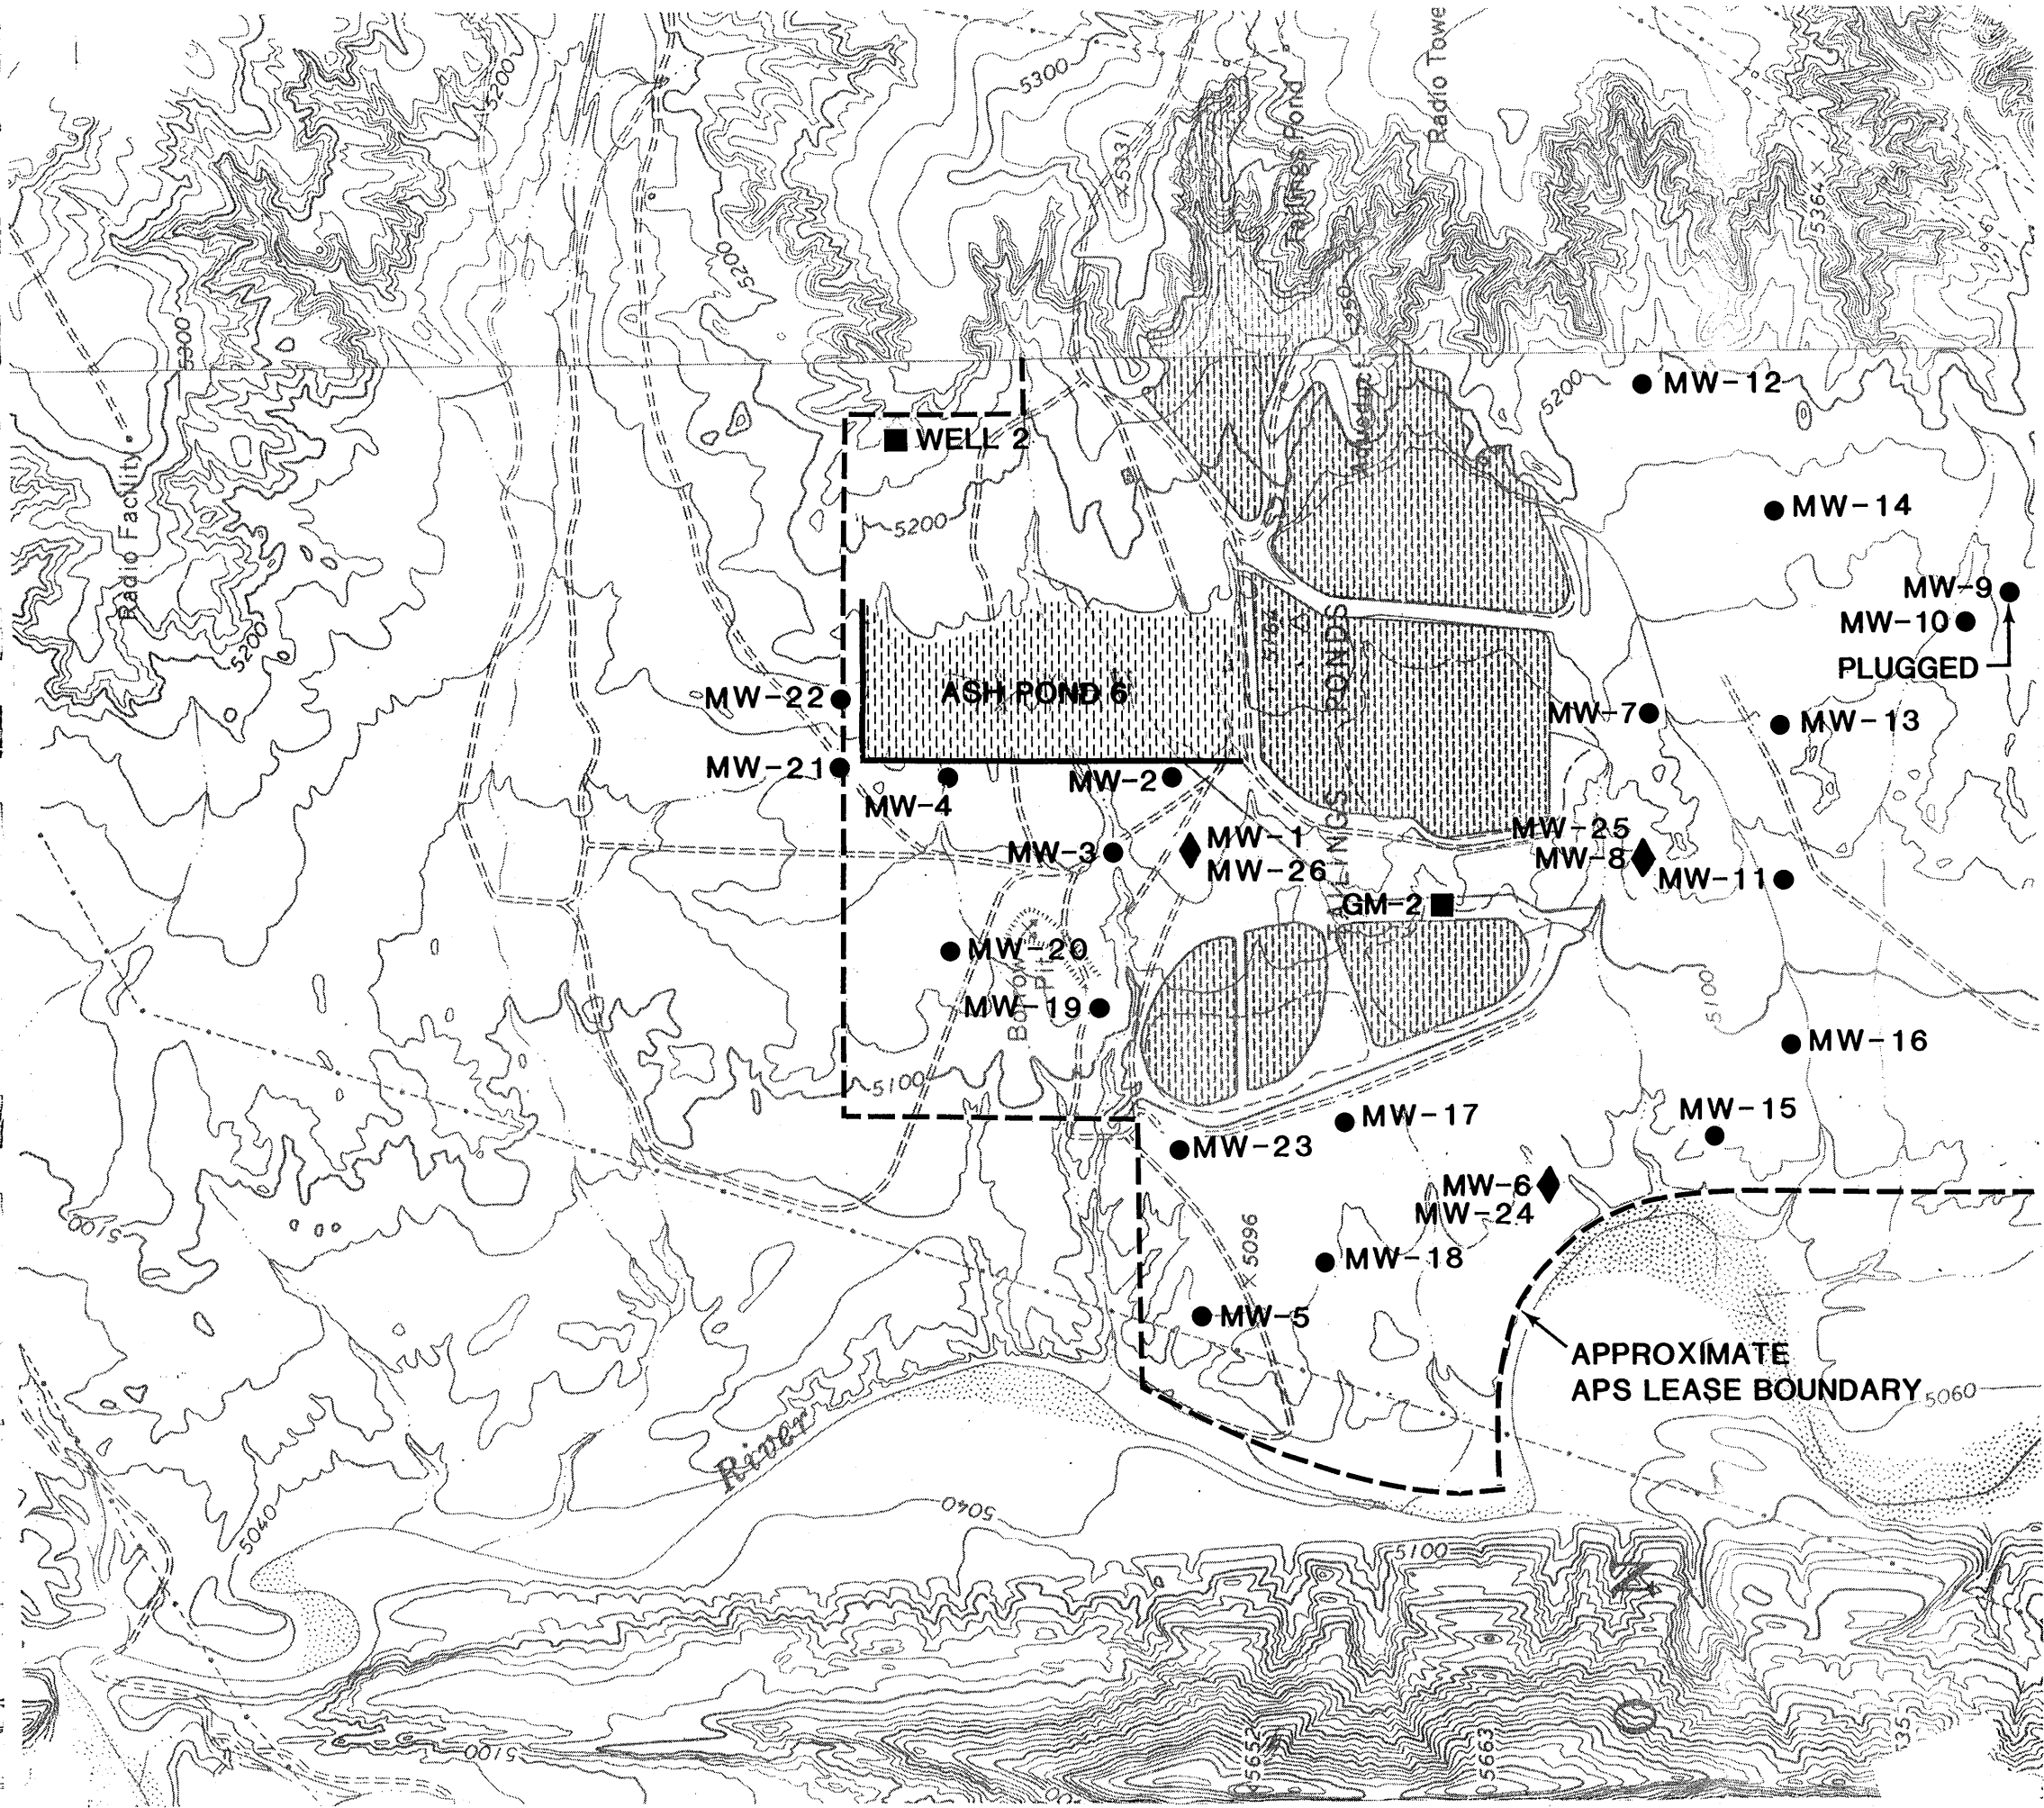

**LEGEND**

- MONITOR WELL INSTALLED BY DAMES & MOORE FROM MARCH 11 THROUGH MARCH 13, 1987 AND AUGUST 31 THROUGH SEPTEMBER 6, 1987
- MONITOR WELL INSTALLED BY OTHERS
- ◆ MULTIPLE COMPLETION MONITOR WELL INSTALLED BY DAMES & MOORE FROM AUGUST 31 THROUGH SEPTEMBER 6, 1987 IN WEATHERED AND UNWEATHERED SHALE

NOTE: CONTOUR INTERVAL 20 FEET

**MONITOR WELL  
LOCATION MAP**  
Figure 1


APPENDIX

WELL COMPLETION LOGS

# WELL COMPLETION LOG

SURFACE ELEVATION 5137.05(e) FT.

MEASURING POINT 5138.85(e) FT.

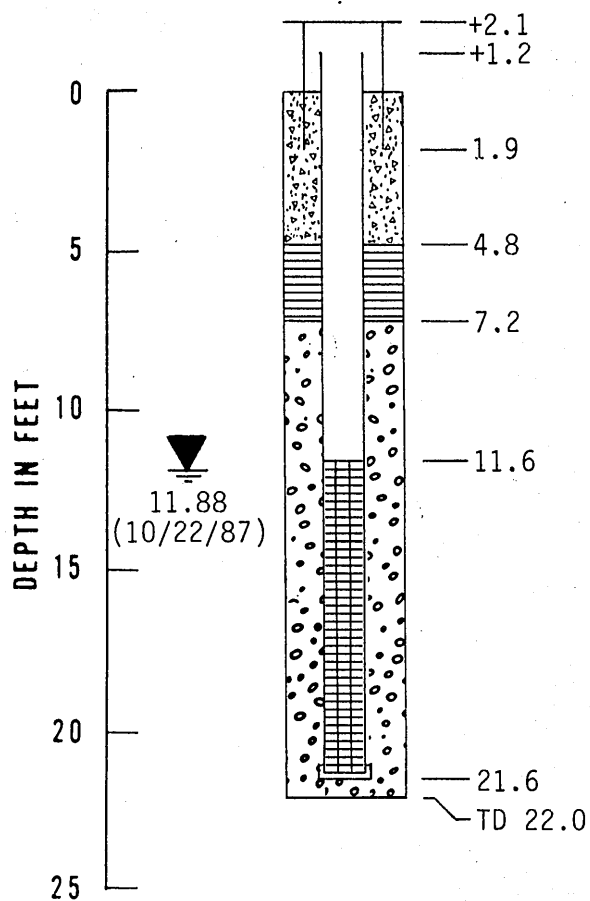


BORING MW-1

# WELL COMPLETION LOG

SURFACE ELEVATION 5147.93 FT.

MEASURING POINT 5149.43 FT.

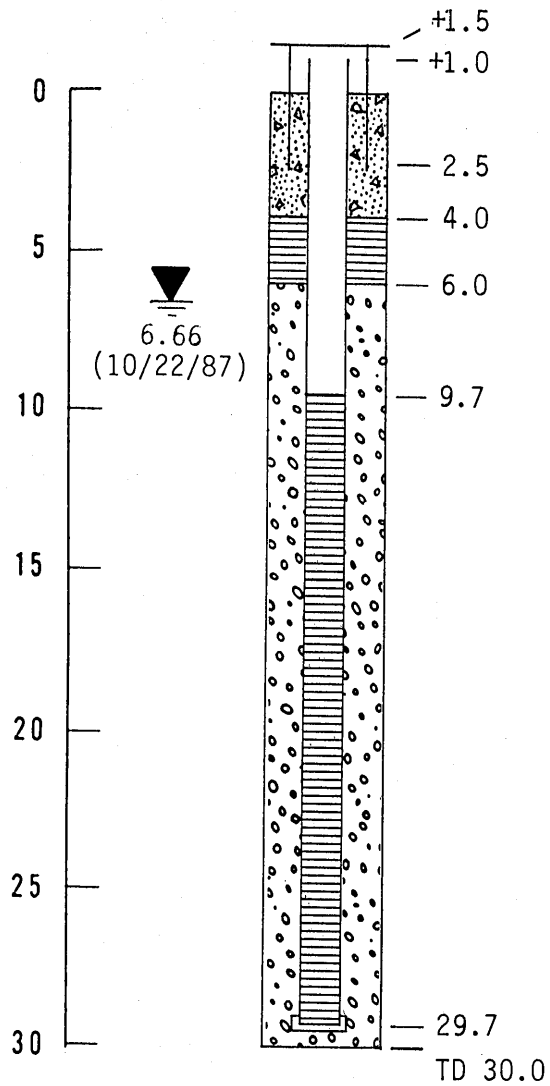


BORING MW-2



WELL COMPLETION LOG

SURFACE ELEVATION 5124.06 FT.  
MEASURING POINT 5125.81 FT.

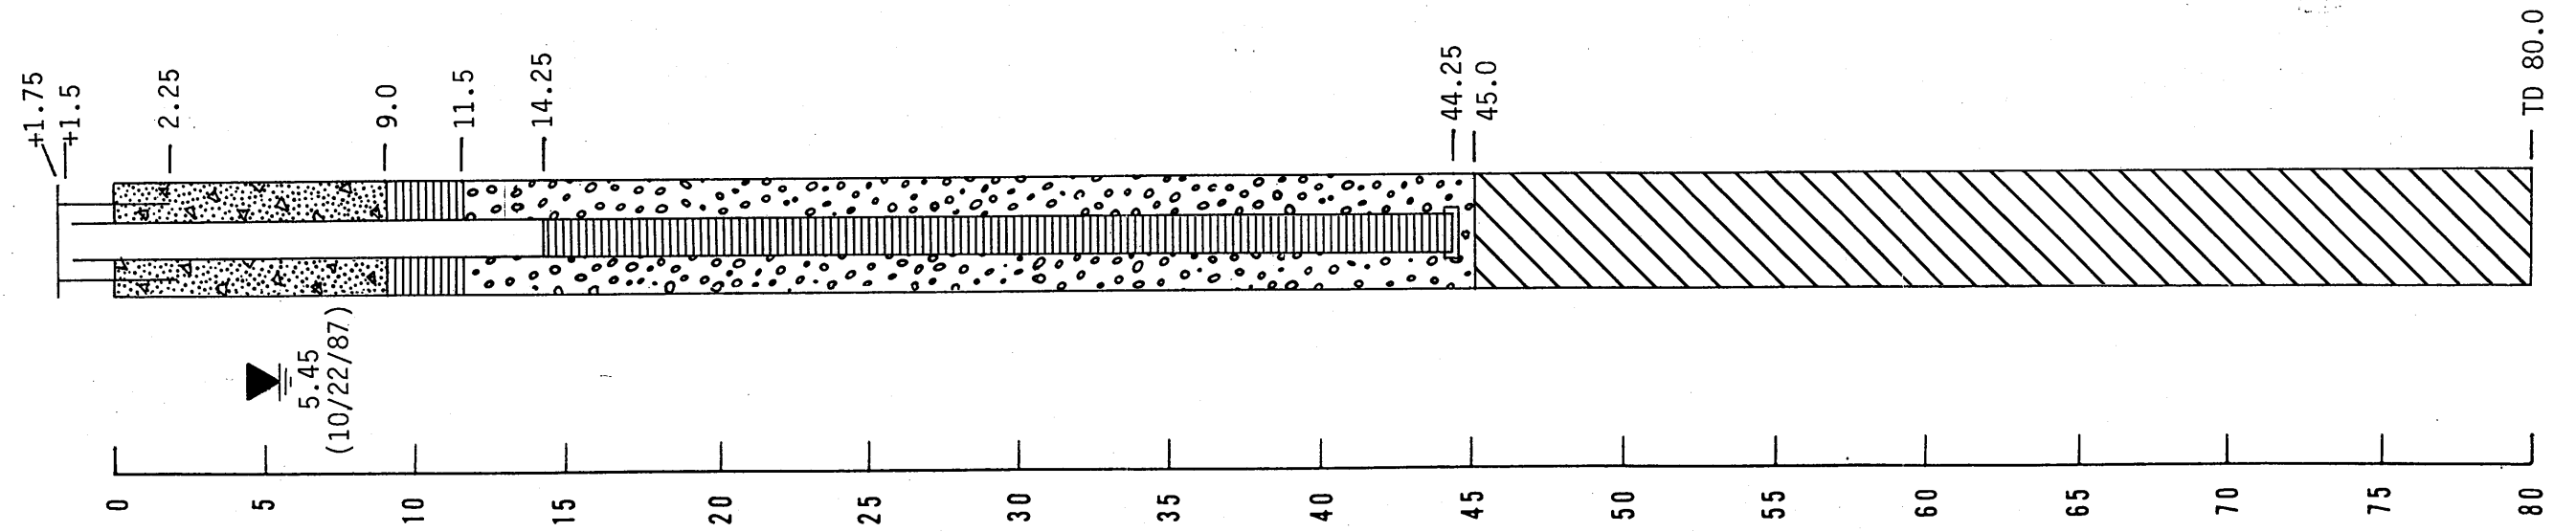


BORING MW-3

# WELL COMPLETION LOG

SURFACE ELEVATION 5146.38 FT.


MEASURING POINT 5147.88 FT.

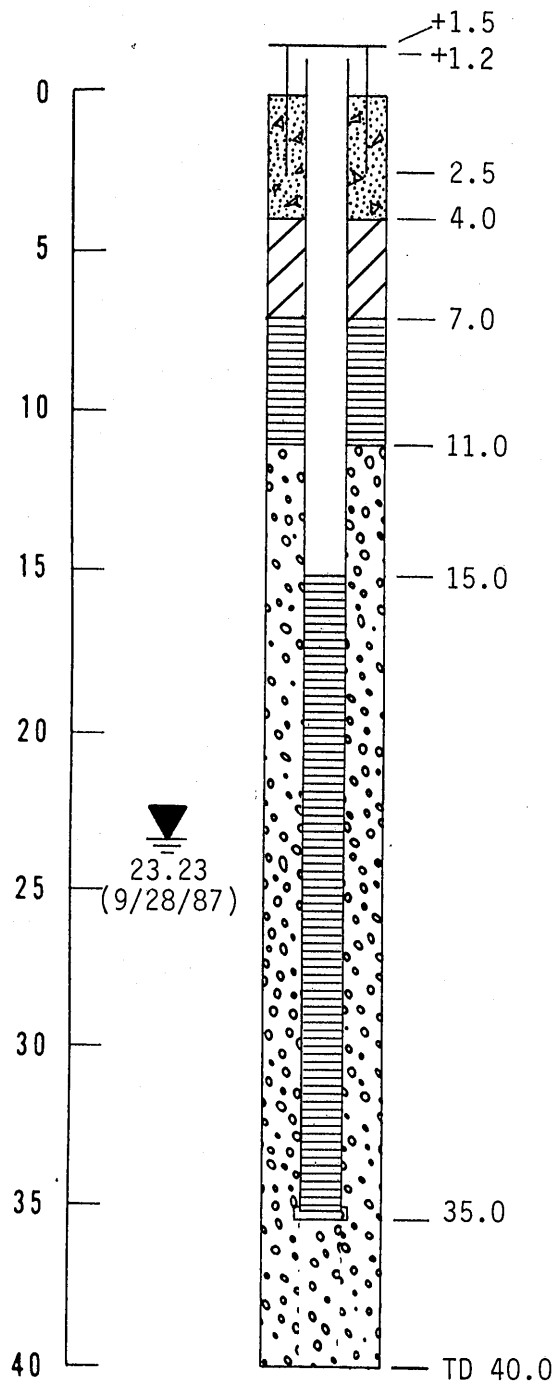

BORING MW-4


WELL COMPLETION LOG

SURFACE ELEVATION 5084.45 FT.  
MEASURING POINT 5086.45 FT.

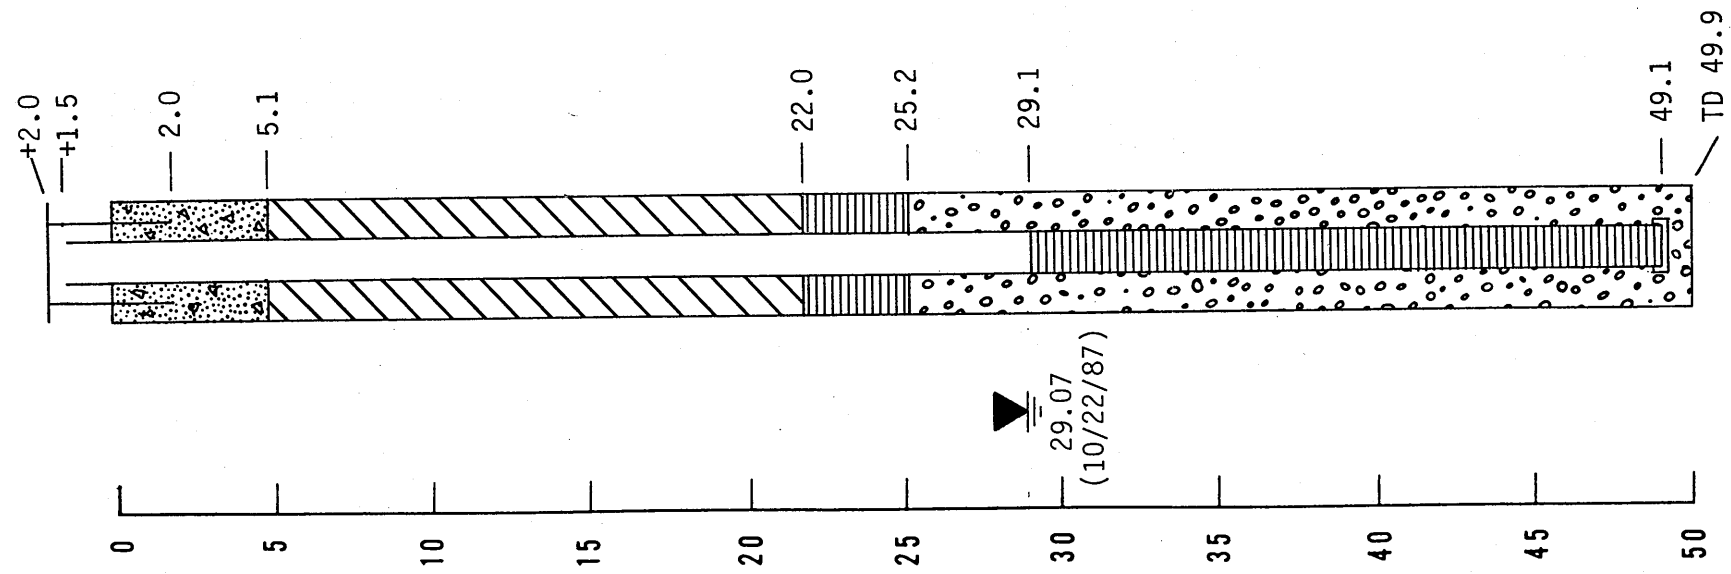

WELL COMPLETION LOG

SURFACE ELEVATION 5078.20 FT.  
MEASURING POINT 5079.70 FT.

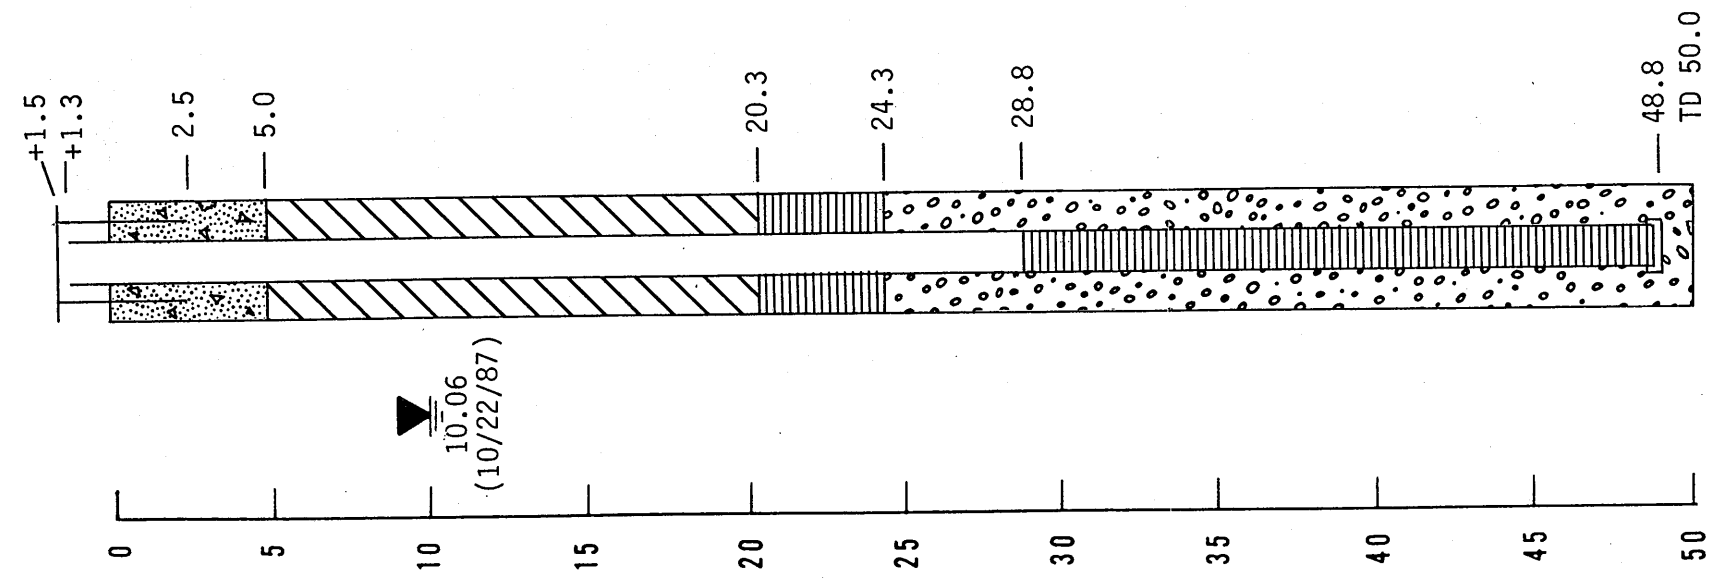




# WELL COMPLETION LOG

SURFACE ELEVATION 5146.62 FT.


MEASURING POINT 5148.52 FT.

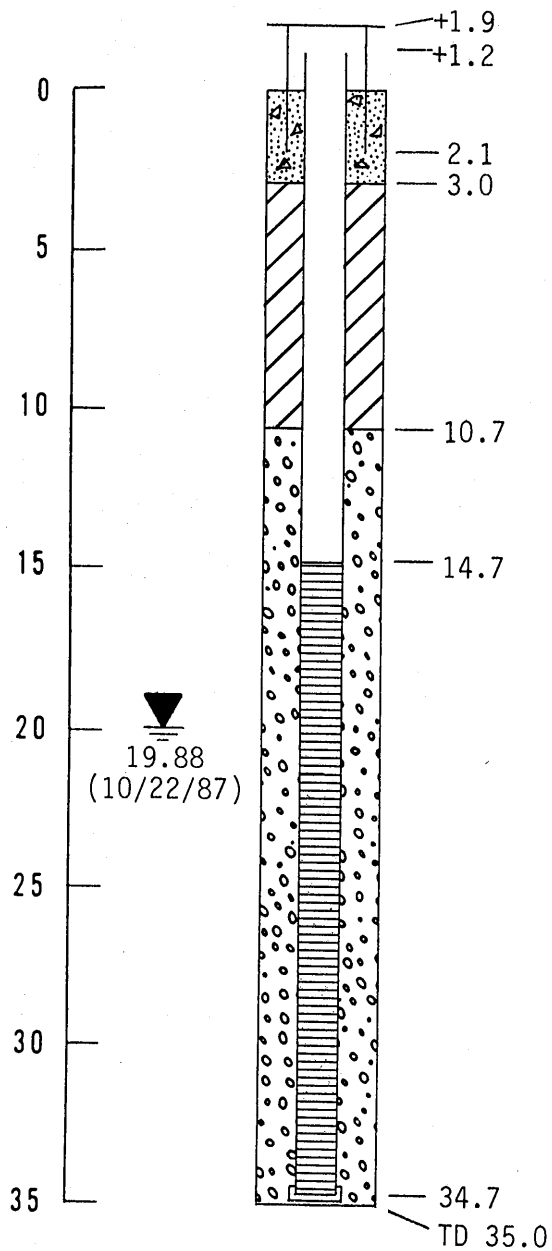

BORING MW-7


WELL COMPLETION LOG

SURFACE ELEVATION 5118.95 FT.  
MEASURING POINT 5120.95 FT.

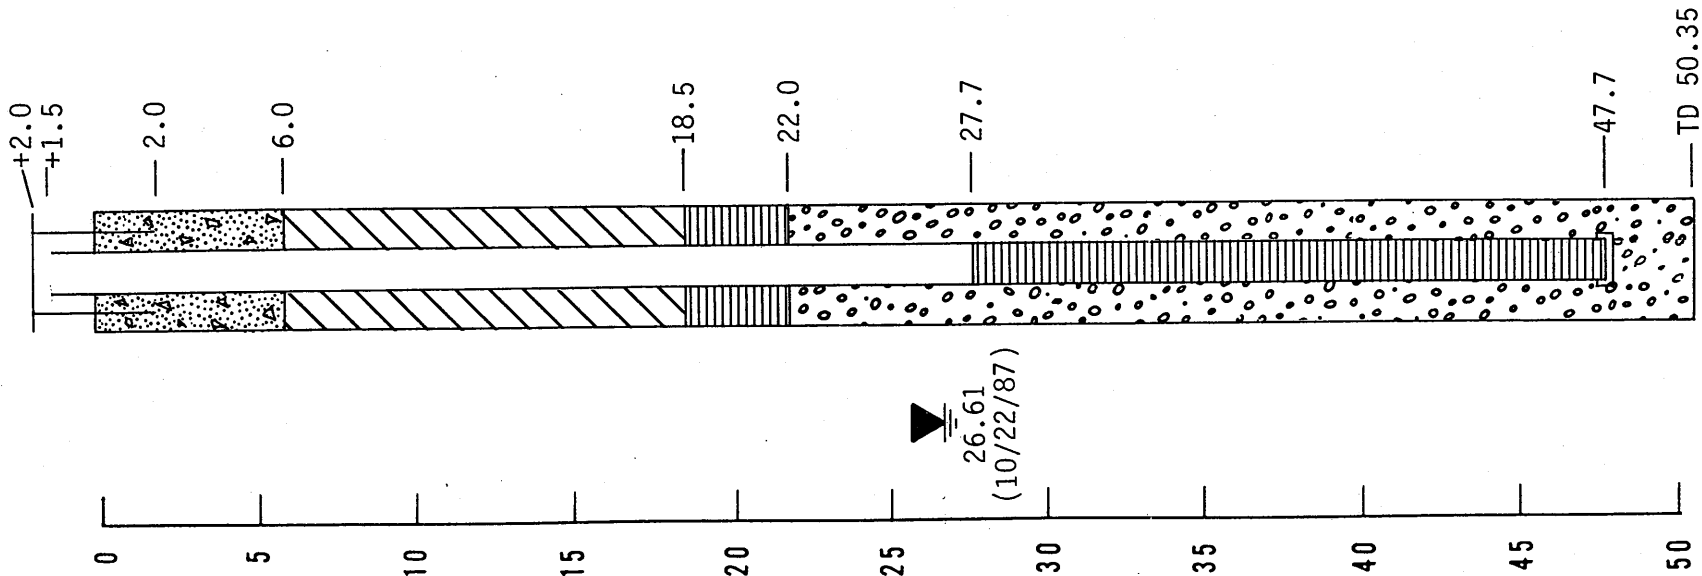

# WELL COMPLETION LOG


SURFACE ELEVATION 5147.38 FT.  
MEASURING POINT 5148.88 FT.

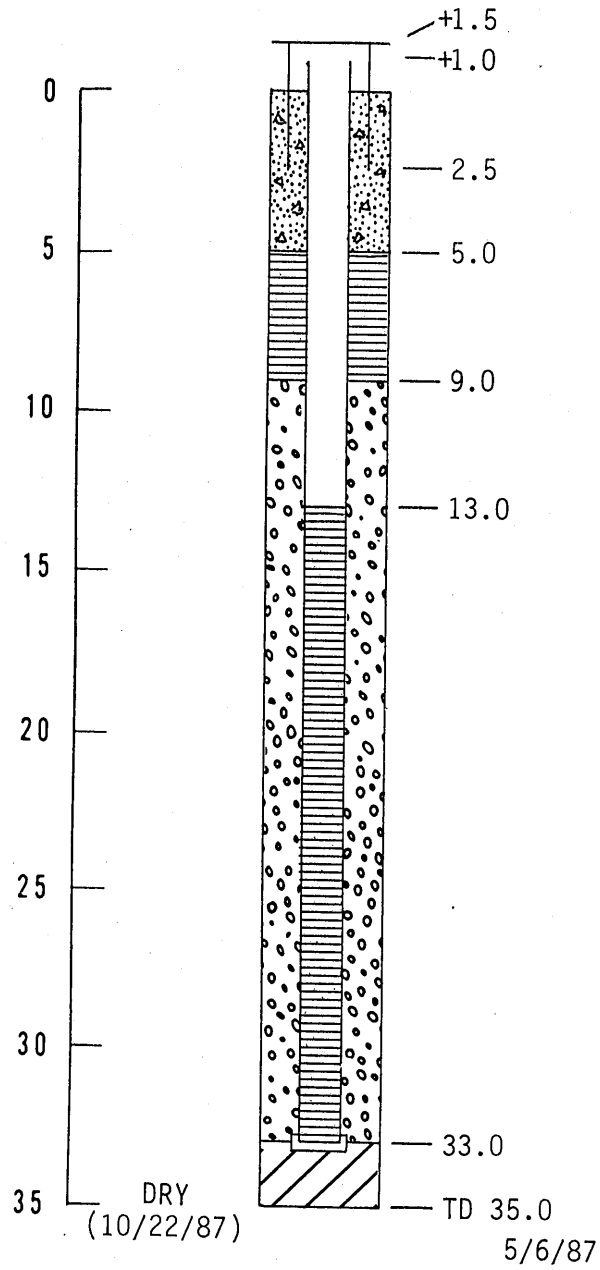

BORING MW-10

WELL COMPLETION LOG


SURFACE ELEVATION 5109.01 FT.  
MEASURING POINT 5111.31 FT.

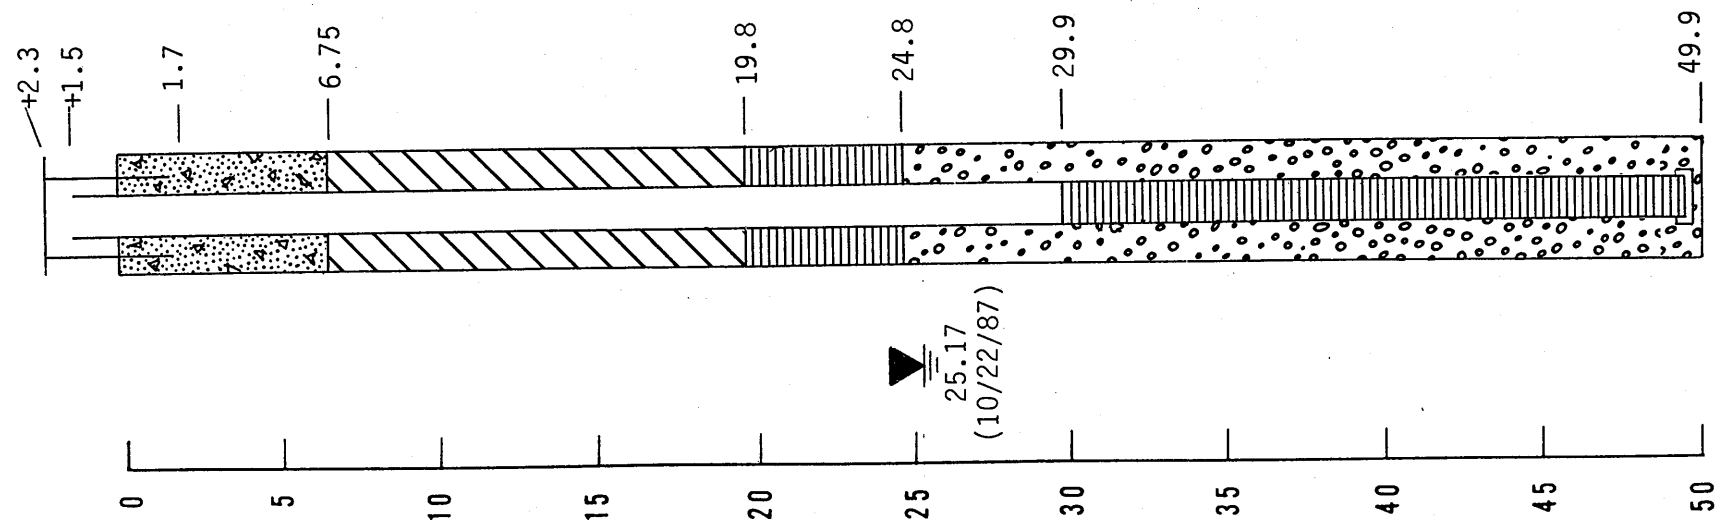

# WELL COMPLETION LOG

SURFACE ELEVATION 5196.63 FT.

MEASURING POINT 5198.43 FT.

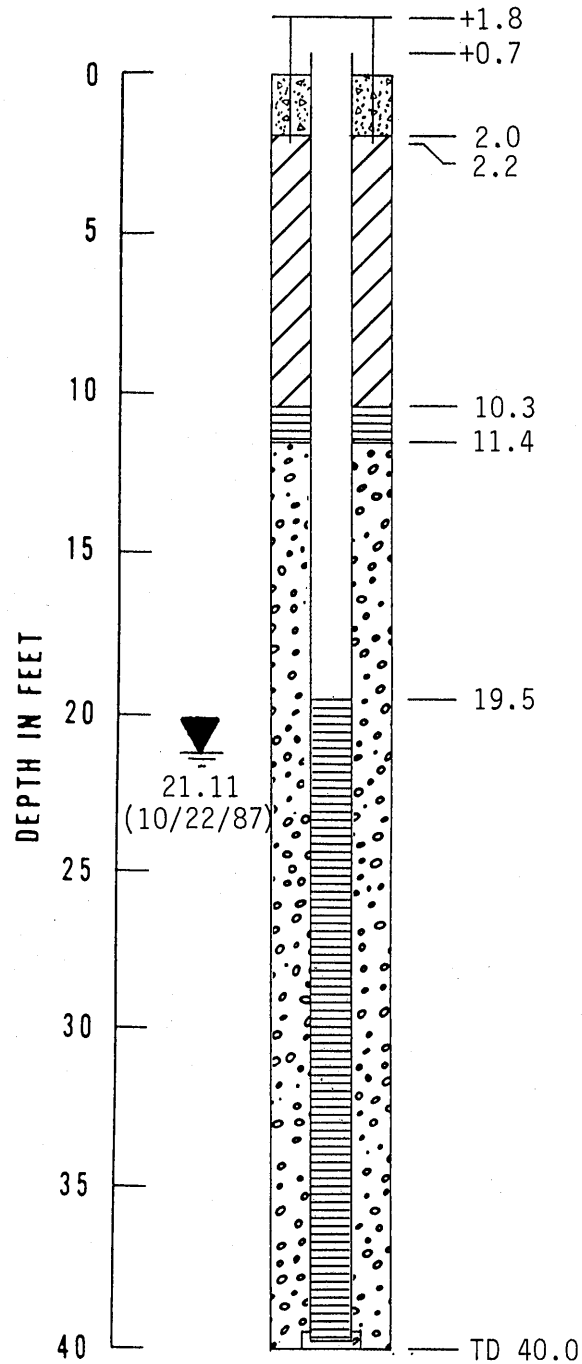


BORING MW-12



# WELL COMPLETION LOG


SURFACE ELEVATION 5147.39 FT.  
MEASURING POINT 5149.14 FT.

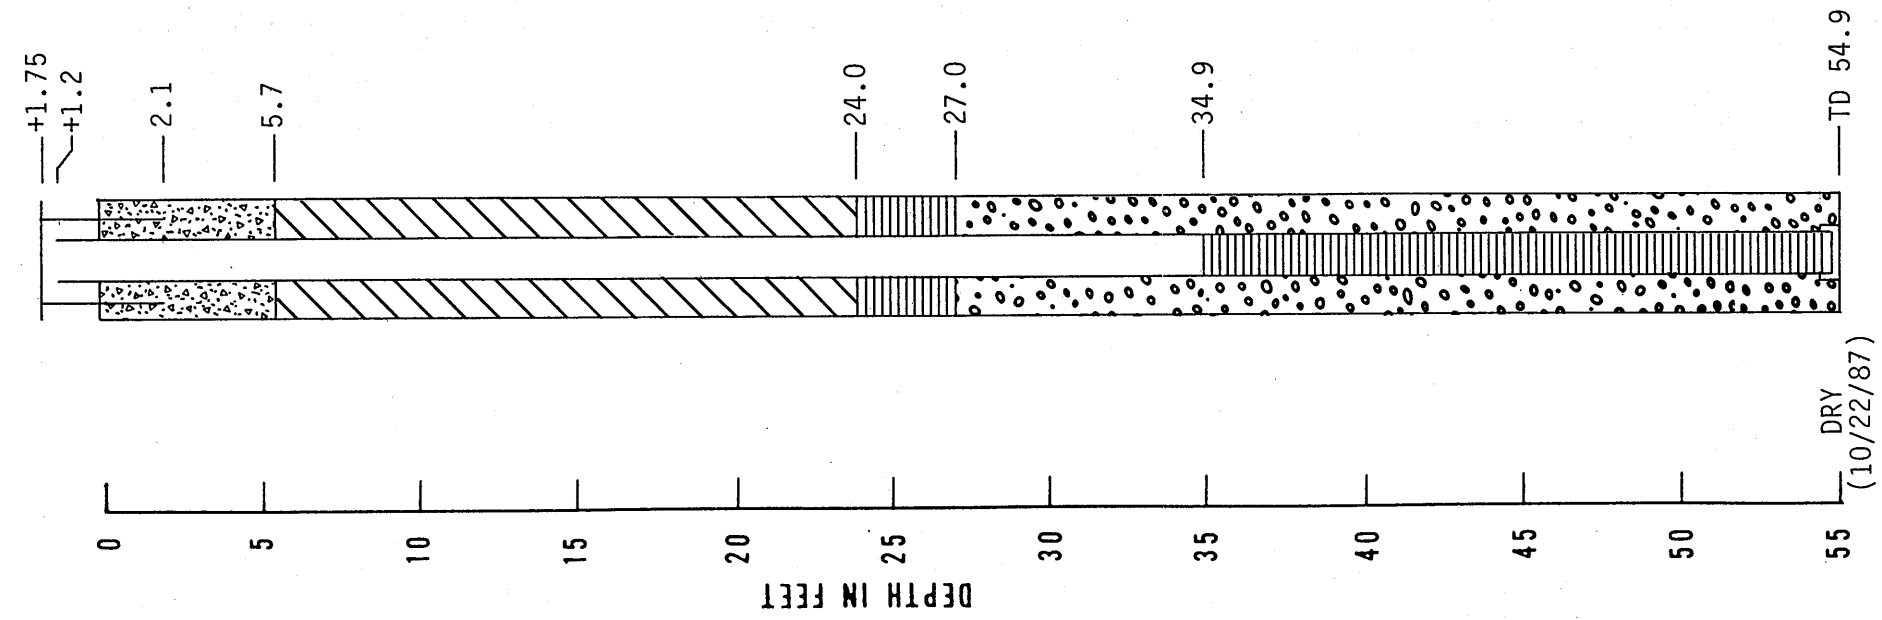

# WELL COMPLETION LOG

SURFACE ELEVATION 5177.28 FT.


MEASURING POINT 5179.31 FT.

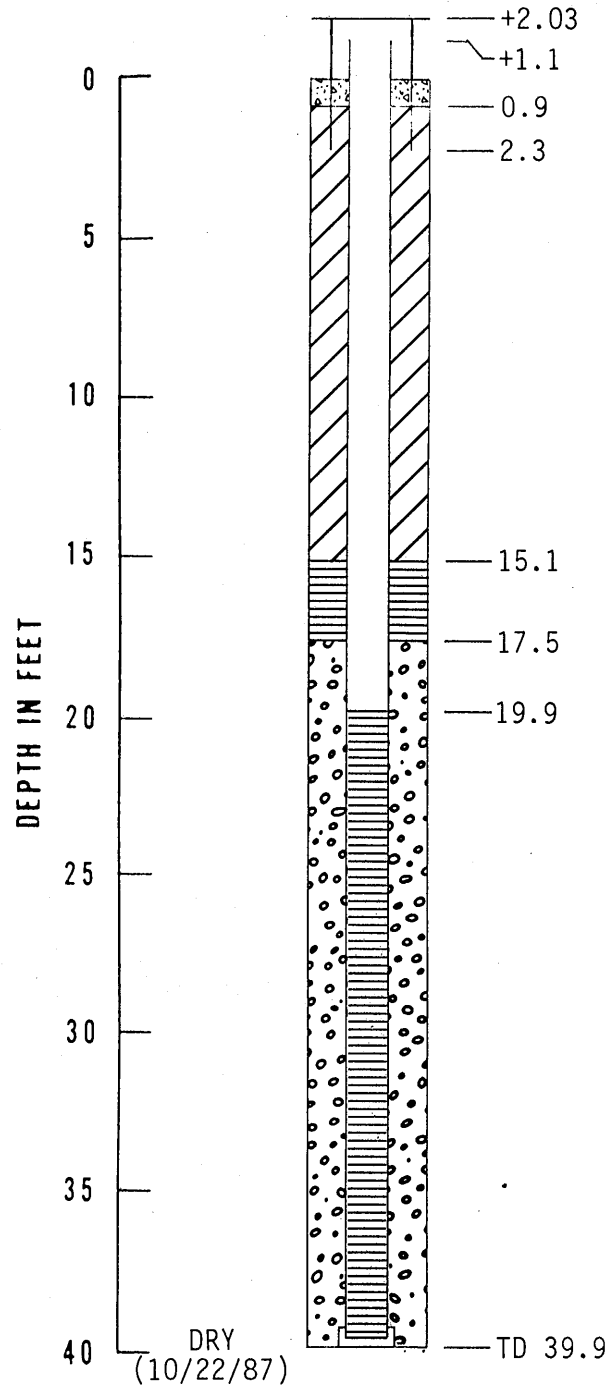

BORING MW-14


WELL COMPLETION LOG

SURFACE ELEVATION 5089.86 FT.  
MEASURING POINT 5091.46 FT.

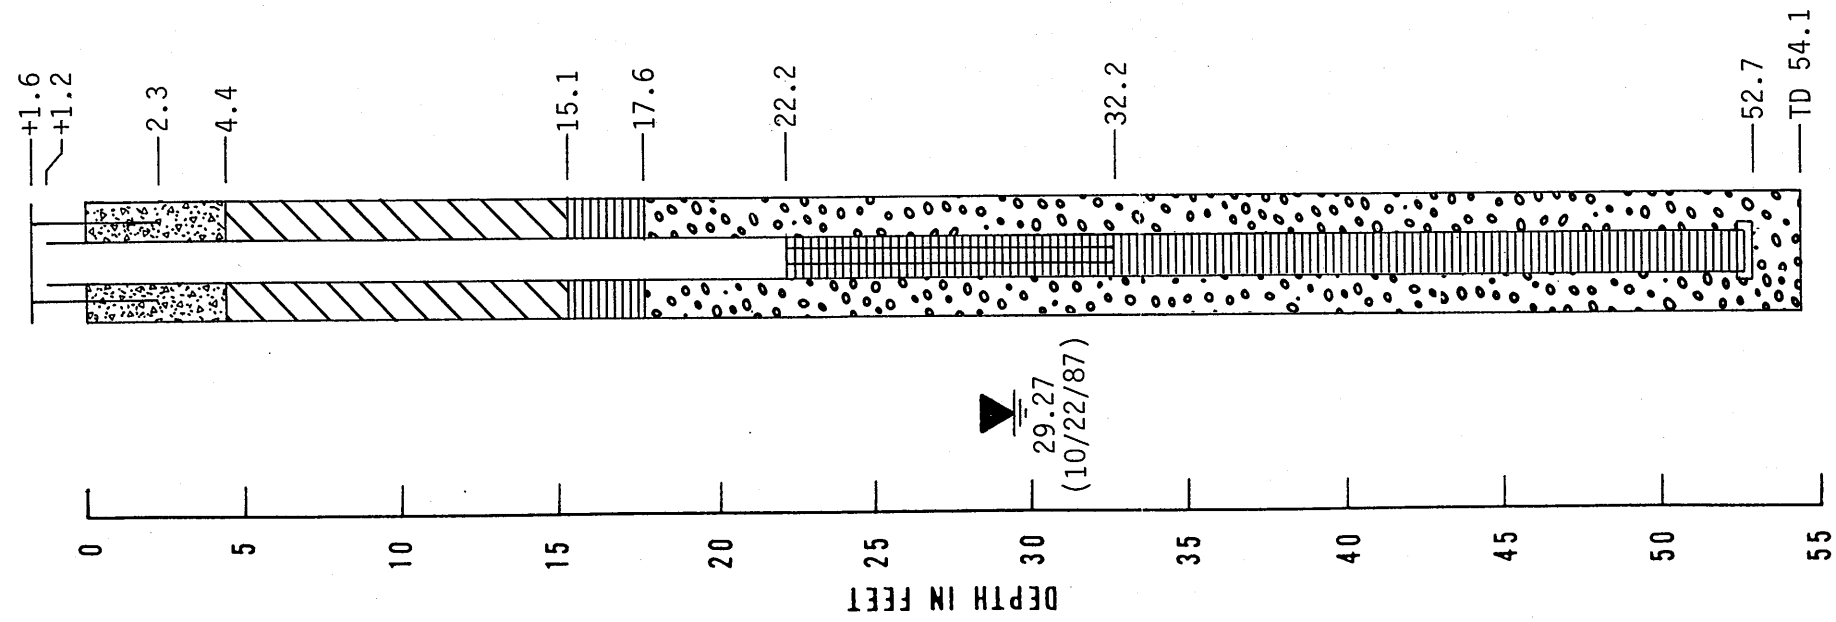

WELL COMPLETION LOG

SURFACE ELEVATION 5096.44 FT.  
MEASURING POINT 5099.94 FT.

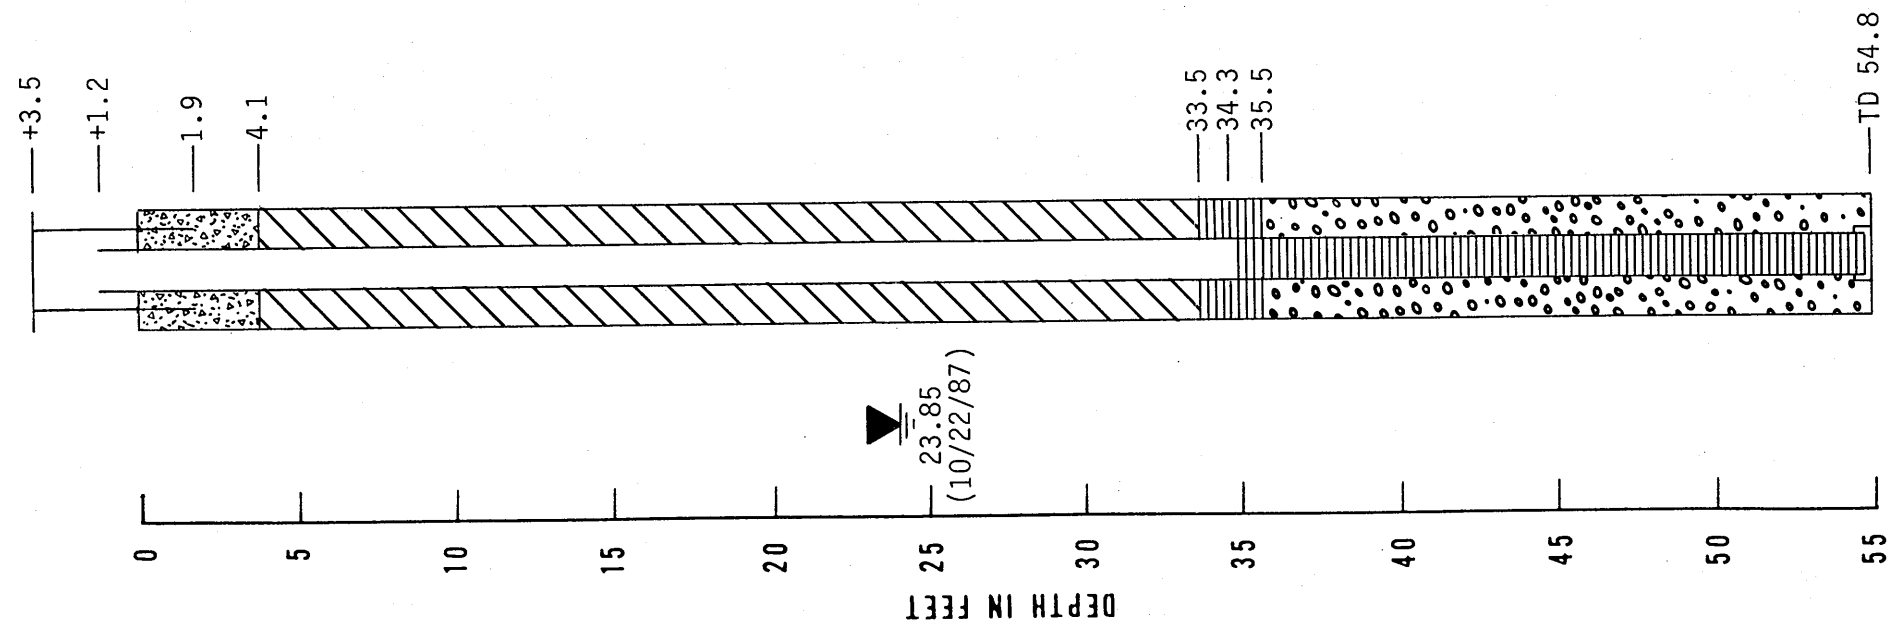




# WELL COMPLETION LOG

SURFACE ELEVATION 5092.03 FT.


MEASURING POINT 5094.78 FT.

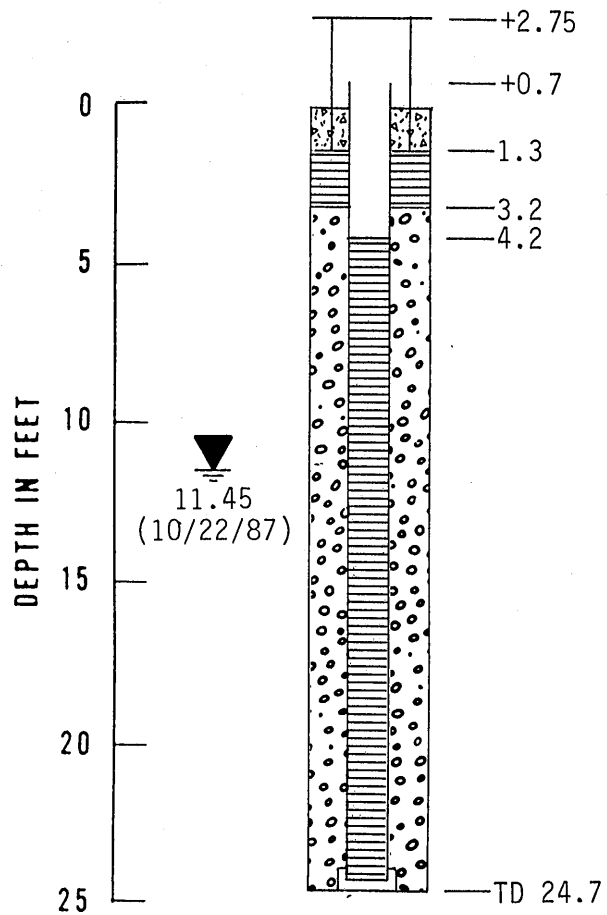

BORING MW-17


WELL COMPLETION LOG

SURFACE ELEVATION 5085.78 FT.  
MEASURING POINT 5087.48 FT.

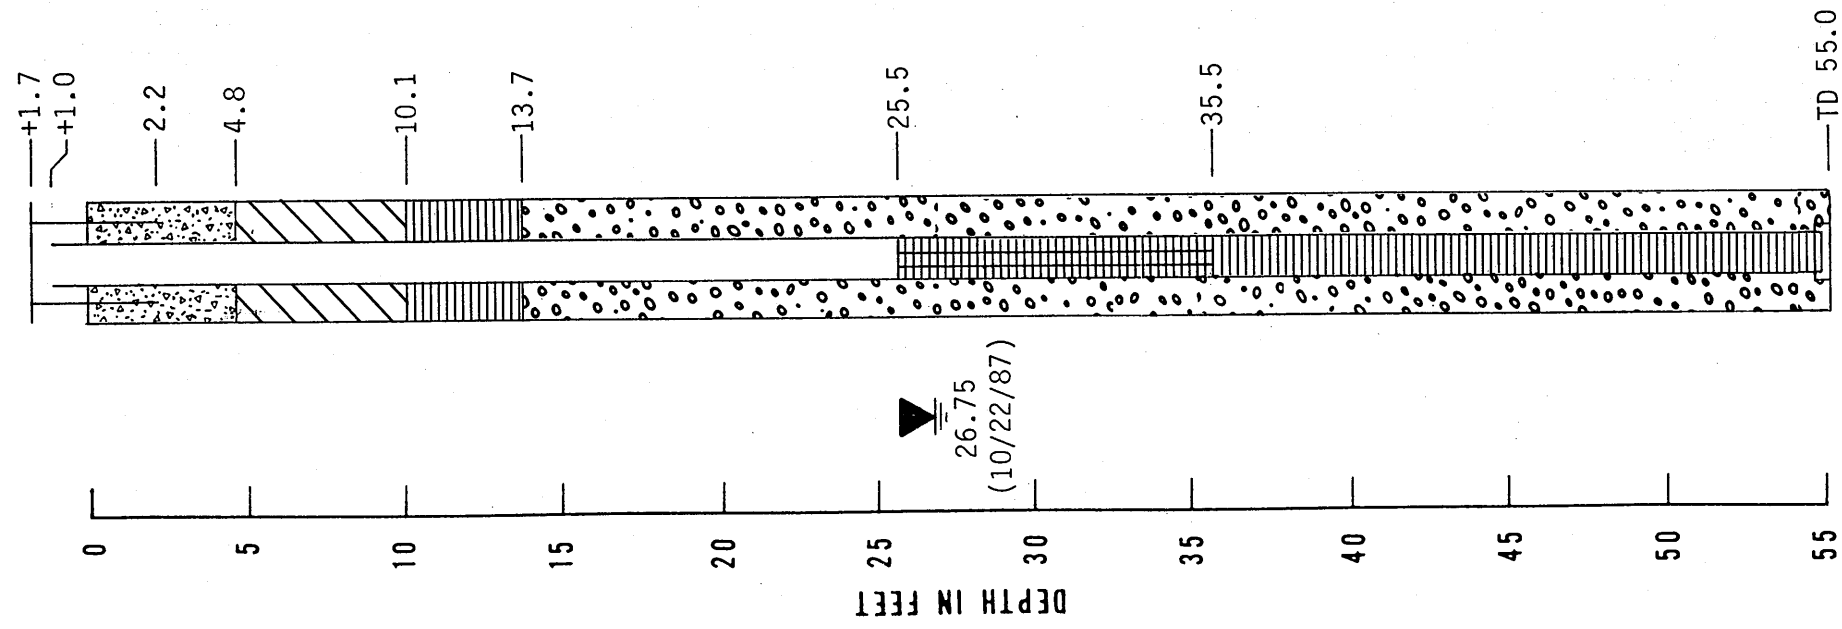

WELL COMPLETION LOG


SURFACE ELEVATION 5123.73 FT.  
MEASURING POINT 5125.78 FT.

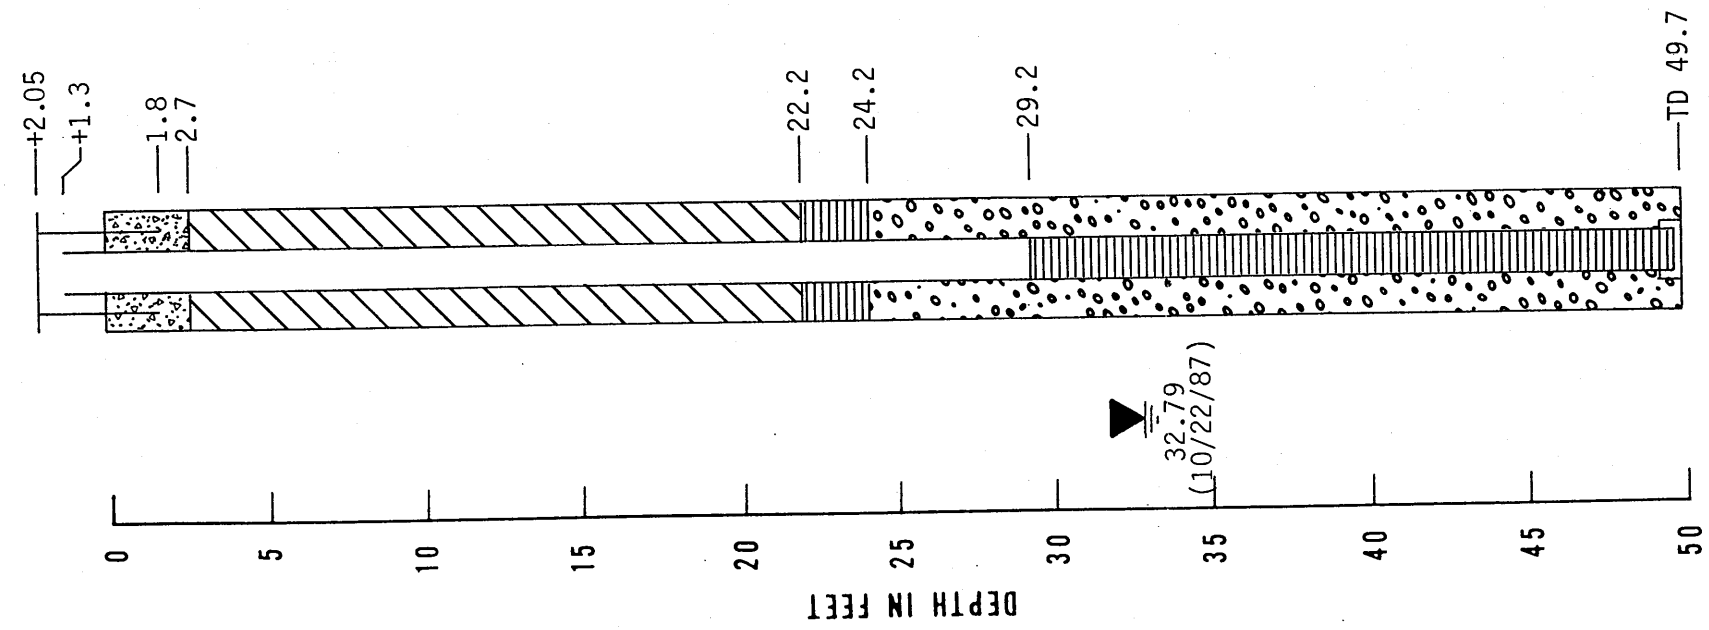

# WELL COMPLETION LOG

SURFACE ELEVATION 5125.63 FT.

MEASURING POINT 5128.33 FT.

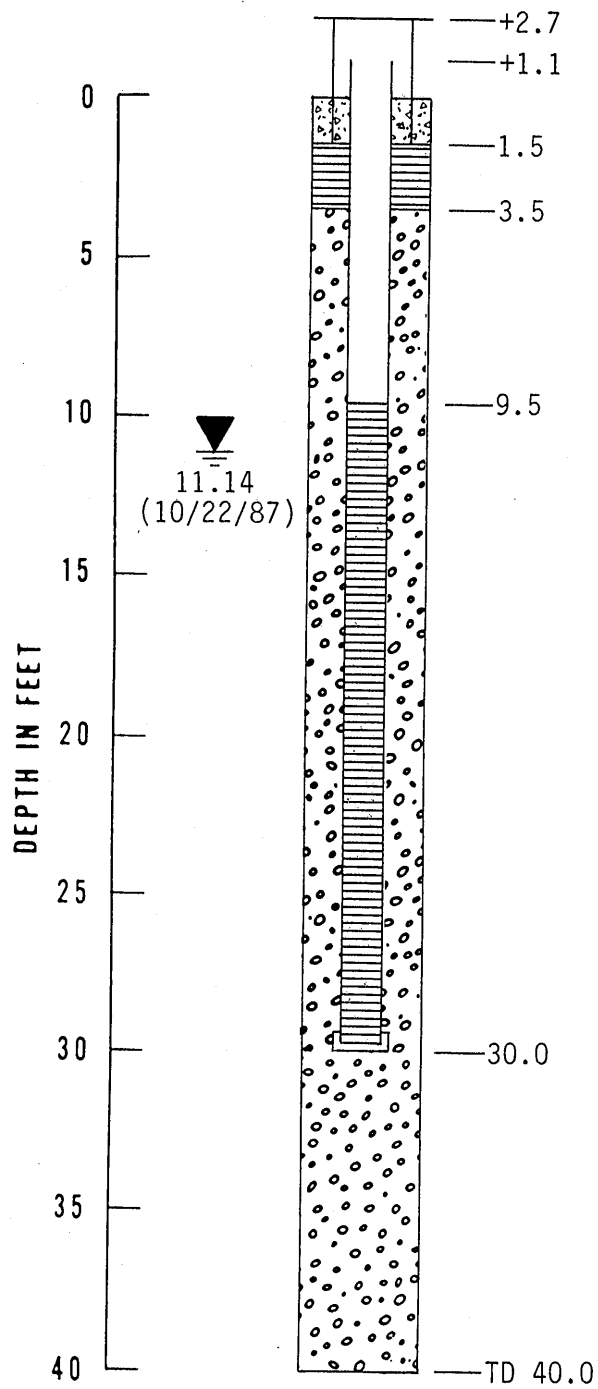


BORING MW-20



# WELL COMPLETION LOG

SURFACE ELEVATION 5150.95 FT.

MEASURING POINT 5153.05 FT.

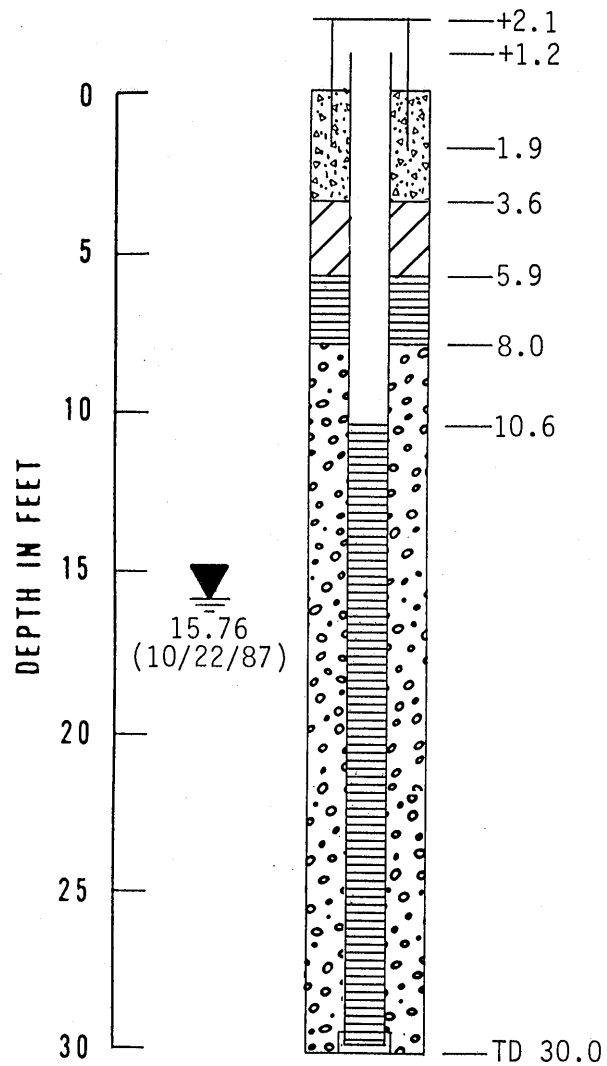


BORING MW-21

# WELL COMPLETION LOG

SURFACE ELEVATION 5152.38 FT.


MEASURING POINT 5154.48 FT.

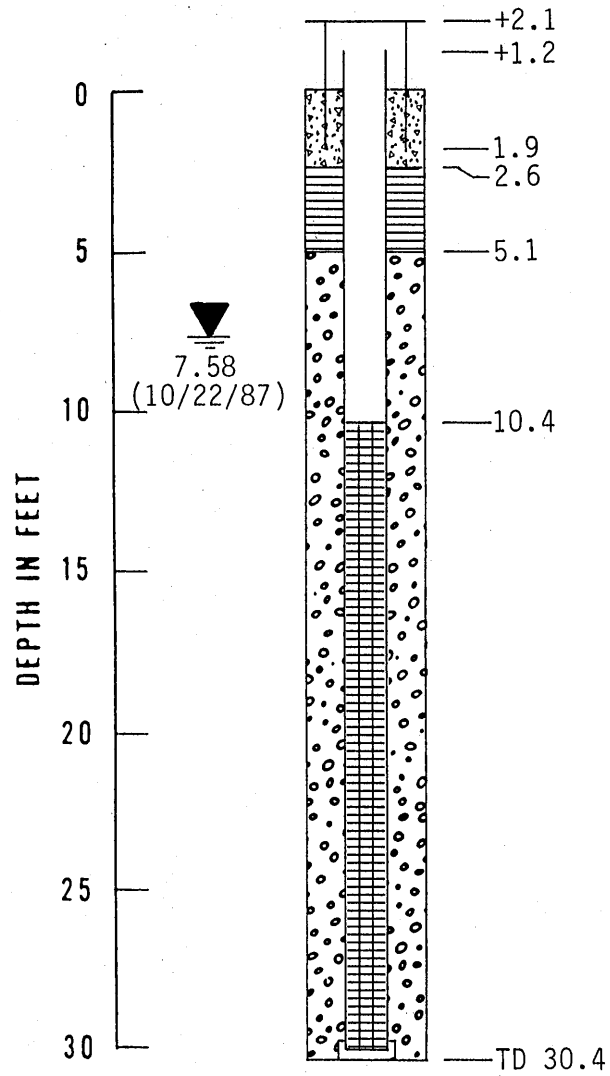

BORING MW-22


WELL COMPLETION LOG

SURFACE ELEVATION 5094.56 FT.  
MEASURING POINT 5096.66 FT.

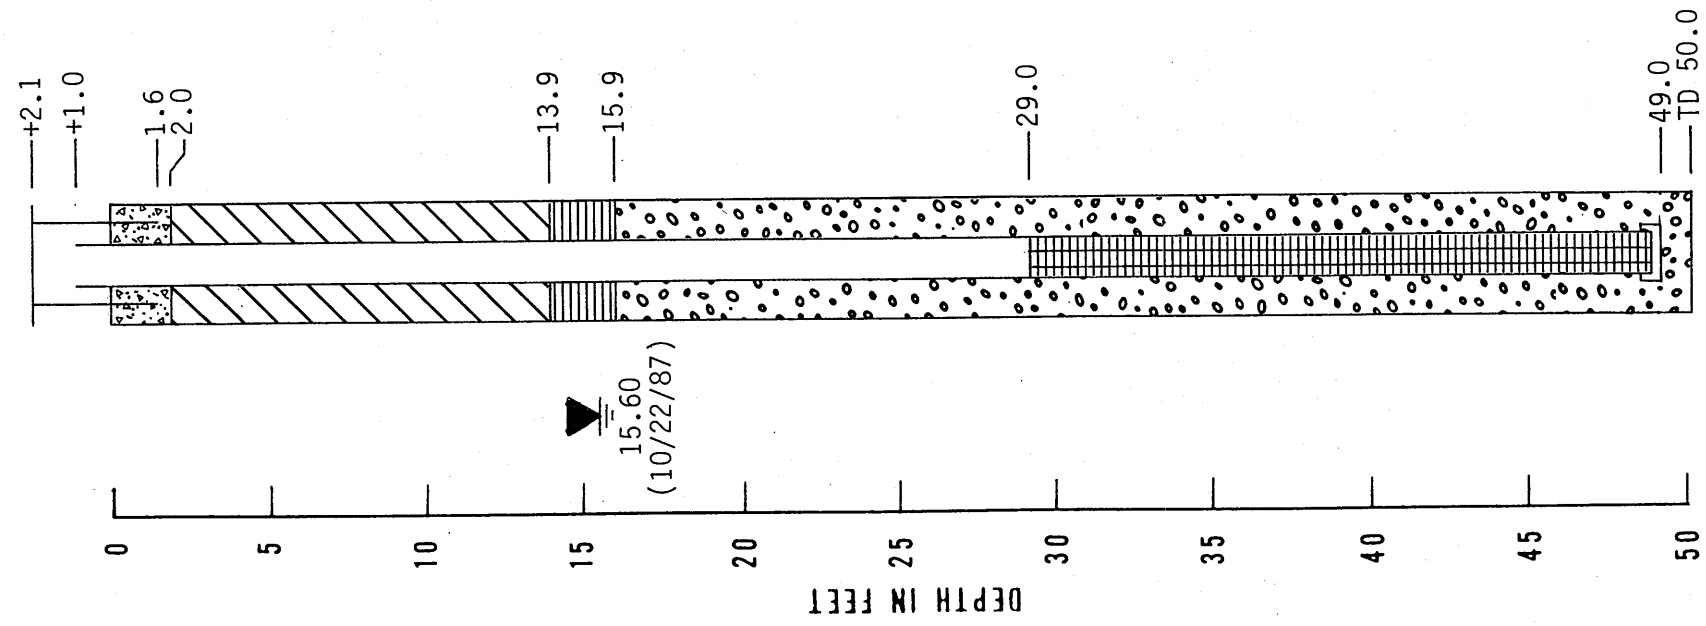


WELL COMPLETION LOG

SURFACE ELEVATION 5078.02 FT.  
MEASURING POINT 5079.89 FT.

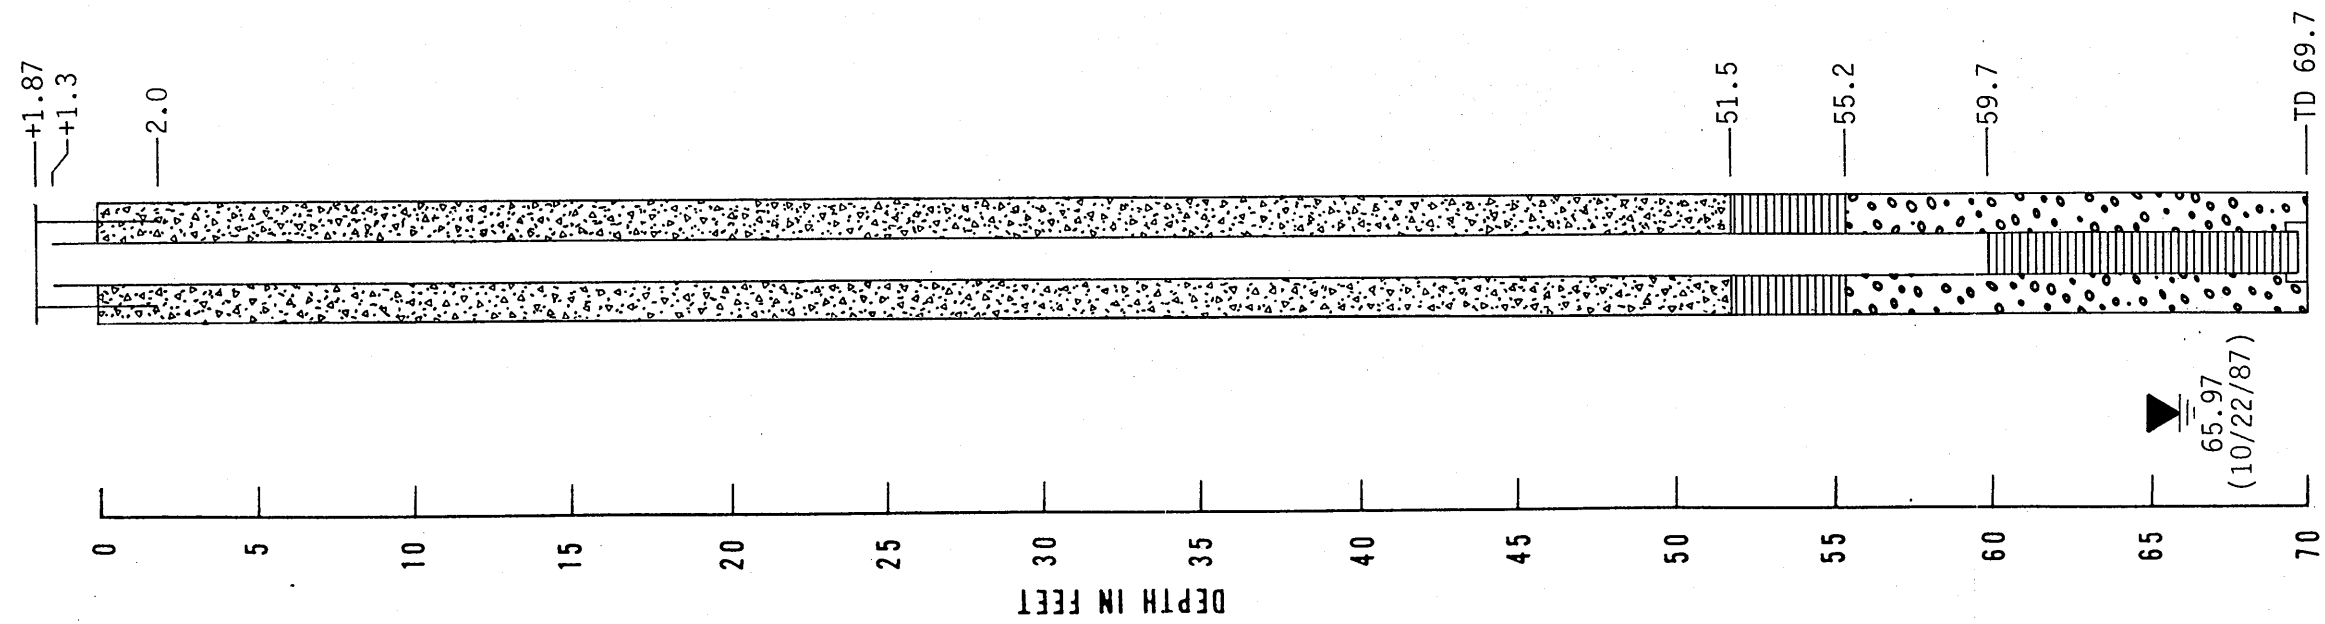

WELL COMPLETION LOG


SURFACE ELEVATION 5119.50 FT.  
MEASURING POINT 5121.55 FT.

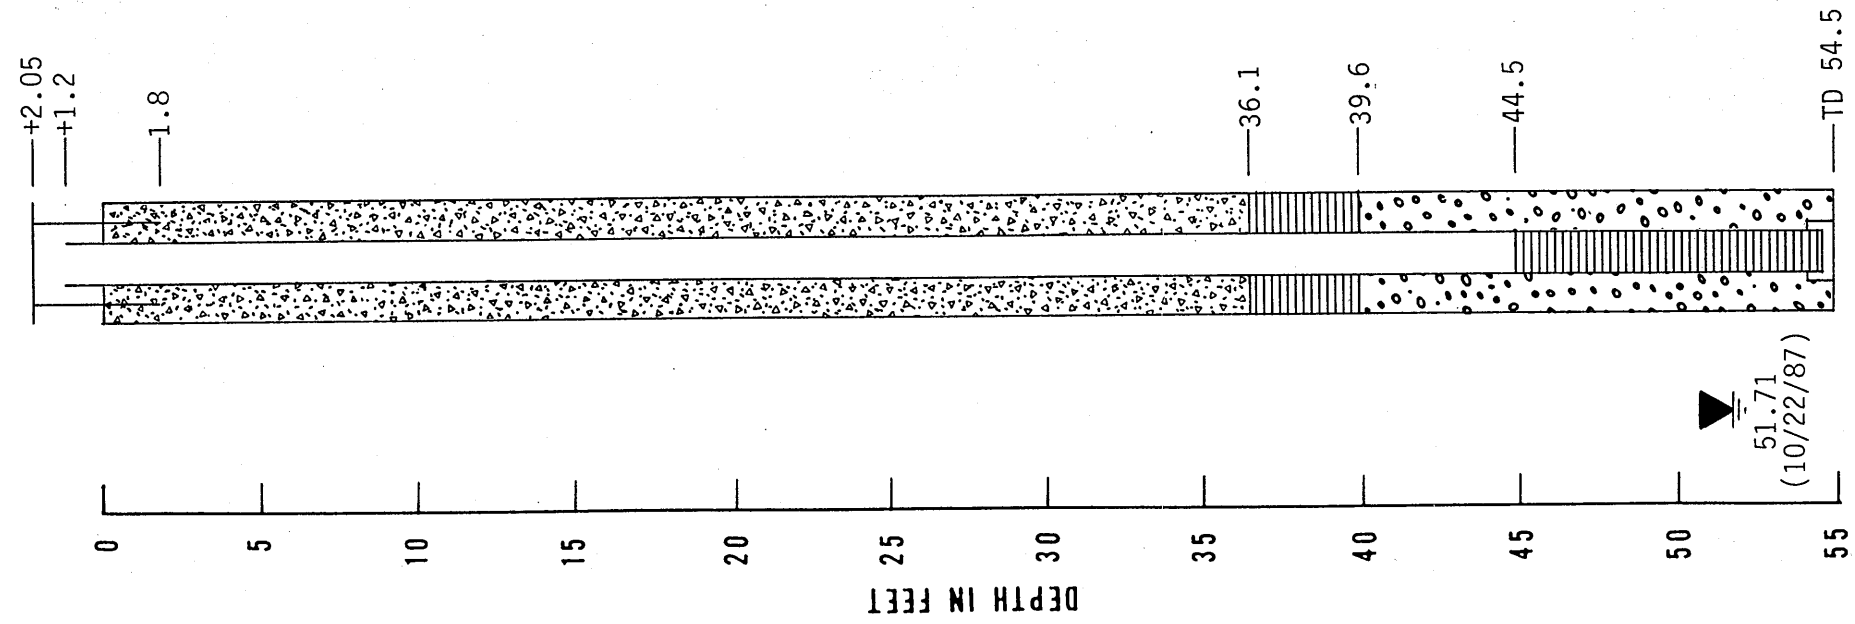



WELL COMPLETION LOG

SURFACE ELEVATION 5137.05 FT.  
MEASURING POINT 5138.85 FT.

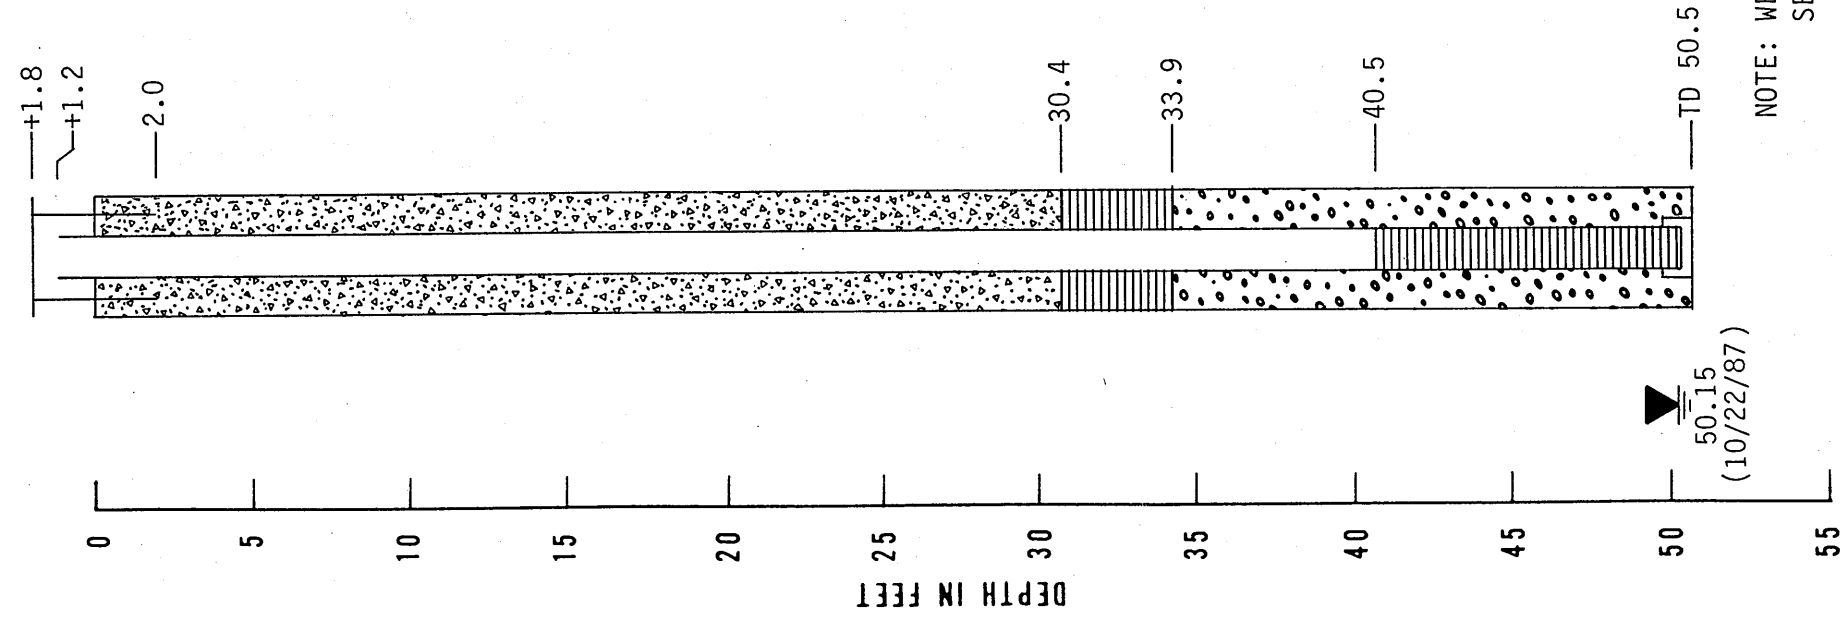

NOTE: WELL SCREEN IS HAND SLOTTED  
SEE TEXT FOR DESCRIPTION.

LABORATORY TEST DATA													
SAMPLER TYPE	INCHES RECOVERED	INCHES DRIVEN	SAMPLE DEPTH	SAMPLE NO.	TESTS REPORTED ELSEWHERE	ATTEBERG LIMITS		MOISTURE CONTENT (%)	DRY DENSITY (PCF)	SHEAR STRENGTH TX/100 (PSF)			
						LIQUID LIMIT (%)	PLASTICITY INDEX (%)						
0													
5													
10													
15													
20													
25													
30													
35													
40													
45													
50													
55													
60													
65													
70													
75													
80													

**BORING DMX-1**  
 SURFACE ELEVATION: 5097.7  
 N2071750  
 E299030

SAMPLES

SYMBOLS DESCRIPTION

	SC	BROWN FINE SAND WITH CLAY
	GW	BROWN WELL GRADED GRAVEL WITH A TRACE OF FINE SAND (PARTICLES TO PEA SIZE)
		BROWN HEAVILY WEATHERED SHALE
		DARK GREY UNWEATHERED SHALE

NOTES:  
 BORING TERMINATED AT 45 FEET ON 4/15/92.  
 MONITORING WELL INSTALLED, SEE PLATE 18  
 GROUNDWATER NOT DISCERNABLE DURING DRILLING.  
 COORDINATES AND ELEVATION ARE ESTIMATED.  
 SURVEY DATA TO BE PROVIDED LATER.

## LOG OF BORING

APS FOUR CORNERS  
 02353-118-022

E299060

## SAMPLES

DESCRIPTION

DARK GREY UNWEATHERED SHALE

BY

### Plate A12

E298360

## SAMPLES

DESCRIPTION

BROWN FINE SAND WITH CLAY

BROWN WELL GRADED GRAVELS WITH TRACE OF FINE SAND (PARTICLES TO PEA SIZE)

BROWN HEAVILY WEATHERED SHALE

DARK GREY UNWEATHERED SHALE

NOTES:  
BORING TERMINATED AT 45 FEET ON 4/14/92.  
MONITORING WELL INSTALLED. SEE PLATE 20  
GROUNDWATER NOT DISCERNABLE DURING DRILLING.  
COORDINATES AND ELEVATION ARE ESTIMATED.  
SURVEY DATA TO BE PROVIDED LATER.

**APS FOUR CORNERS**  
**02353-118-022**

### Plate A13

## E297860

## SAMPLES

DESCRIPTION

BROWN FINE SAND WITH CLAY

BROWN HEAVILY WEATHERED SHALE

BROWN WELL GRADED GRAVELS WITH TRACE OF FINE SAND (PARTICLES TO PEA SIZE)

DARK GREY UNWEATERED SHALE

NOTES:  
BORING TERMINATED AT 60 FEET ON 4/15/92.  
MONITOR WELL INSTALLED, SEE PLATE 21  
GROUNDWATER NOT DISCERNABLE DURING DRILLING.  
COORDINATES AND ELEVATION ARE ESTIMATED.  
SURVEY DATA TO BE PROVIDED LATER.

**APS FOUR CORNERS**  
**02353-118-022**



E298645

## SAMPLES

NOTES:  
BORING TERMINATED AT 60 FEET ON 4/15/92.  
MONITOR WELL INSTALLED. SEE PLATE 22  
GROUNDWATER NOT DISCERNABLE DURING DRILLING.  
COORDINATES AND ELEVATION ARE ESTIMATED.  
SURVEY DATA TO BE PROVIDED LATER.

**APS FOUR CORNERS**  
**02353-118-022**

E298710

## SAMPLES

[illegible]

BROWN FINE SAND WITH CLAY

DARK GREY UNWEATHERED SHALE

BY  **DAMES & MOORE** Plate A16



Job No. 02353-118-022

Survey Coords: N2071750  
E299030

Elevation Ground Level 5097.7

Top of Casing 5099.2

### Construction Time Log:

Total Depth 45 FEET  
Borehole Diameter NOMINAL 8-INCH  
Casing Stick-up Height + 1 FEET  
Driller MO-TE DRILLING INC.  
FARMINGTON, N.M.

Rig 1500 GARDNER-DENVER AIR ROTARY  
Bit(s) 7 7/8-INCH BUTTON ROCK BIT

Drilling Fluid "QUICK FOAM"

Protective Casing 6-INCH STEEL WITH LOCKING CAP

### Well Design & Specifications:

Basis: Geologic Log X Geophysical Log \_\_\_\_\_  
Casing String (s): C = Casing S = Screen.

Depth	String(s)	Elevation
+1 — 19	C1	— —
19 — 39	S1	— —
— —	END CAP	— —
— —		— —
— —		— —

Casing: C1 4-INCH, SCH 40 PVC, BLANK,  
FLUSH-THREADED.

C2 \_\_\_\_\_

Screen: S1 4-INCH, SCH 40 PVC, 0.020-INCH SLOT,  
FLUSH-THREADED.

S2\_\_\_\_\_

Filter Pack: WASHED PEA GRAVEL FROM 45 FEET TO  
14 FEET.

Grout Seal: REDI-MIX CEMENT FROM 11 FEET TO  
SURFACE.

Bentonite Seal: 1/4-INCH PELLETS FROM 14 FEET TO 11 FEET.

Construction Time Log:

Task	Start		Finish	
	Date	Time	Date	Time
Drilling	4-15-92	07:40	4-15-92	08:17
Geophys. Logging:				
Casing:	4-15-92	09:30	4-15-92	09:40
Filter Placement:	4-15-92	09:40	4-15-92	09:55
Cementing:	4-15-92	10:10	4-15-92	10:25
Development:	4-16-92	14:45	4-16-92	15:45


**Well Development:**

WELL DEVELOPED BY AIR LIFT METHODS ON  
4-16-92.

**Stabilization Test Data:**

Time	pH	Spec. Cond.	Temp (C)

## Recovery Data:
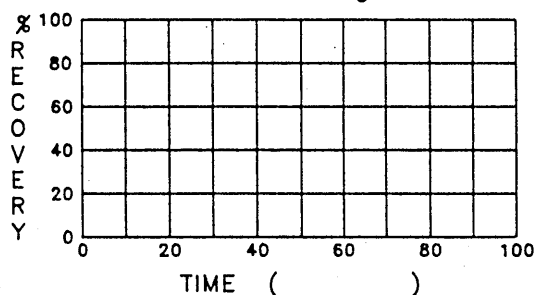
$$Q \equiv$$
$$S_0 =$$


Comments: SURVEY COORDINATES, ELEVATION GROUND LEVEL AND TOP OF CASING ARE ESTIMATED. SURVEY DATA TO BE PROVIDED LATER.

SITE NAME APS FOUR CORNERS S.E.S.

LOCATION CHAC0 WASH INTERCEPT

SUPERVISED BY DAVID GORDON

DATE 4-17-92



DMX-2

02353-118-022

## MONITOR WELL CONSTRUCTION SUMMARY

E299060

Elevation Ground Level 5094.8

Top of Casing 5096.0

### Drilling Summary:

**Total Depth 55 FEET**

Borehole Diameter NOMINAL 8-INCH

Casing Stick-up Height: +1 FEET

Driller MO-TE DRILLING INC.

FARMINGTON, N.M.

Rig 1500 GARDNER-DENVER AIR ROTARY

Bit(s) 7 7/8-INCH BUTTON ROCK BIT

### Drilling Fluid "QUICK FOAM"

Protective Casing 6-INCH STEEL WITH LOCKING CAP

### Well Design & Specifications:

Basis: Geologic Log   X   Geophysical Log         
Casing String (s): C = Casing S = Screen.

Depth	String(s)	Elevation
+1 — 15.5	C1	— —
15.5 — 35.5	S1	— —
— —	END CAP	— —
— —		— —
— —		— —
— —		— —

Casing: C1 4-INCH, SCH 40 PVC, BLANK,  
FLUSH-THREADED.

C2

Screen: S1 4-INCH, SCH 40 PVC, 0.020-INCH SLOT,  
FLUSH-THREADED.

S2

Filter Pack: #10/20 SILICA SAND FROM 30 FEET TO  
8 FEET. SLUFF FROM 55 FEET TO 30  
FEET.

Grout Seal: REDI-MIX CEMENT FROM 6.5 FEET TO  
SURFACE.

Bentonite Seal: 1/4-INCH PELLETS FROM 8 FEET TO 6.5 FEET.

Construction Time Log:

Task	Start		Finish	
	Date	Time	Date	Time
Drilling	4-14-92	09:00	4-14-92	10:00
Geophys. Logging:				
Casing:	4-14-92	10:45	4-14-92	10:55
Filter Placement:	4-14-92	11:05	4-14-92	16:15
Cementing:	4-15-92	06:45	4-15-92	07:00
Development:	4-16-92	12:40	4-16-92	14:40
	4-17-92	13:00	4-17-92	13:30


**Well Development:**

WELL DEVELOPED BY AIR LIFT METHODS ON  
4-16-92 AND 4-17-92.

### Stabilization Test Data:

Time	pH	Spec. Cond.	Temp (C)

## Recovery Data:
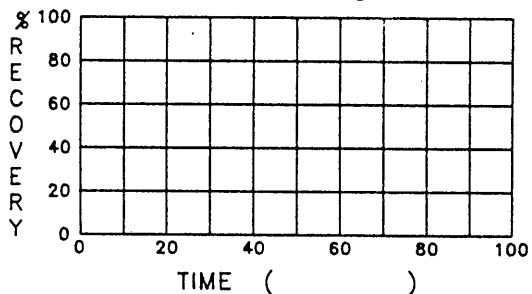
$$Q \equiv$$
$$S_0 =$$


Comments: SURVEY COORDINATES, ELEVATION GROUND LEVEL AND TOP OF CASING ARE ESTIMATED. SURVEY DATA TO  
BE PROVIDED LATER.

SITE NAME APS FOUR CORNERS S.E.S.

LOCATION CHACO WASH INTERCEPT

SUPERVISED BY DAVID GORDON

DATE 4-17-92



Job No. 02353-118-022

Survey Coords: N2070815  
E298360

Elevation Ground Level 5082.5  
Top of Casing 5083.9

**Construction Time Log:**

Total Depth 45 FEET  
Borehole Diameter NOMINAL 8-INCH  
Casing Stick-up Height +1 FEET  
Driller MO-TE DRILLING INC.  
FARMINGTON, N.M.

Rig 1500 GARDNER-DENVER AIR ROTARY  
Bit(s) 7 7/8-INCH BUTTON ROCK BIT

## Drilling Fluid "QUICK FOAM"

Protective Casing 6-INCH STEEL WITH LOCKING CAP

### Well Design & Specifications:

Basis: Geologic Log   X   Geophysical Log         
Casing String (s): C = Casing S = Screen.

Depth	String(s)	Elevation
+1 — 18	C1	— —
18 — 38	S1	— —
— —	END CAP	— —
— —		— —
— —		— —
— —		— —

Casing: C1 4-INCH, SCH 40 PVC, BLANK,  
FLUSH-THREADED.

Screen: S1 4-INCH, SCH 40 PVC, 0.020-INCH SLOT,  
FLUSH-THREADED.

S2 \_\_\_\_\_

Filter Pack: WASHED PEA GRAVEL FROM 45 FEET TO 13 FEET.

Grout Seal: REDI-MIX CEMENT FROM 10.5 FEET TO  
SURFACE.

Bentonite Seal: 1/4-INCH PELLETS FROM 13 FEET TO 10.5 FEET.

Comments: SURVEY COORDINATES, ELEVATION GROUND LEVEL AND TOP OF CASING ARE ESTIMATED. SURVEY DATA TO  
BE PROVIDED LATER.

Task	Start		Finish	
	Date	Time	Date	Time
Drilling	4-14-92	13:15	4-14-92	14:00
Geophys. Logging:				
Casing:	4-14-92	14:15	4-14-92	14:25
Filter Placement:	4-14-92	14:50	4-14-92	15:10
Cementing:	4-14-92	15:25	4-14-92	15:50
Development:	4-16-92	15:45	4-16-92	16:45


**Well Development:**

WELL DEVELOPED BY AIR LIFT METHODS ON  
4-16-92.

**Stabilization Test Data:**

Time	pH	Spec. Cond.	Temp (C)

## Recovery Data:
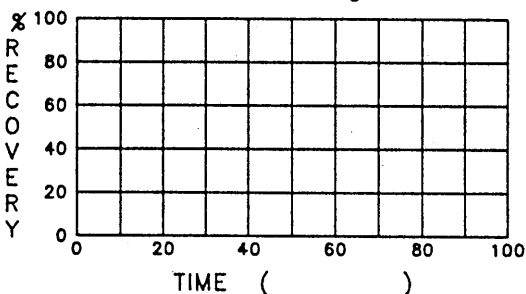
$$Q = \quad S_0 =$$


SITE NAME APS FOUR CORNERS S.E.S.

LOCATION CHACO WASH INTERCEPT

SUPERVISED BY DAVID GORDON

DATE 4-17-92



# MONITOR WELL CONSTRUCTION SUMMARY

Survey Coords: N2068350  
E297860

Elevation Ground Level 5069.8  
Top of Casing 5071.2

## Drilling Summary:

Total Depth 60 FEET  
Borehole Diameter NOMINAL 8-INCH  
Casing Stick-up Height: +1 FEET  
Driller MO-TE DRILLING INC.  
FARMINGTON, N.M.

Rig 1500 GARDNER-DENVER AIR ROTARY  
Bit(s) 7 7/8-INCH BUTTON ROCK BIT

Drilling Fluid "QUICK FOAM"

Protective Casing 6-INCH STEEL WITH LOCKING CAP

## Well Design & Specifications:

Basis: Geologic Log X Geophysical Log       
Casing String (s): C = Casing S = Screen.

Depth	String(s)	Elevation
+1 — 31	C1	—
31 — 51	S1	—
—	END CAP	—
—	—	—
—	—	—
—	—	—

Casing: C1 4-INCH, SCH 40 PVC, BLANK,  
FLUSH-THREADED.

C2                     

Screen: S1 4-INCH, SCH 40 PVC, 0.020-INCH SLOT,  
FLUSH-THREADED.

S2                     

Filter Pack: WASHED PEA GRAVEL FROM 30 FEET TO  
11 FEET.

Grout Seal: REDI-MIX CEMENT FROM 9 FEET TO  
SURFACE.

Bentonite Seal: 1/4-INCH PELLETS FROM 11 FEET TO  
9 FEET.

## Construction Time Log:

Task	Start		Finish	
	Date	Time	Date	Time
Drilling	4-15-92	1450	4-15-92	1535
Geophys. Logging:				
Casing:	4-15-92	1550	4-15-92	1615
Filter Placement:	4-15-92	1620	4-15-92	1640
Cementing:	4-16-92	0830	4-16-92	0900
Development:	4-16-92	1645	4-16-92	1745
	4-17-92	0800	4-17-92	1000


## Well Development:

WELL DEVELOPED BY AIR LIFT METHODS ON  
4-17-92.

## Stabilization Test Data:

Time	pH	Spec. Cond.	Temp (C)

## Recovery Data:

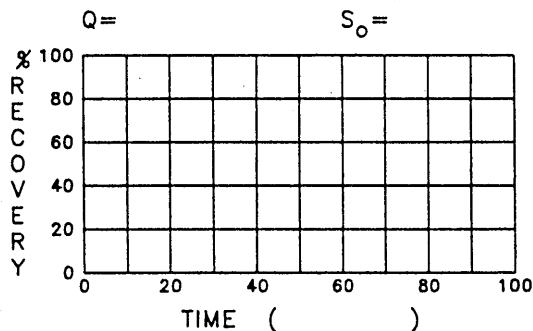

Comments: SURVEY COORDINATES, ELEVATION GROUND LEVEL AND TOP OF CASING ARE ESTIMATED. SURVEY DATA TO  
BE PROVIDED LATER.

SITE NAME APS FOUR CORNERS S.E.S.

LOCATION CHACO WASH INTERCEPT

SUPERVISED BY DAVID GORDON

DATE 4-17-92



Job NO. 02353-118-022

Survey Coords: N2067620  
E298645

Top of Casing 5080.8

### Construction Time Log:

Protective Casing 6-INCH STEEL WITH LOCKING CAP

Basis: Geologic Log X Geophysical Log \_\_\_\_\_  
Casing String (s): C = Casing S = Screen.

Depth	String(s)	Elevation
+1 — 22	C1	— —
22 — 42	S1	— —
— —	END CAP	— —
— —		— —
— —		— —
— —		— —

S2.

Bentonite Seal: 1/4-INCH PELLETS FROM 16 FEET TO 15 FEET.

Task	Start		Finish	
	Date	Time	Date	Time
Drilling	4-15-92	10:45	4-15-92	11:30
Geophys. Logging:				
Casing:	4-15-92	11:45	4-15-92	12:00
Filter Placement:	-	-	-	-
Cementing:	4-15-92	12:50	4-15-92	14:00
Development:	4-17-92	10:00	4-17-92	11:00

**Well Development:**


WELL DEVELOPED BY AIR LIFT METHODS ON  
4-17-92.

**Stabilization Test Data:**

Time	pH	Spec. Cond.	Temp (C)

## Recovery Data:

Q=
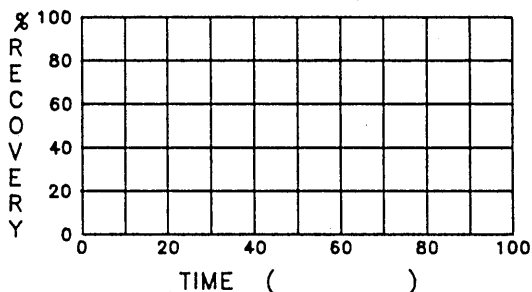
$$S_0 =$$


Comments: SURVEY COORDINATES, ELEVATION GROUND LEVEL AND TOP OF CASING ARE ESTIMATED. SURVEY DATA TO BE PROVIDED LATER.

SITE NAME APS FOUR CORNERS S.E.S.

LOCATION CHACO WASH INTERCEPT

SUPERVISED BY DAVID GORDON

DATE 4-17-92



Job No. 02353-118-022

Survey Coords: N2067120  
E298710

Elevation Ground Level 5074.1  
Top of Casing 5075.5

### Construction Time Log:

Total Depth 40 FEET  
Borehole Diameter NOMINAL 8-INCH  
Casing Stick-up Height +1 FEET  
Driller MO-TE DRILLING INC.  
FARMINGTON, N.M.

Rig 1500 GARDNER-DENVER AIR ROTARY  
Bit(s) 7 7/8-INCH BUTTON ROCK BIT

Drilling Fluid "QUICK FOAM"

Protective Casing 6-INCH STEEL WITH LOCKING CAP

### Well Design & Specifications:

Basis: Geologic Log   x   Geophysical Log         
Casing String (s): C = Casing S = Screen.

Depth	String(s)	Elevation
+1 — 15	C1	— —
15 — 35	S1	— —
— —	END CAP	— —
— —		— —
— —		— —
— —		— —

Casing: C1 4-INCH, SCH 40 PVC, BLANK,  
FLUSH-THREADED.

Screen: S1 4-INCH, SCH 40 PVC, 0.020-INCH SLOT,  
FLUSH-THREADED.

S2 \_\_\_\_\_

Filter Pack: WASHED PEA GRAVEL FROM 40 FEET TO  
11 FEET.

Grout Seal: REDI-MIX CEMENT FROM 10 FEET TO  
SURFACE.

Bentonite Seal: 1/4-INCH PELLETS FROM 11 FEET TO 10 FEET.

Task	Start		Finish	
	Date	Time	Date	Time
Drilling	4-16-92	09:45	4-16-92	10:15
Geophys. Logging:				
Casing:	4-16-92	10:30	4-16-92	10:40
Filter Placement:	4-16-92	10:40	4-16-92	10:50
Cementing:	4-16-92	11:00	4-16-92	11:45
Development:	4-17-92	11:00	4-17-92	12:00


**Well Development:**

WELL DEVELOPED BY AIR LIFT METHODS ON  
4-17-92.

Stabilization Test Data:

Time	pH	Spec. Cond.	Temp (C)

## Recovery Data:
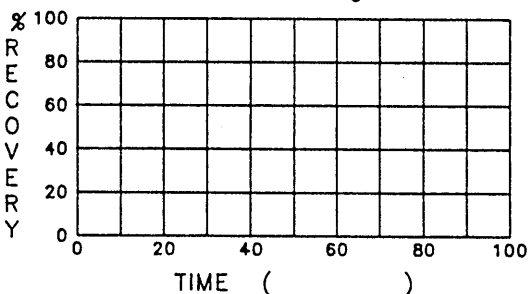
$$Q = \quad S_0 =$$


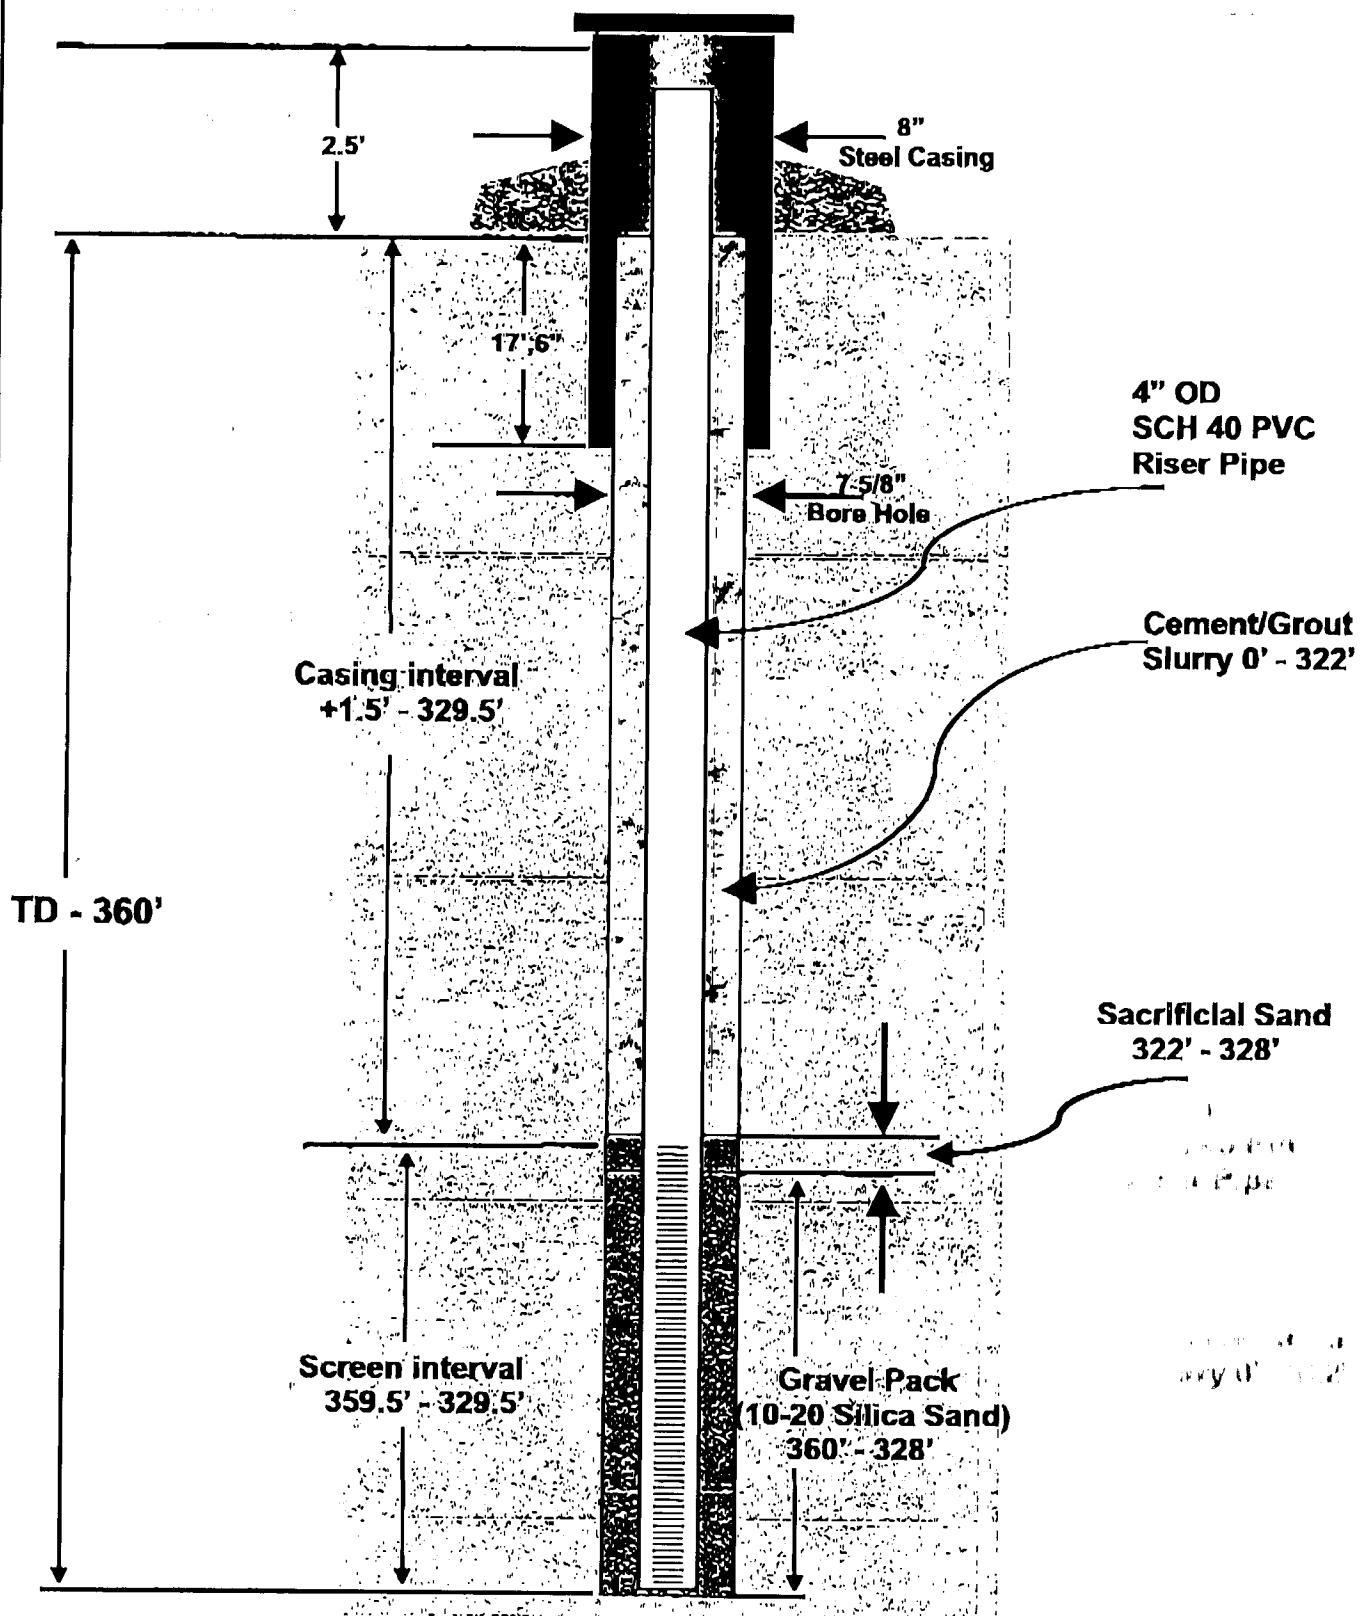
Comments: SURVEY COORDINATES, ELEVATION GROUND LEVEL AND TOP OF CASING ARE ESTIMATED. SURVEY DATA TO BE PROVIDED LATER.

SITE NAME APS FOUR CORNERS S.E.S.

LOCATION CHACO WASH INTERCEPT

SUPERVISED BY DAVID GORDON

DATE 4-17-92




**amec**

Project Number 3-517-000131

October 2003

Four Corners Power Plant  
Arizona Public Service Company  
Monitor Well Installation  
Fruitland, New Mexico

**Monitor Well  
Schematic LS-1**

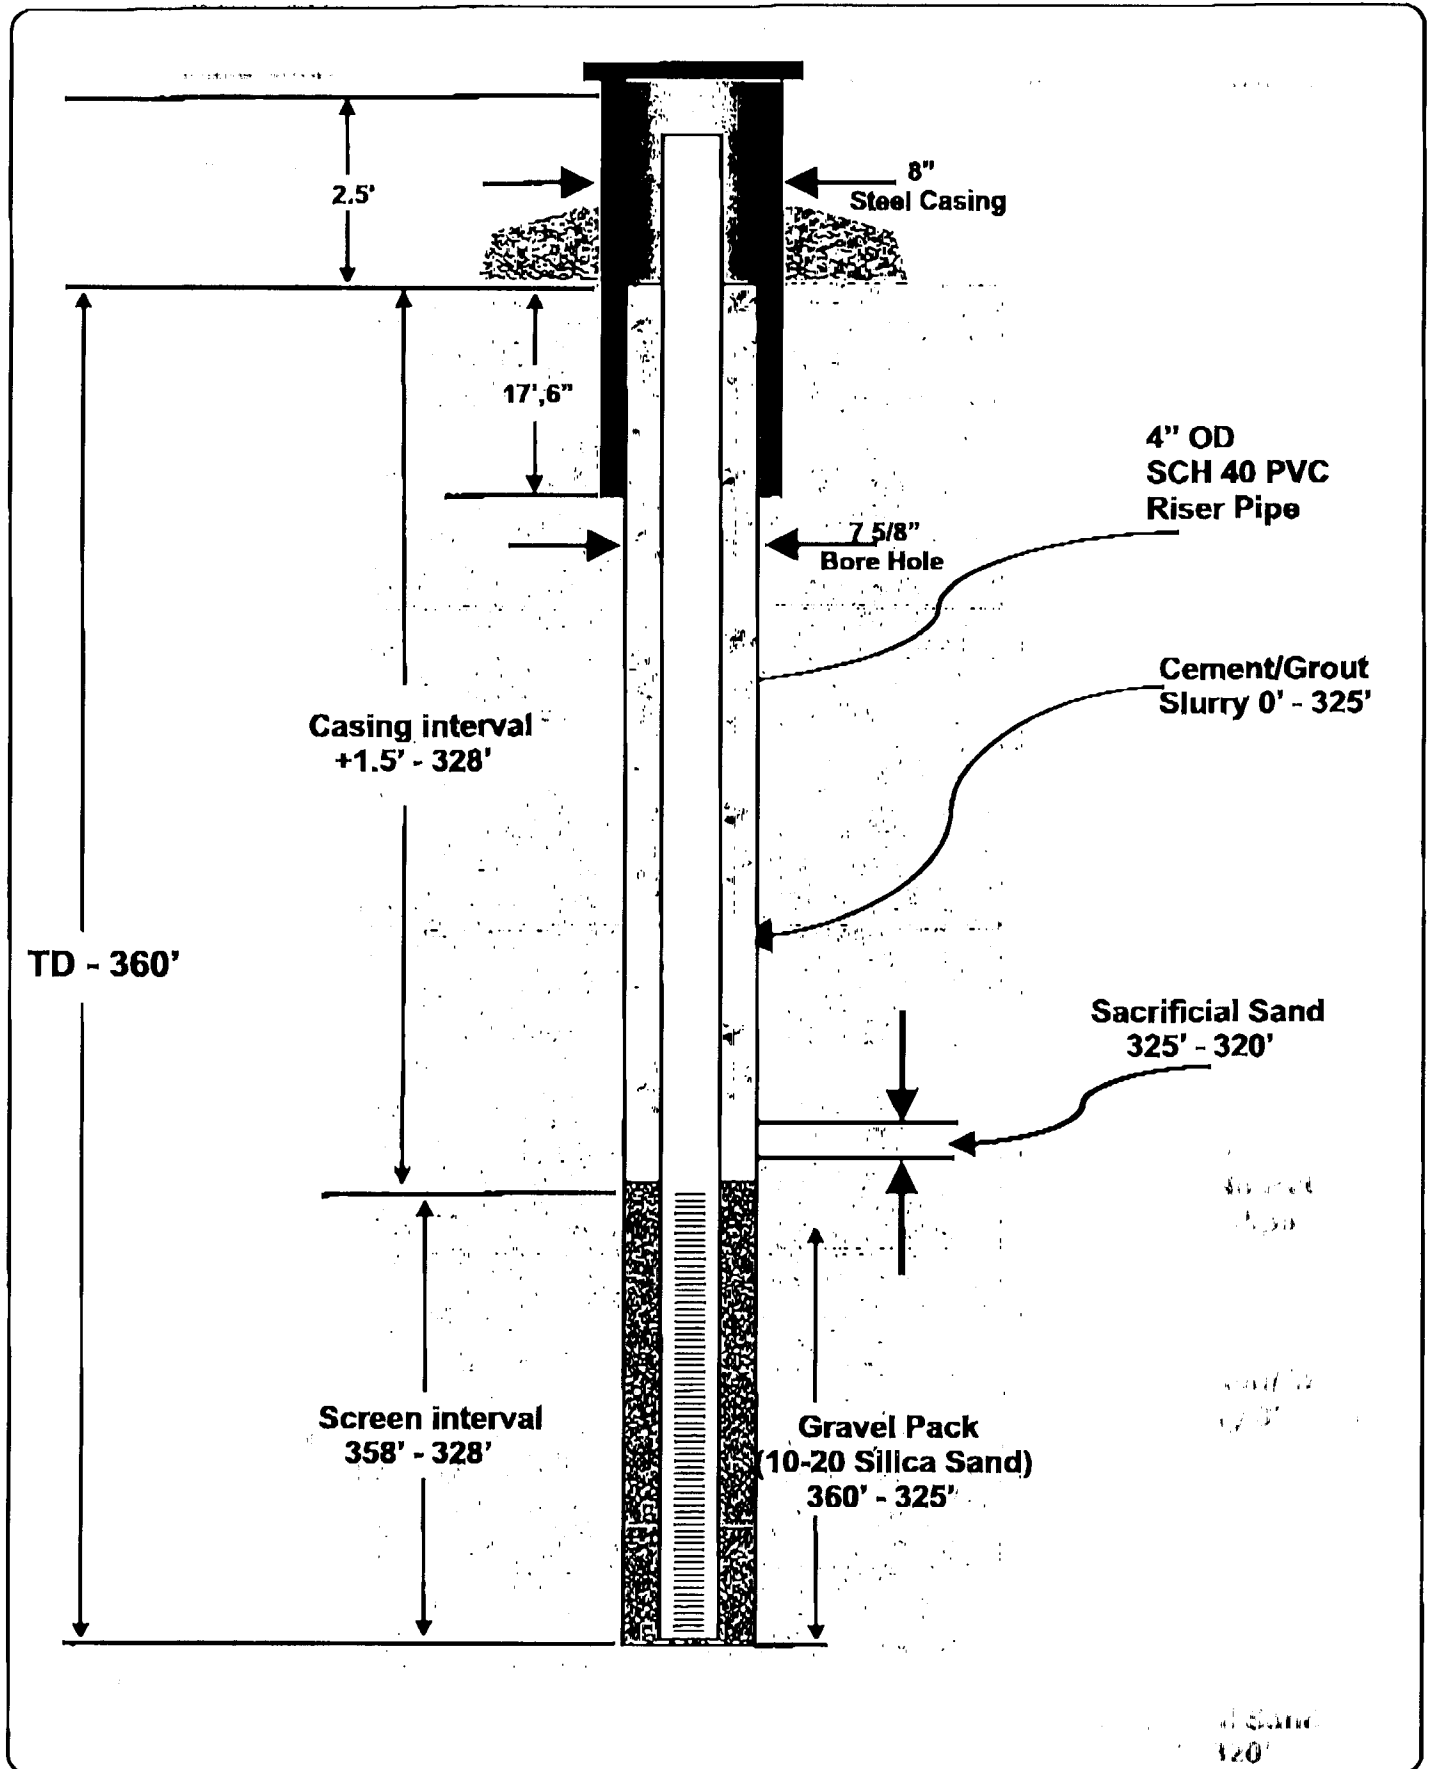

**amec**

Project Number 3-517-000131

October 2003

Four Corners Power Plant  
Arizona Public Service Company  
Monitor Well Installation  
Fruitland, New Mexico

Monitor Well  
Schematic LS-2

<b>Project Name:</b> APS Four Corners Power Plant		<h1 style="margin: 0;">BOREHOLE LOG</h1>			
<b>Project Number:</b> 3-517000131					
<b>Page:</b> 1 of 1					

BOREHOLE: <u>LS-1</u> DIAMETER: <u>8" OD</u> LOCATION: <u>N 36°41'08.3" W 108°29'39.3"</u> DRILL METHODS: <u>Dual tube-RV-Circ</u> DRILL RIG TYPE: <u>Schram T 660WS</u>	LOGGED BY: <u>Jim Criss</u> DRILLING DATE: <u>10 October 2003</u> DRILLER: <u>Ellis Lorimor</u> DRILL COMPANY: <u>Rainbow Drilling, Inc.</u>
---	---

DEPTH TO WATER: <u>N/A</u> STABILIZATION TIME: <u>N/A</u>	REFERENCE POINT DESCRIPTION: <u>GPS</u> REFERENCE POINT ELEVATION: <u>~</u>
--	--






SAMPLE NO.	DEPTH, BGS	Blows/ft	SAMPLE DESCRIPTION	STRATUM	NOTES
	(ft)				
	0-20		Interbedded Sandstone and Clay - 1/8 inch Coal Seams. Sandstone is very fine with some calcarious cementation		
	20-40		Same as above		
	40-60		Lewis Shale formation: Shale with considerable silt, occasional fine sand. Predominately dark gray with occasional sight gray stringers.		
	60-80		Same as above with less silt and no sand.		
	80-100		Same as above		
	100-120		Lewis Shale formation: Highley weathered, thick bedding, relatively soft, light gray to black.		
	120-140		Same as above		
	140-160		Same as above		
	160-180		Same as above		
	180-200		Same as above		
	200-220		Same as above		
	220-240		1 to 2 foot layer of limestone. Very fractured, thinly beded, very hard, gray. 230'-232'		
	240-280		Lewis Shale formation: somewhat carbonaceous, slightly to moderately weathered, very fractured, laminated, soft to moderately hard, brown to gray to black.		
	280-300		Same as above		
	300-320		Same as above		
	320-340		Same as above		
	340-360		Same as above. Total Depth 160'		



<b>Project Name:</b> APS Four Corners Power Plant <b>Project Number:</b> 3-517000131 <b>Page:</b> 1 of 1	<h1 style="margin: 0;">BOREHOLE LOG</h1>	
<b>BOREHOLE:</b> <u>LS-2</u> <b>DIAMETER:</b> <u>8' OD</u> <b>LOCATION:</b> <u>N 36°40'57.8" W 108°29'39".2"</u> <b>DRILL METHODS:</b> <u>Dual tube-RV-Circ</u> <b>DRILL RIG TYPE:</b> <u>Schram T 660WS</u>		
<b>LOGGED BY:</b> <u>Jim Criss</u> <b>DRILLING DATE:</b> <u>10 October 2003</u> <b>DRILLER:</b> <u>Ellis Lorimor</u> <b>DRILL COMPANY:</b> <u>Rainbow Drilling, Inc.</u>		
<b>DEPTH TO WATER:</b> <u>N/A</u> <b>REFERENCE POINT DESCRIPTION:</b> <u>GPS</u> <b>STABILIZATION TIME:</b> <u>N/A</u> <b>REFERENCE POINT ELEVATION:</b> <u>~</u>		

SAMPLE NO.	DEPTH, BGS	Blows/ft	SAMPLE DESCRIPTION	STRATUM	NOTES
	(ft)				
	0-20		Pictured Cliffs Sandstone: Fine, very weathered, moderately hard, brown		
	20-40		Same as above		
	40-60		Lewis Shale formation: Shale with considerable silt, occasional fine sand. Predominately dark gray with occasional sight gray stringers.		
	60-80		Same as above with less silt and no sand. Considerable gypsom in joints. Moderately to slightly weathered.		
	80-100		Same as above		
	100-120		Lewis Shale formation: Highley weathered, thick bedding, relatively soft, light gray to black.		
	120-140		Same as above		
	140-160		Same as above		
	160-180		Same as above		
	180-200		Same as above		
	200-220		1 to 2 foot layer of limestone. Very fractured, thinly bedded, very hard, gray. 210'-212'		
	220-240		Lewis Shale formation: somewhat carbonaceous, slightly to moderately weathered, very fractured, laminated, soft to moderately hard, brown to gray to black		
	240-280		Same as above		
	280-300		Same as above		
	300-320		Same as above		
	320-340		Same as above		
	340-360		Same as above. Total Depth 160'		

**Job No.:** 23445882**Client:** Arizona Public Service**Project:** Phase I - Seepage Study**Location:** Four Corners Power Plant**Driller:** Boart Longyear**Drilling Method:** Rotosonic (GP24-300RS)**Sampling Method:** Continuous Core/Grab Sampling**Logged by:** Derrick Maurer**Boring No. L1-1380****Alternate ID:****Start Time:** 1100**Start Date:** 6/8/10**Finish Time:** 1305**Finish Date:** 6/8/10**Depth to Groundwater:** 19 ft bgs**Date:** 6/8/10

Depth (ft)	Graphic Log	Lithology	Fines %	Sand %	Gravel %	Description	As-Built
0		CL	NM	NM	NM	<b>Lean Clay</b> Light Brown, medium plasticity, dry, unweathered shale fragments present (0-2ft bgs)	
5		Shale				<b>Weathered Shale</b> Brown, weak to moderate cementation, iron staining and gypsum present, dry to moist	
10							
15						Moist (15-19) Wet clay, no gypsum (19-23)	
20							
25						Moist, iron staining and gypsum present (23-30)	
30						<b>Unweathered Shale</b> Blue-Gray, moderate to strong cementation, dry, reacts with HCl	
35							
40							
45							
50						Total Depth = 50ft	
55							

Job No.: 23445882

Client: Arizona Public Service

Project: Phase I - Seepage Study

Location: Four Corners Power Plant

Driller: Boart Longyear

Drilling Method: Rotosonic (GP24-300RS)

Sampling Method: Continuous Core/Grab Sampling

Logged by: Derrick Maurer

**Boring No. L1-1687**

Alternate ID:

Start Time: 1540

Start Date: 6/6/10

Finish Time: 0900

Finish Date: 6/7/10

Depth to Groundwater: 15 ft bgs

Date: 6/6/10

Depth (ft)	Graphic Log	Lithology	Fines %	Sand %	Gravel %	Description	As-Built
0		CL	NM	NM	NM	<b>Lean Clay</b> Brown, medium plasticity, very stiff, dry to moist	
5							
10						Moist, soft to medium stiff at 12ft bgs	
15						Wet, soft to very soft (15-26ft bgs)	
20							
25						Wet, stiff (26-27ft bgs)	
30		Shale				<b>Weathered Shale</b> Brown, weak to moderate cementation, iron staining and trace gypsum, moist (28-45ft bgs)	
35							
40							
45						<b>Unweathered Shale</b> Blue-Gray, moderate to strong cementation, reacts with HCl, dry to moist (45-52.5ft bgs)	
50							
55						Total Depth = 52.5ft	



7720 North 16th St., Suite 100  
Phoenix, Arizona 85020  
(602) 371-1100

**Job No.:** 23445882  
**Client:** Arizona Public Service  
**Project:** Phase I - Seepage Study  
**Location:** Four Corners Power Plant

# Boring No. L1-2182


**Alternate ID:** MW-34

**Start Time:** 1530  
**Start Date:** 6/8/10

**Finish Time:** 0815  
**Finish Date:** 6/9/10

**Driller:** Boart Longyear  
**Drilling Method:** Rotosonic (GP24-300RS)  
**Sampling Method:** Continuous Core/Grab Sampling  
**Logged by:** Derrick Maurer

**Depth to Groundwater:** 27.30 ft bgs  
**Date:** 6/9/10

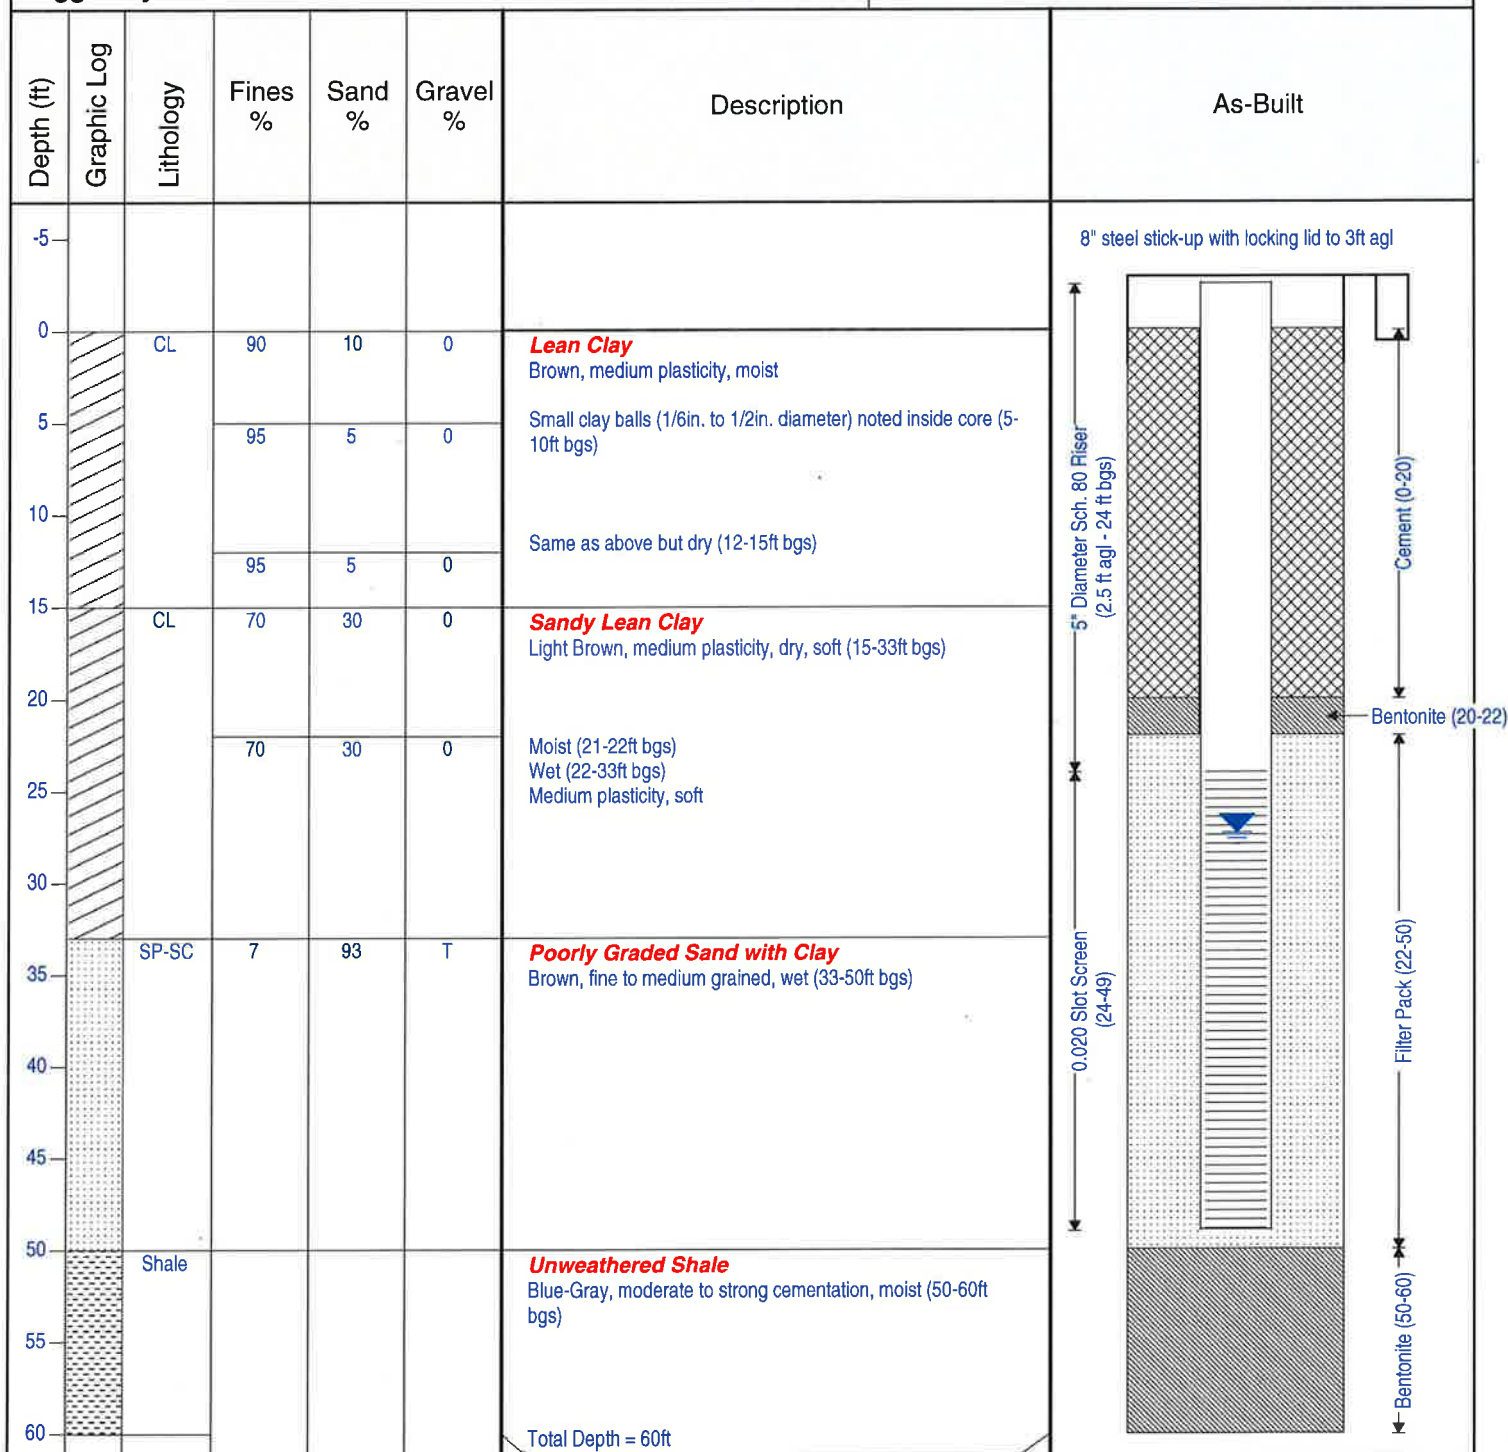

**Job No.:** 23445882  
**Client:** Arizona Public Service  
**Project:** Phase I - Seepage Study  
**Location:** Four Corners Power Plant

**Boring No. L1-3090**


**Alternate ID:** MW-33

**Driller:** Boart Longyear  
**Drilling Method:** Rotasonic (GP24-300RS)  
**Sampling Method:** Continuous Core/Grab Sampling  
**Logged by:** Derrick Maurer

**Start Time:** 1325  
**Start Date:** 6/7/10

**Finish Time:** 1610  
**Finish Date:** 6/7/10

**Depth to Groundwater:** 18.74 ft bgs  
**Date:** 6/9/10

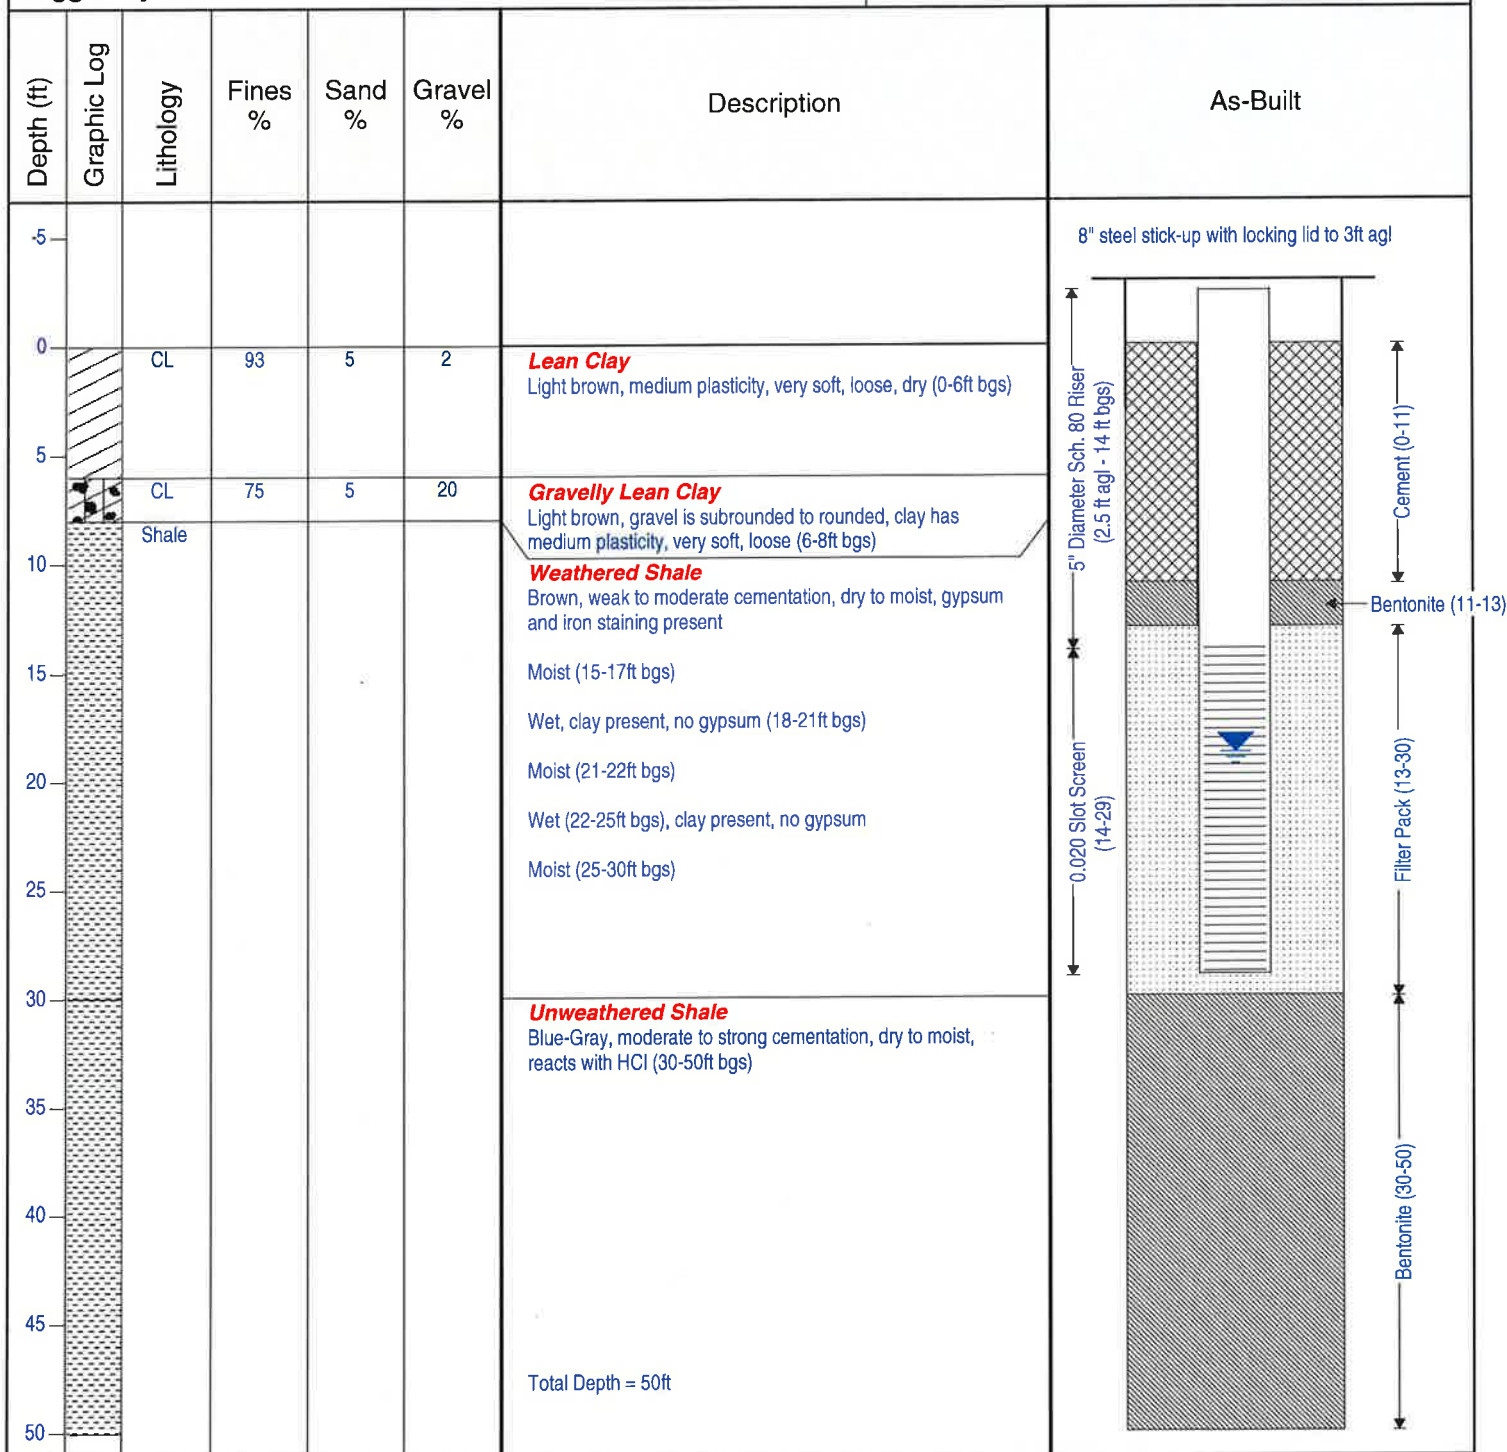



<b>Job No.:</b> 23445882 <b>Client:</b> Arizona Public Service <b>Project:</b> Phase I - Seepage Study <b>Location:</b> Four Corners Power Plant						<b>Boring No. L3-949</b> <b>Alternate ID:</b> MW-32	
<b>Driller:</b> Boart Longyear <b>Drilling Method:</b> Rotosonic (GP24-300RS) <b>Sampling Method:</b> Continuous Core/Grab Sampling <b>Logged by:</b> Derrick Maurer						<b>Start Time:</b> 0900 <b>Start Date:</b> 6/6/10	<b>Finish Time:</b> 1215 <b>Finish Date:</b> 6/6/10
						<b>Depth to Groundwater:</b> 10.45 ft bgs <b>Date:</b> 6/6/10	
Depth (ft)	Graphic Log	Lithology	Fines %	Sand %	Gravel %	Description	As-Built
-5							8" steel stick-up with locking lid to 3ft agl
0		CL	90	10	T	<b>Lean Clay</b> Brown, medium plasticity, moist (0-4.5ft bgs)	
5		Shale				<b>Poorly Graded Sand</b> Fine to medium grained, moist, (4.5-5ft bgs) F%=5, S%=95, G%=0 <b>Weathered Shale</b> Brown, weak to moderate cementation, iron staining and gypsum present, moist (5-10ft bgs) Wet, mostly clay with iron staining (10-13ft bgs) 1/16in. thick layer of gypsum, moist (13-14ft bgs) Wet, mostly clay with iron staining (14-17ft bgs) Same as above but moist (17-21ft bgs) 1in. thick layer of wet shale at 18.8' bgs	
10							
15							
20							
25						<b>Unweathered Shale</b> Blue-Gray, moderate to strong cementation, moist to dry, calcite present in small amounts, reacts with HCl (21-50ft bgs)	
30							
35							
40							
45							
50						TD= 50ft bgs	



Job No.: 23445882  
 Client: Arizona Public Service  
 Project: Phase I - Seepage Study  
 Location: Four Corners Power Plant

## Boring No. L3-1532


Alternate ID: MW-30

Start Time: 1325  
 Start Date: 6/2/10

Finish Time: 1800  
 Finish Date: 6/2/10

Driller: Boart Longyear  
 Drilling Method: Rotasonic (GP24-300RS)  
 Sampling Method: Continuous Core/Grab Sampling  
 Logged by: Derrick Maurer

Depth to Groundwater: 14 ft bgs  
 Date: 6/2/10

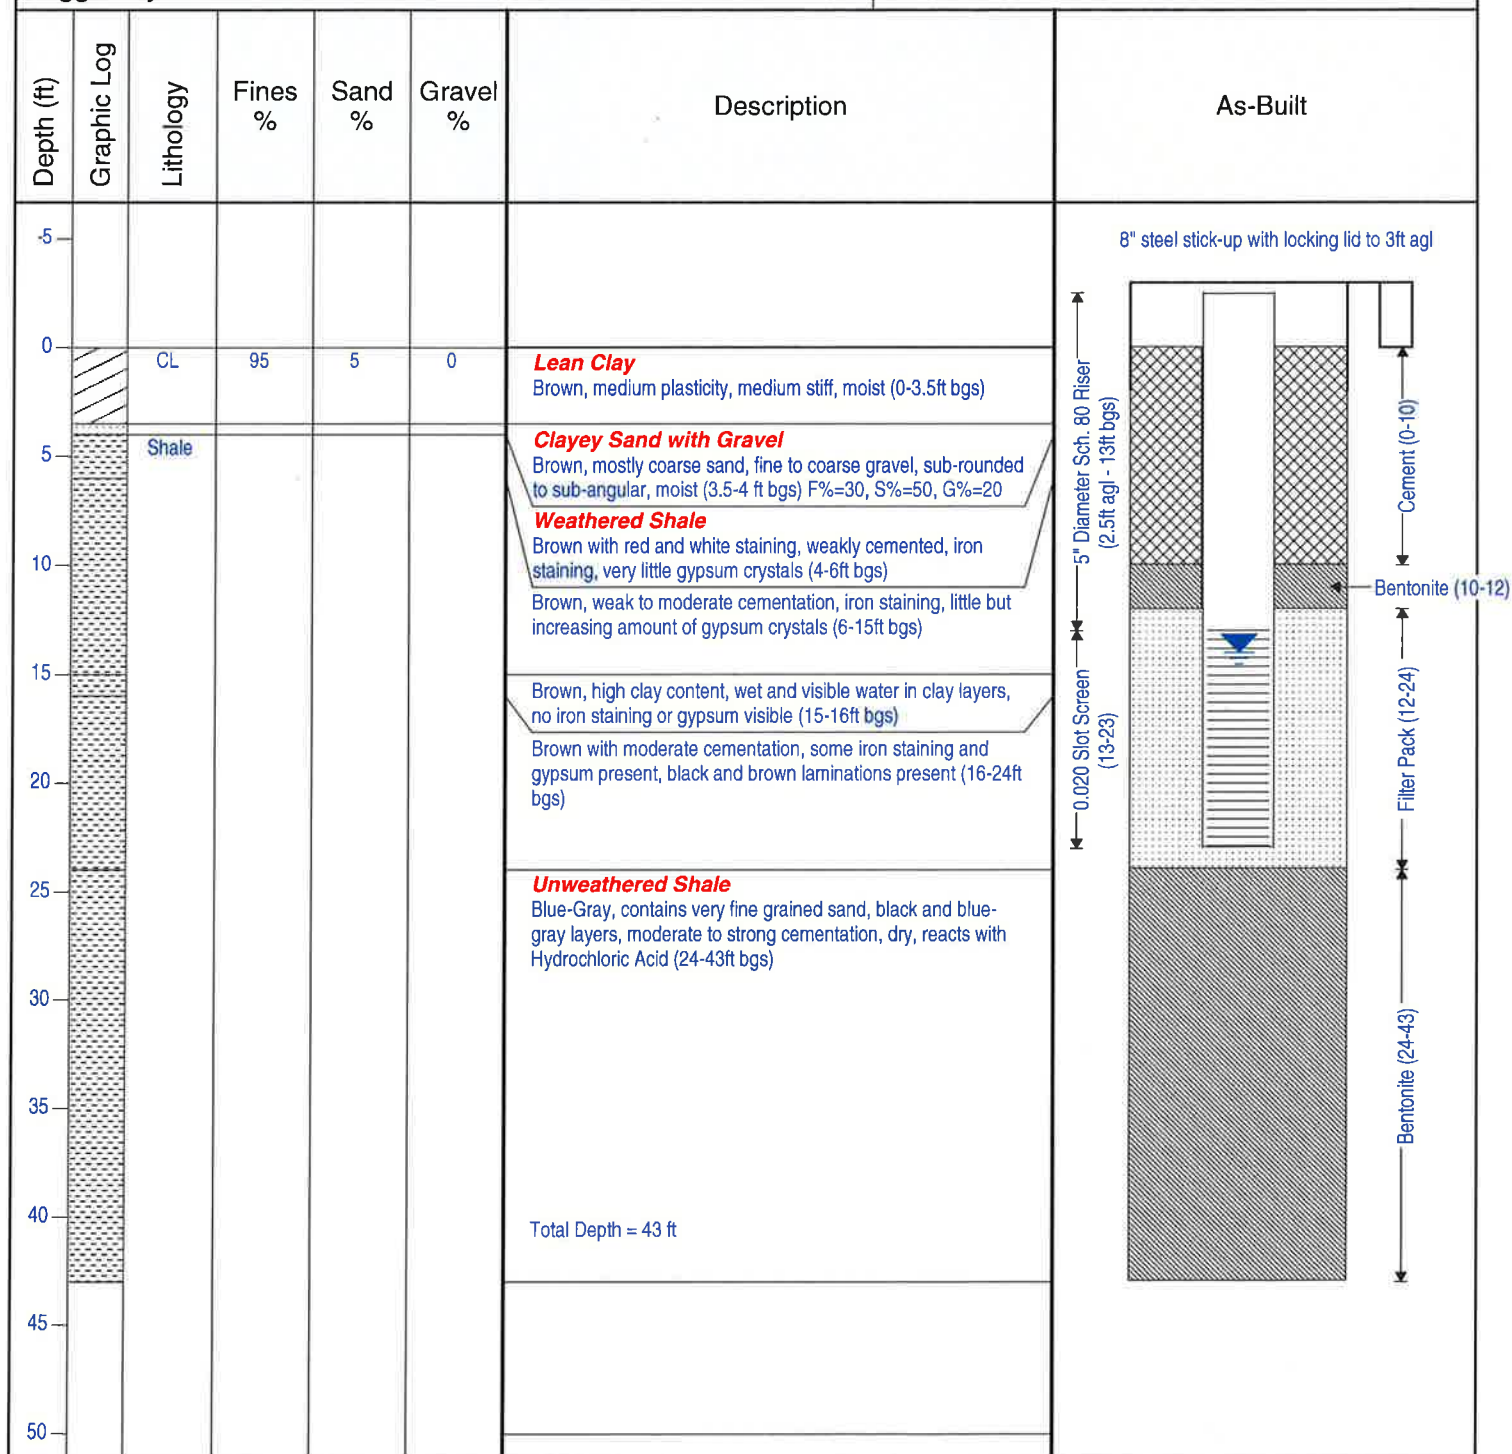

7720 North 16th St., Suite 100  
 Phoenix, Arizona 85020  
 (602) 371-1100

**Job No.:** 23445882  
**Client:** Arizona Public Service  
**Project:** Phase I - Seepage Study  
**Location:** Four Corners Power Plant

**Boring No. L3-1747**



**Alternate ID:**


**Driller:** Boart Longyear  
**Drilling Method:** Rotosonic (GP24-300RS)  
**Sampling Method:** Continuous Core/Grab Sampling  
**Logged by:** Derrick Maurer

**Start Time:** 1337  
**Start Date:** 6/5/10

**Finish Time:** 1656  
**Finish Date:** 6/5/10

**Depth to Groundwater:** 16 ft bgs  
**Date:** 6/5/10

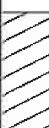
Depth (ft)	Graphic Log	Lithology	Fines %	Sand %	Gravel %	Description	As-Built
0		CL	70	30	T	<b>Sandy Lean Clay</b> Light Brown, medium plasticity, dry to moist, trace amounts of gypsum (0-6ft bgs)	 <div style="position: absolute; right: 0; top: 50%; transform: translateY(-50%);">Cement (0-50)</div>
5		Shale				<b>Weathered Shale</b> Brown, weak to moderate cementation, iron staining and gypsum present, moist  1in. thick layer at 16ft bgs wet with visible water, otherwise moist  1/2in. thick layer at 19ft bgs wet with visible water, otherwise moist	
10							
15							
20		Unweathered Shale				<b>Unweathered Shale</b> Blue-Gray, moderate to strong cementation, dry, gypsum noted (20-20.5ft bgs)  Reacts with HCl at 28ft bgs  Moist (30-31ft bgs) Dry (31-32ft bgs) 1in. thick layer of wet unweathered shale noted at 32ft bgs, otherwise dry	
25							
30							
35							
40							
45							
50						Total Depth = 50ft	
55							

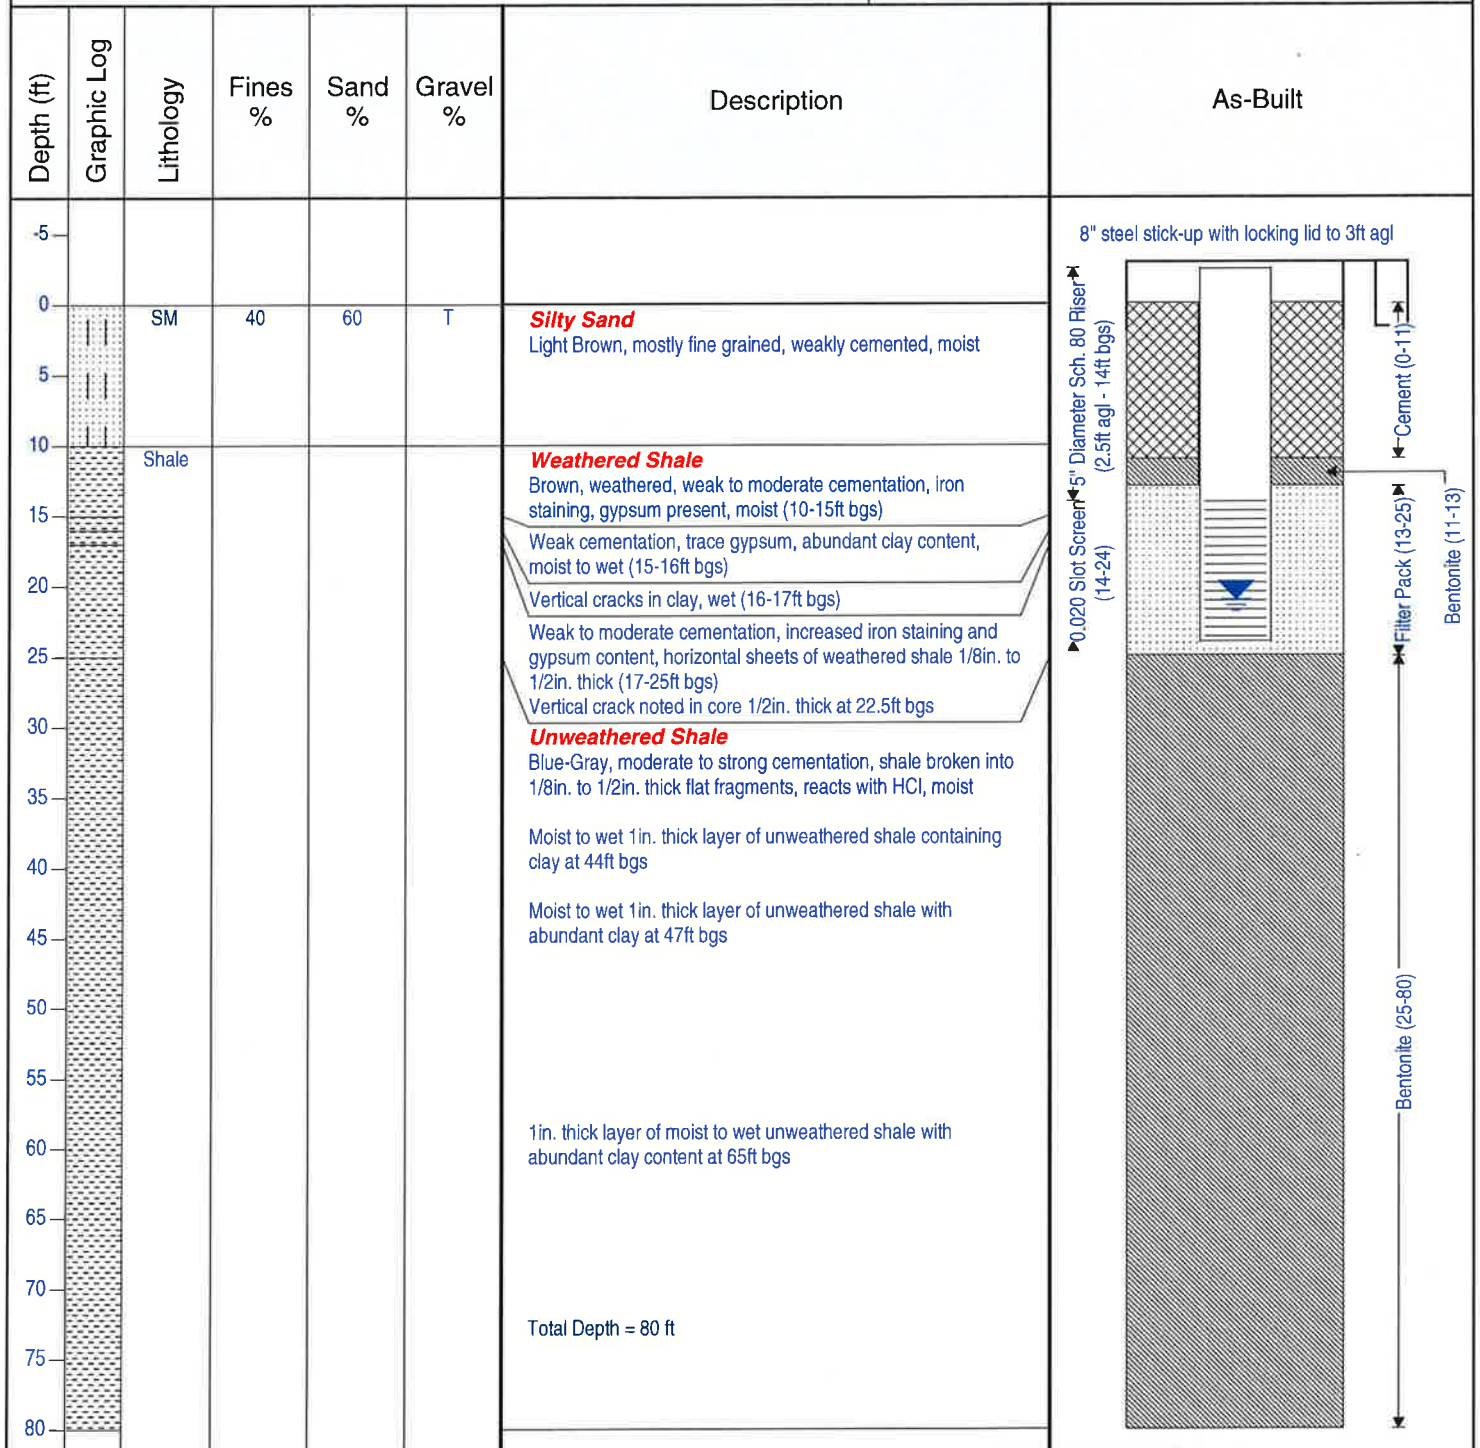**Job No.:** 23445882**Client:** Arizona Public Service**Project:** Phase I - Seepage Study**Location:** Four Corners Power Plant**Driller:** Boart Longyear**Drilling Method:** Rotasonic (GP24-300RS)**Sampling Method:** Continuous Core/Grab Sampling**Logged by:** Derrick Maurer**Boring No. L3-1957****Alternate ID:** MW-31**Start Time:** 1535**Start Date:** 6/3/10**Finish Time:** 1735**Finish Date:** 6/4/10**Depth to Groundwater:** 21 ft bgs**Date:** 6/4/10



















7720 North 16th St., Suite 100  
Phoenix, Arizona 85020  
(602) 371-1100



**Job No.:** 23445947**Client:** Arizona Public Service**Project:** Phase II - Seepage Study**Location:** Four Corners Power Plant**Boring No. L3-510****Alternate ID:** None**Driller:** Boart Longyear**Drilling Method:** Rotasonic (SR121)**Sampling Method:** Continuous Core/Grab Sampling**Logged by:** Derrick Maurer**Start Time:** 1250**Start Date:** 9/8/10**Finish Time:** 0945**Finish Date:** 9/9/10**Depth to Groundwater:** Not measured**Surface Elevation:** 5089.88

Depth (ft)	Graphic Log	Lithology	Fines %	Sand %	Gravel %	Description	As-Built
0		CL	85	15	0	<b>Lean Clay with Sand</b> Light Brown, medium plasticity, medium toughness, moist (0-13ft)	 <div style="position: absolute; left: 850px; top: 310px; transform: rotate(90deg);">Cement (0-20)</div> <div style="position: absolute; left: 850px; top: 640px; transform: rotate(90deg);">Bentonite (20-70)</div>
5							
10							
15		Shale				<b>Weathered Shale with Lean Clay</b> Brown, trace gypsum, moist Highly fractured, moist (17-18ft)  Dark brown lean clay, moist to wet (18-19ft)  Dark brown weathered shale, highly fractured, wet, trace gypsum (19-39ft)	
20							
25							
30							
35							
40						<b>Unweathered Shale</b> Blue-Gray, moderate to strong cementation, moist to dry	
45						Mostly dry (45ft)	
50							
55							
60						Dry (60ft)	
65						Total Depth = 70ft	
70							

**Job No.:** 23445947**Client:** Arizona Public Service**Project:** Phase II - Seepage Study**Location:** Four Corners Power Plant**Driller:** Boart Longyear**Drilling Method:** Rotasonic (SR121)**Sampling Method:** Continuous Core/Grab Sampling**Logged by:** Derrick Maurer**Boring No. L3-2200****Alternate ID:** None**Start Time:** 0935**Start Date:** 9/10/10**Finish Time:** 1505**Finish Date:** 9/10/10**Depth to Groundwater:** Not measured**Surface Elevation:** 5089.88

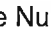Depth (ft)	Graphic Log	Lithology	Fines %	Sand %	Gravel %	Description	As-Built
0		CL	80	20	0	<b>Lean Clay with Sand</b> Brown, medium plasticity, medium toughness, dry (0-3ft)	 Cement (0-20)
5		SC	25	75	T	<b>Clayey Sand</b> Brown, fine to medium grained sand, very loose (3-14ft)	
10		SP	2	98	T	<b>Sand</b> Light Brown, fine to medium, (14-17ft)	
15		Shale				<b>Weathered Shale</b> Brown, iron staining, gypsum, moist (17-33ft) Fractured and wet (20-21ft and 22-23ft)	
20						<b>Unweathered Shale</b> Blue-Gray, moist, fractured (33-34ft)  Dry competent rock (34-80ft)	
25							 Bentonite (20-80)
30							
35							
40							
45							
50							
55							
60							
65							
70							
75							
80						Total Depth = 80ft	

<b>Job No.:</b> 23445947 <b>Client:</b> Arizona Public Service <b>Project:</b> Phase II - Seepage Study <b>Location:</b> Four Corners Power Plant						<b>Boring No. L3-1350</b> <b>Alternate ID:</b> None	
<b>Driller:</b> Boart Longyear <b>Drilling Method:</b> Rotasonic (SR121) <b>Sampling Method:</b> Continuous Core/Grab Sampling <b>Logged by:</b> Derrick Maurer						<b>Start Time:</b> 1248 <b>Start Date:</b> 9/9/10	<b>Finish Time:</b> 1545 <b>Finish Date:</b> 9/9/10
						<b>Depth to Groundwater:</b> Not measured <b>Surface Elevation:</b> 5096.80	
Depth (ft)	Graphic Log	Lithology	Fines %	Sand %	Gravel %	Description	As-Built
0						<b>Lean Clay</b> Light Brown, medium plasticity, medium toughness, moist (0-1ft)	
5		Shale				Fines%(90) Sand%(10)	
10		SP	2	55	43	<b>Sand with Gravel</b> Brown, poorly graded, fine to medium grained sand, fine well rounded gravel, moist (1-2ft)	
15		Shale				Sand% (80) Gravel% (20) Fines%(T)	
20						<b>Clayey Gravel with Sand</b> Dark Brown, mostly fine well rounded gravel, wet (2-2.5ft)	
25						Fines%(30) Sand%(20) Gravel%(50)	
30						<b>Weathered Shale with Lean Clay</b> Highly fractured, iron staining, moist (2.5-7ft)	
35						<b>Sand with Gravel</b> Brown, poorly graded, fine to medium sand, gravel fine, well rounded (7-10ft)	
40						<b>Weathered Shale</b> Brown, highly fractured, clay present, some gypsum, iron staining, moist	
45						Wet (14-16ft)	
50						Moist (16-24ft) 1/4 inch gypsum layer noted at 24ft, wet	
55						<b>Unweathered Shale</b> Blue-Gray	
60						Highly fractured, moist to dry (24-25ft)	
						Dry competent rock (25-60ft)	
						Total Depth = 60ft	



**Job No.:** 23445947**Client:** Arizona Public Service**Project:** Phase II - Seepage Study**Location:** Four Corners Power Plant**Driller:** Boart Longyear**Drilling Method:** Rotosonic (SR121)**Sampling Method:** Continuous Core/Grab Sampling**Logged by:** Derrick Maurer**Boring No. L2-Minus390****Alternate ID:** None**Start Time:** 0836**Start Date:** 9/11/10**Finish Time:** 1400**Finish Date:** 9/11/10**Depth to Groundwater:** Not measured**Surface Elevation:** 5095.85

Depth (ft)	Graphic Log	Lithology	Fines %	Sand %	Gravel %	Description	As-Built
0		CL	70	30	0	<b>Sandy Lean Clay</b> Brown, fine to medium grained sand, clay has medium plasticity, medium toughness, moist (0-7ft) Dry (0-2ft) Moist (2-7ft)	
5		SP/SC	10	88	2	<b>Sand with Clay</b> Brown, poorly graded, fine to medium grained, loose, moist (7-9ft)	
10		SP/SW				<b>Sand with Gravel</b> Brown, poorly graded, fine to medium, gravel mostly fine, well rounded, dry to moist (9-10ft) Fines% (T) Sand% (80) Gravel% (20) Well Graded (10-11ft) Fines% (T) Sand% (70) Gravel% (30)	
15		Shale				<b>Weathered Shale</b> Brown, iron staining, fractured, moist (11-28ft)	
20						Visible water in fractures (28-31ft)	
25						Moist (31-31ft)	
30						Visible water in fractures (33-36ft)	
35						<b>Unweathered Shale</b> Blue-Gray Dry to moist (36-42ft)	
40						Dry (42-60ft)	
45							
50							
55							
60						Total Depth = 60ft	

Cement (0-20)


Bentonite (20-60)

**Job No.:** 23445947**Client:** Arizona Public Service**Project:** Phase II - Seepage Study**Location:** Four Corners Power Plant**Boring No. L2-3397****Alternate ID:** None**Driller:** Boart Longyear**Drilling Method:** Rotasonic (SR121)**Sampling Method:** Continuous Core/Grab Sampling**Logged by:** Derrick Maurer**Start Time:** 1005**Start Date:** 9/13/10**Finish Time:** 1530**Finish Date:** 9/13/10**Depth to Groundwater:** Not measured**Surface Elevation:** 5088.00


Depth (ft)	Graphic Log	Lithology	Fines %	Sand %	Gravel %	Description	As-Built
0		CL	70	30	0	<b>Lean Clay with Sand</b> Brown, medium plasticity, medium toughness, moist (0-16ft)	
5							
10							
15							
20		Shale				<b>Clayey Sand</b> Brown, fine to medium grained sand, wet (16-17ft) <b>Weathered Shale</b> Brown, iron staining, clay present, moist (17-27ft) Moist, fracture zones wet (27-34ft) Gypsum present (30-34ft) Moist (34-36ft)	
25							
30							
35							
40						<b>Unweathered Shale</b> Blue-Gray, dry (36-60ft)	
45							
50							
55							
60						Total Depth = 60ft	



7720 North 16th St., Suite 100  
Phoenix, Arizona 85020  
(602) 371-1100

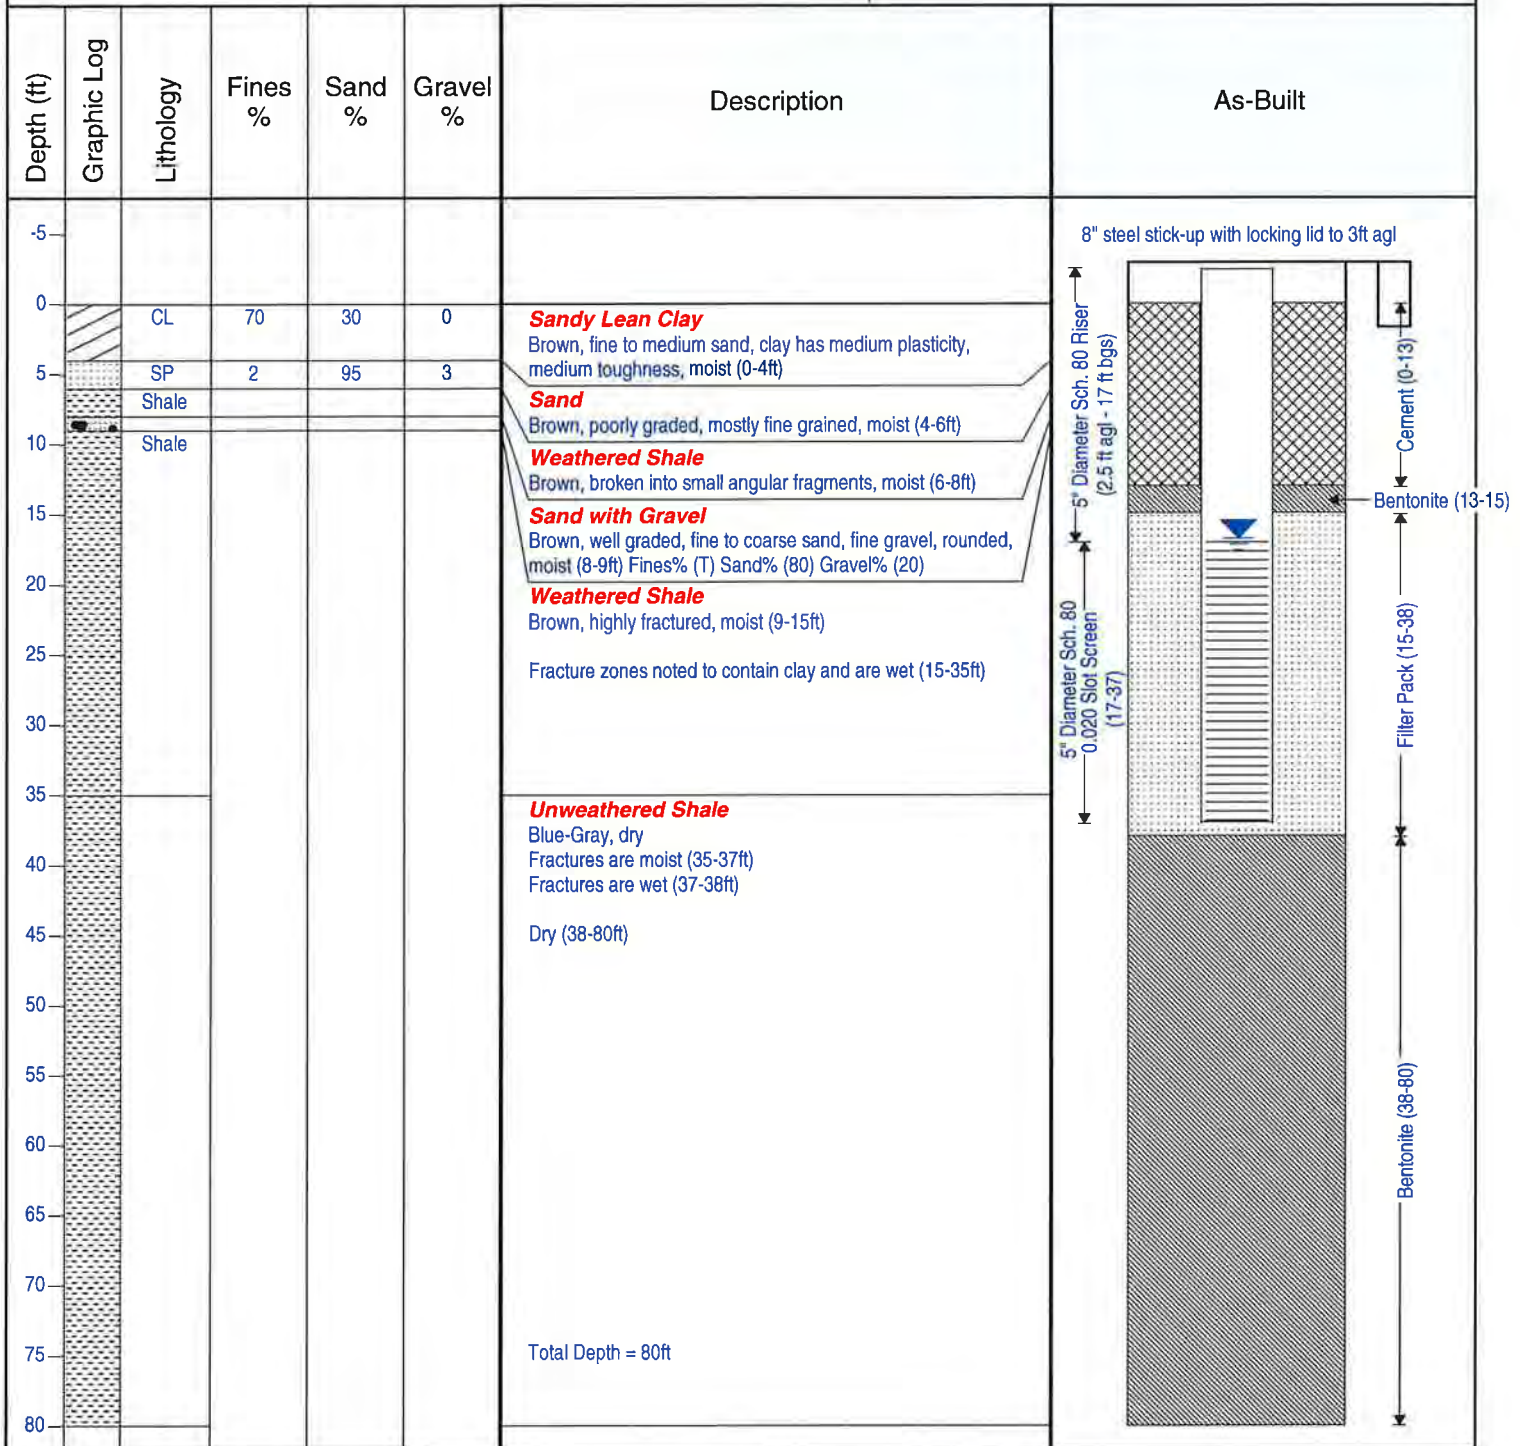**Job No.:** 23445947**Client:** Arizona Public Service**Project:** Phase II - Seepage Study**Location:** Four Corners Power Plant**Boring No. L2-3077****Alternate ID:** MW-36**Start Time:** 0910**Start Date:** 9/14/10**Finish Time:** 1645**Finish Date:** 9/14/10**Driller:** Boart Longyear**Drilling Method:** Rotasonic (SR121)**Sampling Method:** Continuous Core/Grab Sampling**Logged by:** Derrick Maurer**Depth to Groundwater:** 16.71 ft bgs 9/15/10**Surface Elevation:** 5086.840

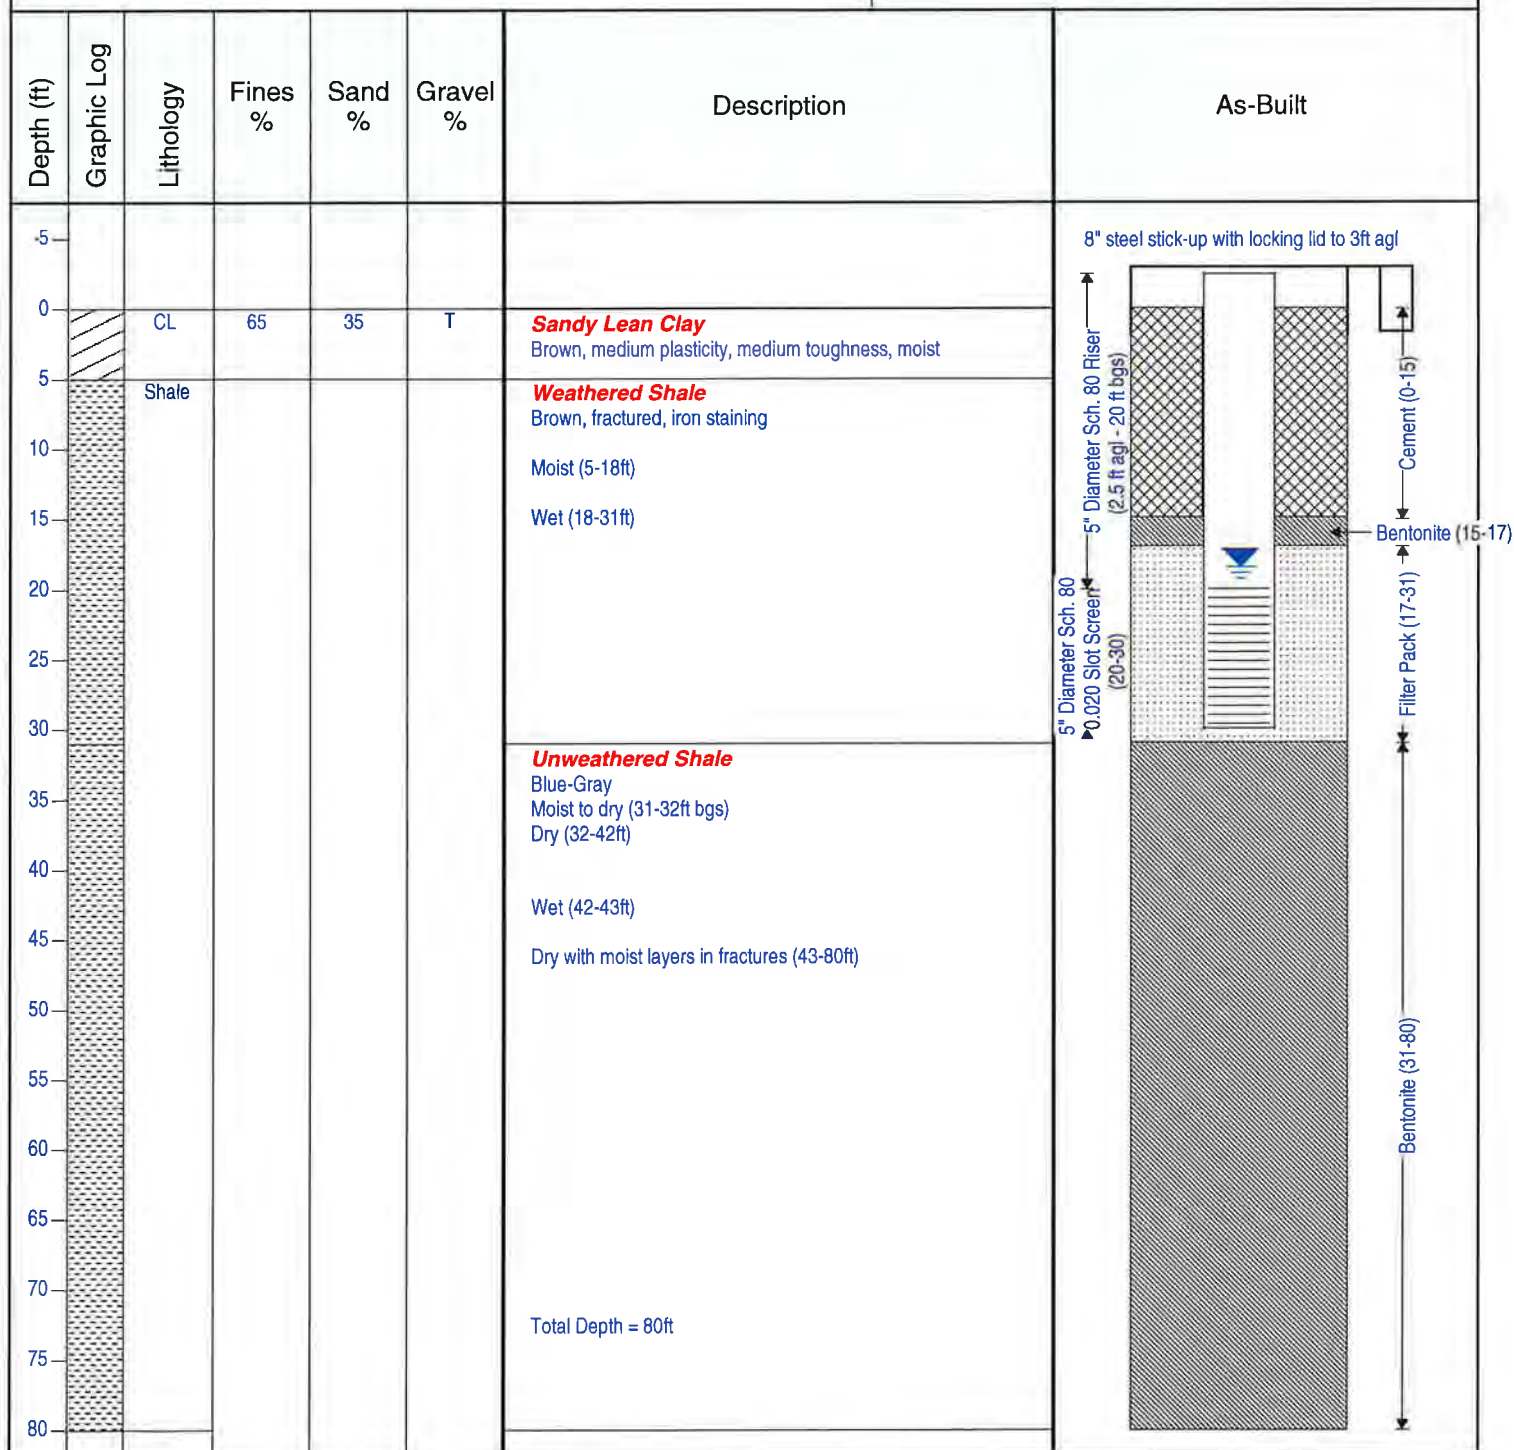


**Job No.:** 23445947**Client:** Arizona Public Service**Project:** Phase II - Seepage Study**Location:** Four Corners Power Plant**Driller:** Boart Longyear**Drilling Method:** Rotosonic (SR121)**Sampling Method:** Continuous Core/Grab Sampling**Logged by:** Derrick Maurer**Boring No. L2-280****Alternate ID:** MW-35**Start Time:** 1525**Start Date:** 9/11/10**Finish Time:** 1315**Finish Date:** 9/12/10**Depth to Groundwater:** 18.43 ft bgs 9/12/10**Surface Elevation:** 5088.208

**Job No.:** 23445947**Client:** Arizona Public Service**Project:** Phase II - Seepage Study**Location:** Four Corners Power Plant**Boring No. L2-1368****Alternate ID:** MW-37**Driller:** Boart Longyear**Drilling Method:** Rotasonic (SR121)**Sampling Method:** Continuous Core/Grab Sampling**Logged by:** Derrick Maurer**Start Time:** 0840**Start Date:** 9/22/10**Finish Time:** 1200**Finish Date:** 9/23/10**Depth to Groundwater:** 20.41 ft bgs 9/25/10**Surface Elevation:** 5089.864


Depth (ft)	Graphic Log	Lithology	Fines %	Sand %	Gravel %	Description	As-Built
-5							8" steel stick-up with locking lid to 3ft agl
0		CL	70	30	0	<b>Sandy Lean Clay</b> Brown, medium plasticity, medium toughness, moist (0-8ft)	
5							
10		Shale				<b>Weathered Shale</b> Brown, with clay, fractures moist (8-18ft)	
15							
20						Wet, lean clay with shale fragments (18-20ft)	
25						Fractured, wet in fractures (20-36ft)	
30							
35							
40						<b>Unweathered Shale</b> Blue-Gray, dry (36-48ft)	
45							
50						Fractures are wet (48-58ft) Rock dry between fractures, fractures range from 0.25 - 5in apart with dry competent rock between (52-58ft)	
55						Dry, hard, competent (58-60ft)	
60						Fractured with clay, wet (60-61ft)	
65						Dry, hard, competent (61-71ft)	
70							
75						Several fracture zones noted 1-3in thick in dry, competent rock (71-80ft)	
80						Total Depth = 80ft	



7720 North 16th St., Suite 100  
Phoenix, Arizona 85020  
(602) 371-1100

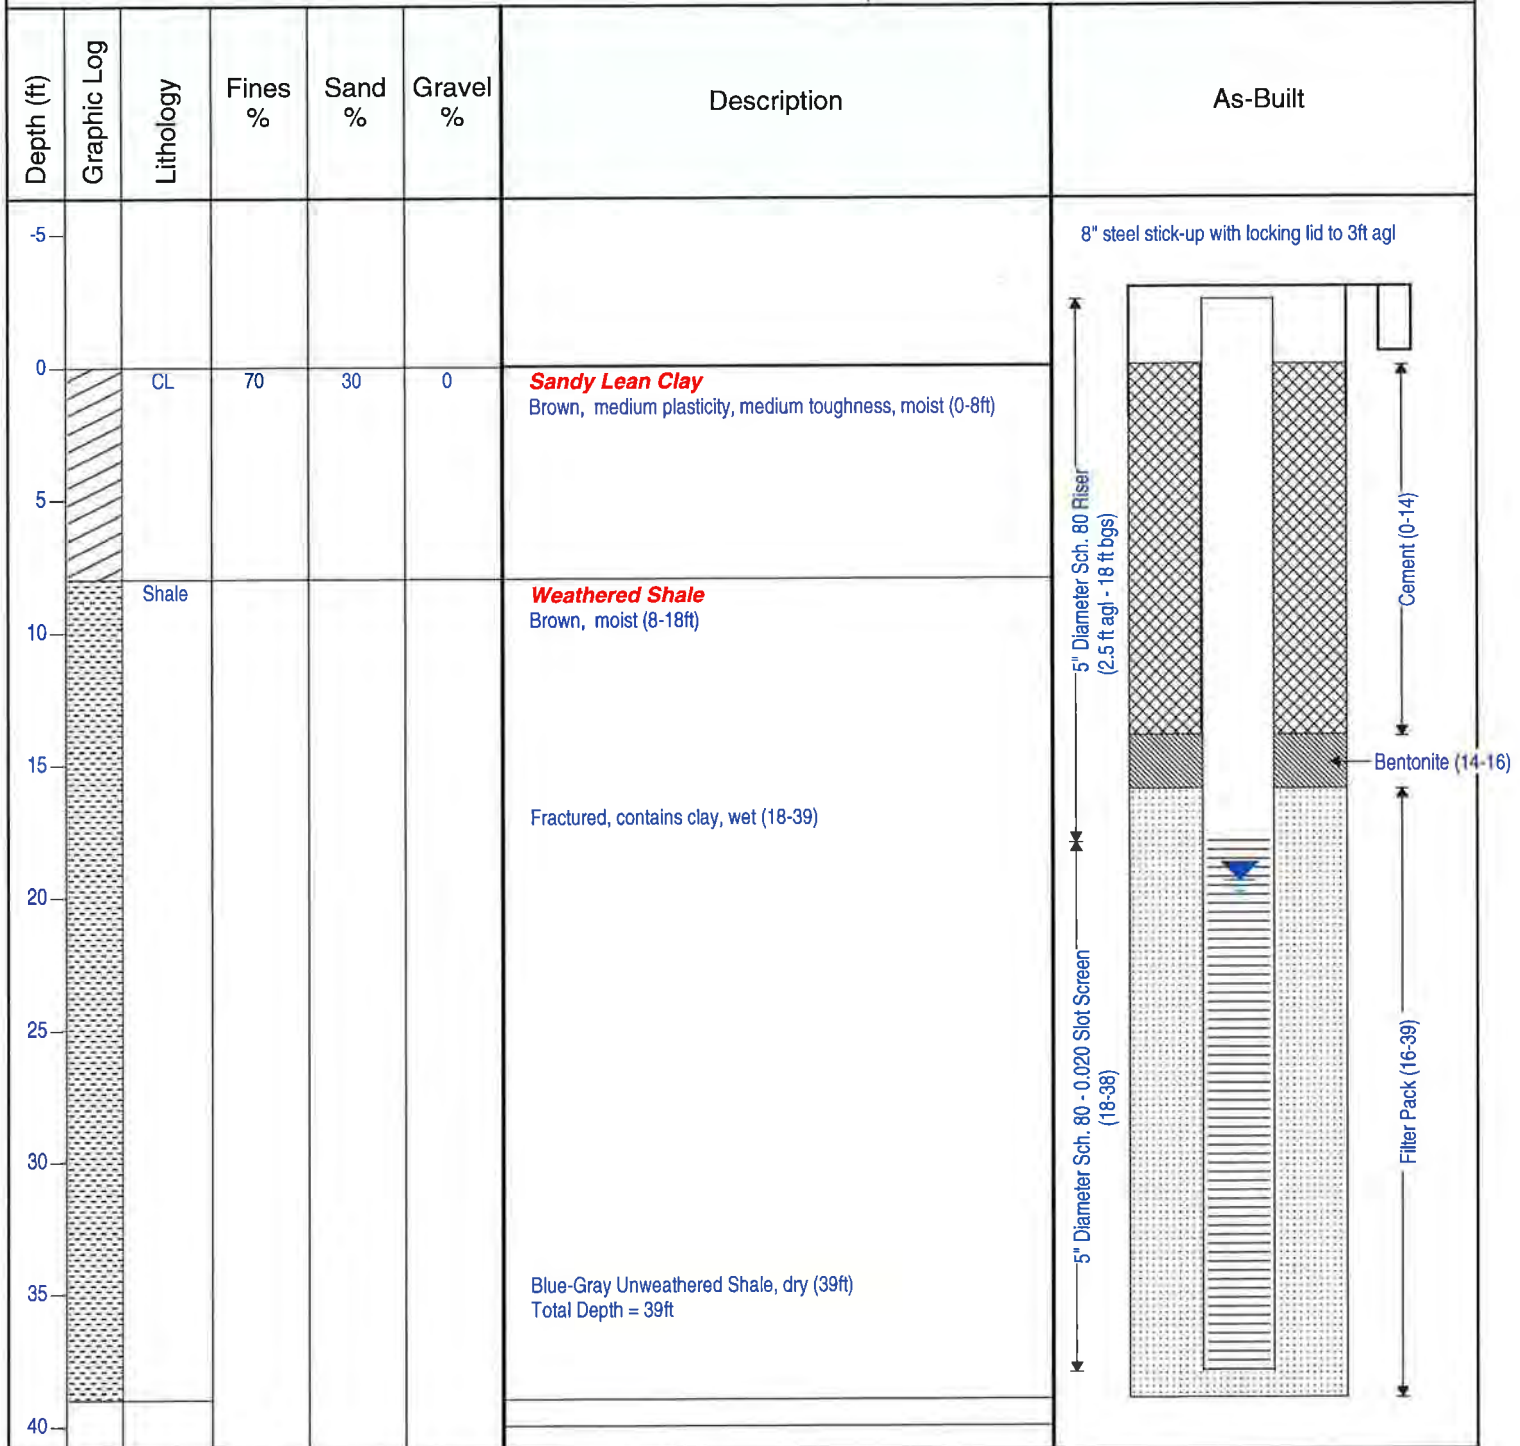**Job No.:** 23445947**Client:** Arizona Public Service**Project:** Phase II - Seepage Study**Location:** Four Corners Power Plant**Driller:** Boart Longyear**Drilling Method:** Rotosonic (SR121)**Sampling Method:** Continuous Core/Grab Sampling**Logged by:** Derrick Maurer**Boring No. L2-1358****Alternate ID:** MW-39**Start Time:** 1140**Start Date:** 9/26/10**Finish Time:** 1400**Finish Date:** 9/26/10**Depth to Groundwater:** 19.45 ft bgs 9/29/10**Surface Elevation:** 5089.967

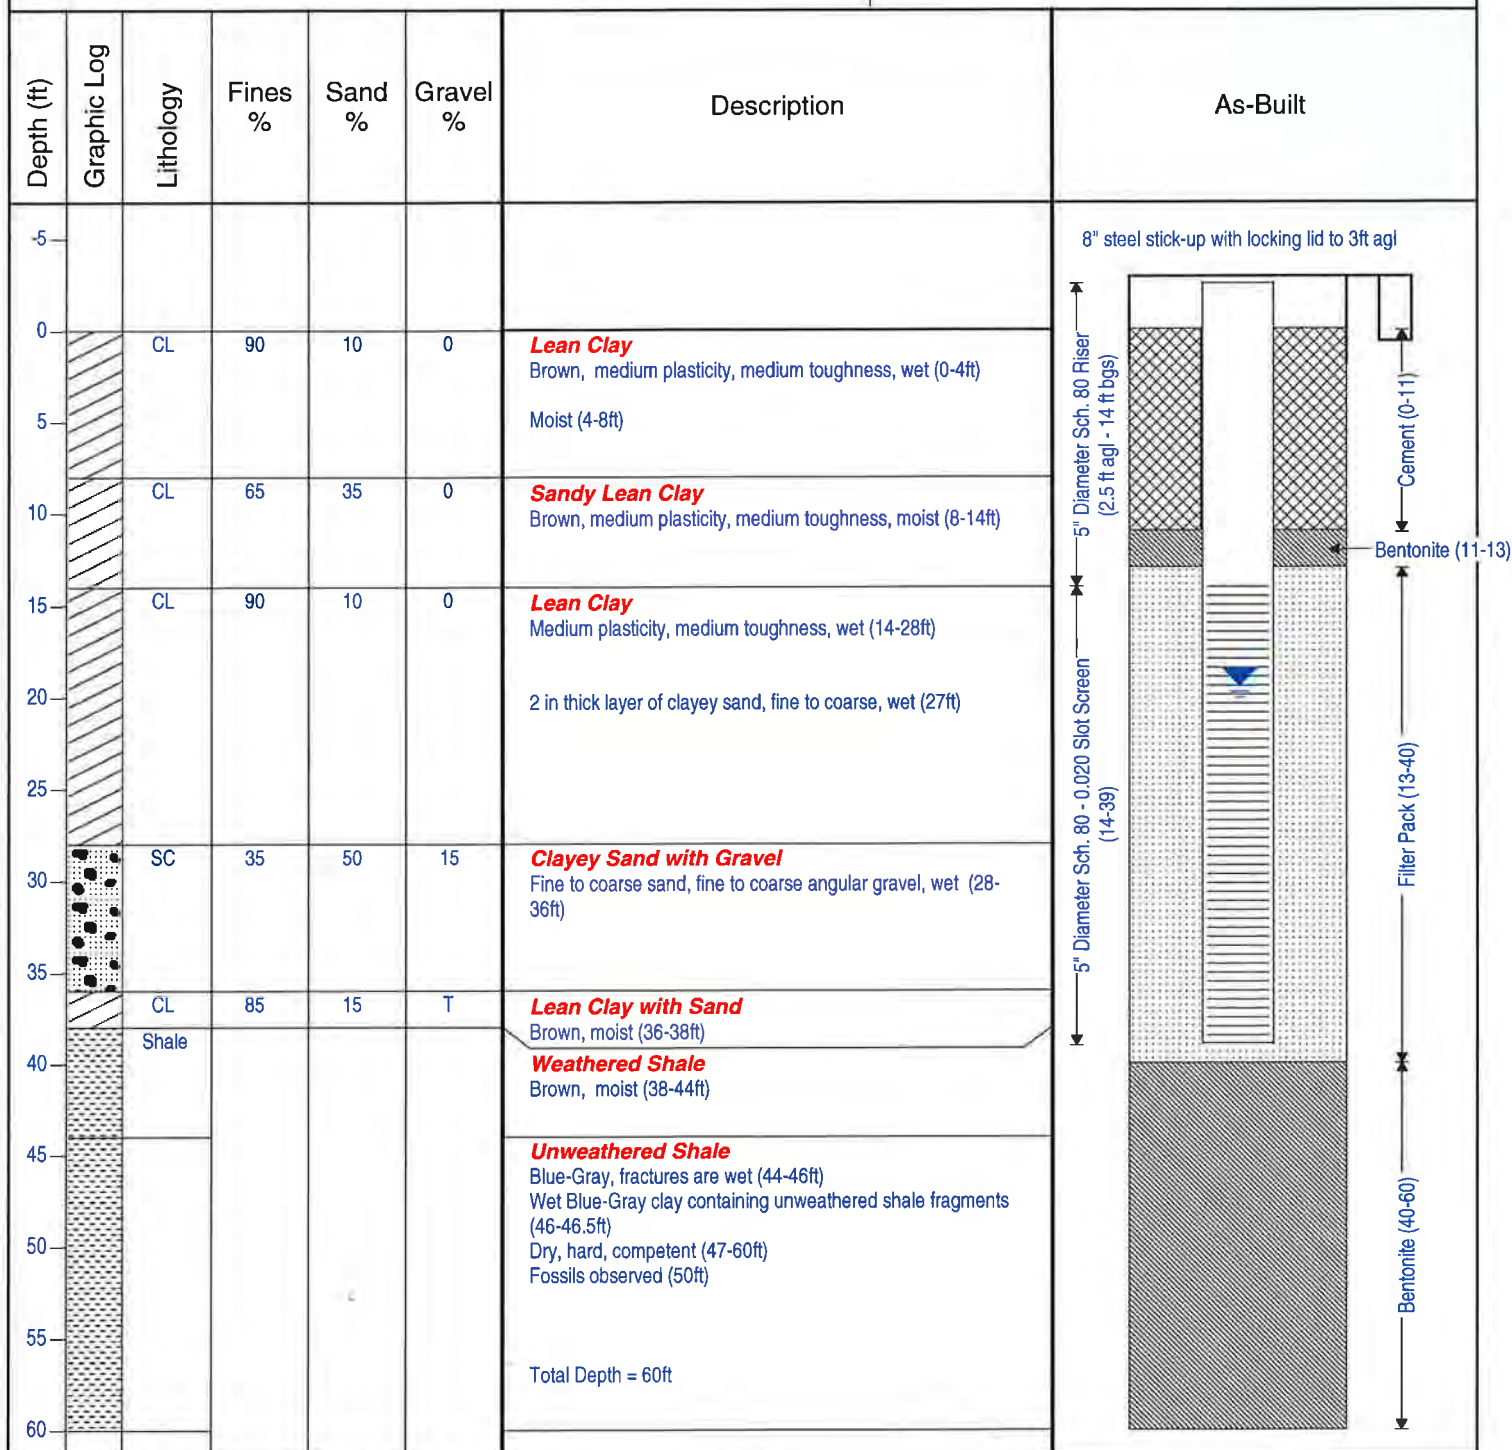

**Job No.:** 23445947**Client:** Arizona Public Service**Project:** Phase II - Seepage Study**Location:** Four Corners Power Plant**Driller:** Boart Longyear**Drilling Method:** Rotosonic (SR121)**Sampling Method:** Continuous Core/Grab Sampling**Logged by:** Derrick Maurer**Boring No. L2-1158****Alternate ID:** MW-38**Start Time:** 0930**Start Date:** 9/24/10**Finish Time:** 1355**Finish Date:** 9/24/10**Depth to Groundwater:** 19.41 ft bgs 9/25/10**Surface Elevation:** 5089.685

**Job No.:** 23445947**Client:** Arizona Public Service**Project:** Phase II - Seepage Study**Location:** Four Corners Power Plant**Driller:** Boart Longyear**Drilling Method:** Rotasonic (SR121)**Sampling Method:** Continuous Core/Grab Sampling**Logged by:** Derrick Maurer**Boring No. EW-14****Alternate ID:****Start Time:** 0950**Start Date:** 9/25/10**Finish Time:** 1535**Finish Date:** 9/25/10**Depth to Groundwater:** 26.07 ft bgs 9/29/10**Surface Elevation:** 5076.340

Depth (ft)	Graphic Log	Lithology	Fines %	Sand %	Gravel %	Description	As-Built
-5							
0		SC	20	80	0	<b>Clayey Sand</b> Brown, fine to medium grained, moist (0-12ft)  Loose (7-12ft)	8" steel stick-up with locking lid to 1ft agl
5							
10							
15		CL	80	20	0	<b>Lean Clay with Sand</b> Brown, medium plasticity, medium toughness, moist (12-20ft)  Wet (20-25ft)	5" Diameter Sch. 80 Riser (0.5 ft agl - 18 ft bgs)
20							
25		CL	65	35	T	<b>Sandy Lean Clay</b> Medium plasticity, medium toughness, wet (25-39ft)	Bentonite (12-16)
30							
35							
40		SP	NM	NM	NM	<b>Sand</b> Brown, poorly graded, fine to medium grained, wet (39-43ft)	5" Diameter Sch. 80 - 0.020 Slot Screen (18-48)
45		Shale				<b>Weathered Shale</b> Brown, fractured, iron staining, moist (43-49ft)  Total Depth = 49ft	Filter Pack (16-49)
50							



7720 North 16th St., Suite 100  
Phoenix, Arizona 85020  
(602) 371-1100

**Job No.:** 23445947**Client:** Arizona Public Service**Project:** Phase II - Seepage Study**Location:** Four Corners Power Plant**Driller:** Boart Longyear**Drilling Method:** Rotasonic (SR121)**Sampling Method:** Continuous Core/Grab Sampling**Logged by:** Derrick Maurer**Boring No. EW-15****Alternate ID:****Start Time:** 1640**Start Date:** 9/26/10**Finish Time:** 1100**Finish Date:** 9/27/10**Depth to Groundwater:** 28.05 ft bgs 9/29/10**Surface Elevation:** 5074.279

Depth (ft)	Graphic Log	Lithology	Fines %	Sand %	Gravel %	Description	As-Built
-5							
0		CL	70	30	0	<b>Sandy Lean Clay</b> Brown, medium plasticity, medium toughness, moist (0-9ft)	8" steel stick-up with locking lid to 1ft agl
5							
10		CL	90	10	0	<b>Lean Clay</b> Dark Brown, medium plasticity, medium toughness, moist (9-17ft)	5" Diameter Sch. 80 Riser (0.5 ft agl - 19 ft bgs)
15							
20		CL	70	30	0	<b>Sandy Lean Clay</b> Medium plasticity, medium toughness, moist (17-19ft)	
25		CL	90	10	0	<b>Lean Clay</b> Medium plasticity, medium toughness, wet (19-23ft)	Cement (0-15)
30		SC	40	60	0	<b>Clayey Sand</b> Fine to medium grained, wet (23-25ft)	Bentonite (15-17)
35		CL	90	10	0	<b>Lean Clay</b> Medium Plasticity, medium toughness, wet (25-36ft)	
40		SP	95	5	T	<b>Sand</b> Poorly graded, fine to medium grained, wet (36-47ft)	5" Diameter Sch. 80 - 0.020 Slot Screen (19-49)
45							
50		CL	90	10	0	<b>Lean Clay</b> Brown and black, wet (47-50ft) Total Depth = 50ft	Filter Pack (17-50)



7720 North 16th St., Suite 100  
Phoenix, Arizona 85020  
(602) 371-1100






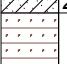

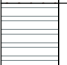
Borehole: SB-11+00

**PROJECT:** Four Corners Power Plant  
**CLIENT:** APS  
**LOCATION:** Fruitland, NM  
**URS PROJECT #:** 23446275

**DRILLING METHOD:** Air Rotary with ODEX  
**LOGGED BY:** Derrick Maurer  
**START DATE/TIME:** 9/28/2012 8:32:00 AM  
**FINISH DATE/TIME:** 9/28/2012 10:54:00 AM

**COMMENTS:** Elevations surveyed by Souder, Miller and Associates on 10/05/2012

**COORDINATES(NAD83):** East: 2522013.701  
North: 2070991.516  
**TOP OF GROUND ELEVATION (NAVD88):** 5098.285 feet A.S.L.

DEPTH (ft)	MOISTURE CONTENT	Drilling Rate (ft/min)	GRAPHIC LOG	Lithology Depth	MATERIAL DESCRIPTION
0					
	dry	0.7			CLAYEY SAND, (SC) brown, fine to medium grained, dry
10		0.7			
20	moist	0.3		20.0	WEATHERED SHALE, completely weathered, brown, moist
30		1.0			
	recovery = 0.02 ft/min recovery = 0.125 ft/min	1.0			
40	dry	1.0		40.0	UNWEATHERED SHALE, blue gray, dry
				45.0	

Total Depth of borehole = 45.0 feet  
Static Water Level = 27.7 ft bgs



Borehole: SB-12+50

**PROJECT:** Four Corners Power Plant  
**CLIENT:** APS  
**LOCATION:** Fruitland, NM  
**URS PROJECT #:** 23446275

**DRILLING METHOD:** Air Rotary with ODEX  
**LOGGED BY:** Derrick Maurer  
**START DATE/TIME:** 9/28/2012 11:42:00 AM  
**FINISH DATE/TIME:** 9/28/2012 1:35:00 PM

**COMMENTS:** Elevations surveyed by Souder, Miller and Associates on 10/05/2012

**COORDINATES(NAD83):** East: 2521928.202  
North: 2070875.618  
**TOP OF GROUND ELEVATION (NAVD88):** 5097.706 feet A.S.L.

DEPTH (ft)	MOISTURE CONTENT	Drilling Rate (ft/min)	GRAPHIC LOG	Lithology Depth	MATERIAL DESCRIPTION
0					
10	dry	1.2		13.0	SANDY LEAN CLAY, (CL) brown, dry, medium plasticity, medium toughness
	moist to wet	2.5		17.0	POORLY GRADED SAND WITH GRAVEL, (SP) brown, fine to medium grained, gravel is subrounded to rounded mostly fine gravel, moist to wet at 16 ft bgs
20	moist	0.4			WEATHERED SHALE, moist
30		1.0			
40	dry	1.0		42.0	UNWEATHERED SHALE, blue gray, dry
				48.0	
					Total Depth of borehole = 48.0 feet Static Water Level = 27.7 ft bgs













Borehole: SB-14+50

**PROJECT:** Four Corners Power Plant  
**CLIENT:** APS  
**LOCATION:** Fruitland, NM  
**URS PROJECT #:** 23446275

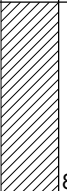**DRILLING METHOD:** Air Rotary with ODEX  
**LOGGED BY:** Derrick Maurer  
**START DATE/TIME:** 9/27/2012 11:30:00 AM  
**FINISH DATE/TIME:** 9/27/2012 2:40:00 PM

**COMMENTS:** Elevations surveyed by Souder, Miller and Associates on 10/05/2012

**COORDINATES(NAD83):** East: 2521827.858  
North: 2070696.405  
**TOP OF GROUND ELEVATION (NAVD88):** 5091.524 feet A.S.L.

DEPTH (ft)	MOISTURE CONTENT	Drilling Rate (ft/min)	GRAPHIC LOG	Lithology Depth	MATERIAL DESCRIPTION
0					
	dry	0.7		8.0	SANDY LEAN CLAY, (CL) brown, dry, medium plasticity, medium toughness
10					WEATHERED SHALE, brown, dry
20	moist 24 ft bgs possible water zone	1.0			
		1.0			
30					
	37-39 ft bgs mud/water	1.0			
40	dry	1.0		39.0	UNWEATHERED SHALE, blue gray, dry
				45.0	

Total Depth of borehole = 45.0 feet  
wet/muddy water detected at approx. 44 ft bgs, but no water level was recorded. possible water zones include  
37-39 ft bgs and approx. 24 ft bgs








Borehole: SB-16+50

**PROJECT:** Four Corners Power Plant  
**CLIENT:** APS  
**LOCATION:** Fruitland, NM  
**URS PROJECT #:** 23446275

**DRILLING METHOD:** Air Rotary with ODEX  
**LOGGED BY:** Derrick Maurer  
**START DATE/TIME:** 9/27/2012 2:52:00 PM  
**FINISH DATE/TIME:** 9/27/2012 4:00:00 PM

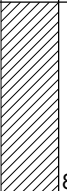**COMMENTS:** Elevations surveyed by Souder, Miller and Associates on 10/05/2012

**COORDINATES(NAD83):** East: 2521708.051  
North: 2070536.68  
**TOP OF GROUND ELEVATION (NAVD88):** 5087.07 feet A.S.L.

DEPTH (ft)	MOISTURE CONTENT	Drilling Rate (ft/min)	GRAPHIC LOG	Lithology Depth	MATERIAL DESCRIPTION
0					
	dry	1.6		8.0	SANDY LEAN CLAY, (CL) brown, dry, medium plasticity, medium toughness
10	dry	1.0			WEATHERED SHALE, dry
20	moist	1.0			
30	30-39 ft bgs possible water zone	1.0			
40	dry	1.0		39.0	UNWEATHERED SHALE, blue gray, dry
				45.0	
Water zone approx. 30-39 ft bgs					Total Depth of borehole = 45.0 feet Static Water Level = 27.7 ft bgs







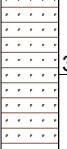

Borehole: SB-17+50

**PROJECT:** Four Corners Power Plant  
**CLIENT:** APS  
**LOCATION:** Fruitland, NM  
**URS PROJECT #:** 23446275

**DRILLING METHOD:** Air Rotary with ODEX  
**LOGGED BY:** Derrick Maurer  
**START DATE/TIME:** 9/28/2012 2:22:00 PM  
**FINISH DATE/TIME:** 9/28/2012 3:57:00 PM

**COMMENTS:** Elevations surveyed by Souder, Miller and Associates on 10/05/2012

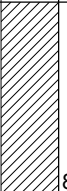**COORDINATES(NAD83):** East: 2521728.44  
North: 2070434.014  
**TOP OF GROUND ELEVATION (NAVD88):** 5088.654 feet A.S.L.

DEPTH (ft)	MOISTURE CONTENT	Drilling Rate (ft/min)	GRAPHIC LOG	Lithology Depth	MATERIAL DESCRIPTION
0					
	dry	1.0		8.0	SANDY LEAN CLAY, (CL) brown, dry, medium plasticity, medium toughness
10		0.7			WEATHERED SHALE, dry
20	moist	1.0			
30		1.0		35.0	
		1.0		39.0	WEATHERED/UNWEATHERED SHALE TRANSITION ZONE, cuttings change from weathered to unweathered shale several times
40	dry			45.0	UNWEATHERED SHALE, blue gray, dry

Total Depth of borehole = 45.0 feet  
Static Water Level = 15.30 ft bgs





Borehole: SB-21+50

**PROJECT:** Four Corners Power Plant  
**CLIENT:** APS  
**LOCATION:** Fruitland, NM  
**URS PROJECT #:** 23446275

**DRILLING METHOD:** Air Rotary with ODEX  
**LOGGED BY:** Morgan Wagoner  
**START DATE/TIME:** 9/30/2012 9:15:00 AM  
**FINISH DATE/TIME:** 9/30/2012 10:50:00 AM

**COMMENTS:** Elevations surveyed by Souder, Miller and Associates on 10/05/2012

**COORDINATES(NAD83):** East: 2521813.166  
North: 2070046.7  
**TOP OF GROUND ELEVATION (NAVD88):** 5090.018 feet A.S.L.

DEPTH (ft)	MOISTURE CONTENT	Drilling Rate (ft/min)	GRAPHIC LOG	Lithology Depth	MATERIAL DESCRIPTION
0					
	dry				SANDY LEAN CLAY, brown, dry, medium plasticity, medium toughness
		0.5		5.0	
	dry			7.0	CLAYEY SAND WITH GRAVEL, brown, well rounded, fine to medium grained, dry
					WEATHERED SHALE, brown
10	moist				
		0.4			
		0.6			
20	moist				
		1.2			
30	moist				
				39.0	
40	dry				UNWEATHERED SHALE, blue
				45.0	

Total Depth of borehole = 45.0 feet  
Backfill to 37 ft bgs with bentonite chips





Borehole: SB-23+00

**PROJECT:** Four Corners Power Plant  
**CLIENT:** APS  
**LOCATION:** Fruitland, NM  
**URS PROJECT #:** 23446275

**DRILLING METHOD:** Air Rotary with ODEX  
**LOGGED BY:** Morgan Wagoner  
**START DATE/TIME:** 9/30/2012 11:40:00 AM  
**FINISH DATE/TIME:** 9/30/2012 1:00:00 PM

**COMMENTS:** Elevations surveyed by Souder, Miller and Associates on 10/05/2012

**COORDINATES(NAD83):** East: 2521831.251  
North: 2069888.422  
**TOP OF GROUND ELEVATION (NAVD88):** 5090.642 feet A.S.L.

DEPTH (ft)	MOISTURE CONTENT	Drilling Rate (ft/min)	GRAPHIC LOG	Lithology Depth	MATERIAL DESCRIPTION
0					
	dry				CLAYEY SAND, brown, fine to medium grained, dry
		0.4			
10				10.0	
	moist	0.7			WEATHERED SHALE, brown
	▼				
	moist				
20		1.0			
	moist				
		1.0			
30					
	moist				
		1.0		39.0	
40					WEATHERED/UNWEATHERED SHALE TRANSITION ZONE, blue brown
	dry			43.0	
					UNWEATHERED SHALE, blue gray
				48.0	

Total Depth of borehole = 48.0 feet

DTW = ND (tagged bottom at 47 ft bgs), backfill with bentonite chips to 35 ft bgs, Static water level = 16.50 ft bgs



Borehole: SB-25+50

**PROJECT:** Four Corners Power Plant  
**CLIENT:** APS  
**LOCATION:** Fruitland, NM  
**URS PROJECT #:** 23446275

**DRILLING METHOD:** Air Rotary with ODEX  
**LOGGED BY:** Morgan Wagoner  
**START DATE/TIME:** 9/30/2012 2:05:00 PM  
**FINISH DATE/TIME:** 9/30/2012 3:21:00 PM

**COMMENTS:** Elevations surveyed by Souder, Miller and Associates on 10/05/2012

**COORDINATES(NAD83):** East: 2521892.337  
North: 2069648.361  
**TOP OF GROUND ELEVATION (NAVD88):** 5091.192 feet A.S.L.

DEPTH (ft)	MOISTURE CONTENT	Drilling Rate (ft/min)	GRAPHIC LOG	Lithology Depth	MATERIAL DESCRIPTION
0					
	dry moist	0.9			CLAYEY SAND, brown, fine to medium grained
		0.5		8.0	
10				10.0	POORLY GRADED SAND, well rounded, coarse grained
	moist				WEATHERED SHALE, brown, interbedded sandstone, chert, trace gypsum, and iron oxide staining
	moist	0.5		13.0	
					WEATHERED SHALE, brown
20	moist	0.5			
	moist	1.2			
30	moist	1.2			
40	dry	1.2		40.0	UNWEATHERED SHALE, blue gray
				45.0	

Total Depth of borehole = 45.0 feet

DTW = ND, mud on end of probe, backfill to 35 ft bgs with bentonite chips, static water level = 16.00 ft bgs



Borehole: SB-27+00

**PROJECT:** Four Corners Power Plant  
**CLIENT:** APS  
**LOCATION:** Fruitland, NM  
**URS PROJECT #:** 23446275

**DRILLING METHOD:** Air Rotary with ODEX  
**LOGGED BY:** Morgan Wagoner  
**START DATE/TIME:** 10/1/2012 8:50:00 AM  
**FINISH DATE/TIME:** 10/1/2012 10:40:00 AM

**COMMENTS:** Elevations surveyed by Souder, Miller and Associates on 10/05/2012

**COORDINATES(NAD83):** East: 2521915.591  
North: 2069511.338  
**TOP OF GROUND ELEVATION (NAVD88):** 5094.192 feet A.S.L.

DEPTH (ft)	MOISTURE CONTENT	Drilling Rate (ft/min)	GRAPHIC LOG	Lithology Depth	MATERIAL DESCRIPTION
0					
	dry	0.7			CLAYEY SAND, brown, fine to medium grained
		0.3			
10	moist				
				13.0	
	dry				WEATHERED SHALE, brown
20					
	dry				
	moist	0.7			
30		1.2			
	moist			38.0	
40					WEATHERED/UNWEATHERED SHALE TRANSITION ZONE, brown blue
				44.0	
					UNWEATHERED SHALE, blue gray
50				50.0	

Total Depth of borehole = 50.0 feet  
DTW = ND ( no mud), backfill to 23 ft bgs cave in to 25 ft bgs



Borehole: SB-28+00

**PROJECT:** Four Corners Power Plant  
**CLIENT:** APS  
**LOCATION:** Fruitland, NM  
**URS PROJECT #:** 23446275

**DRILLING METHOD:** Air Rotary with ODEX  
**LOGGED BY:** Morgan Wagoner  
**START DATE/TIME:** 10/1/2012 11:45:00 AM  
**FINISH DATE/TIME:** 10/1/2012 1:05:00 PM

**COMMENTS:** Elevations surveyed by Souder, Miller and Associates on 10/05/2012

**COORDINATES(NAD83):** East: 2521938.364  
North: 2069406.566  
**TOP OF GROUND ELEVATION (NAVD88):** 5095.344 feet A.S.L.

DEPTH (ft)	MOISTURE CONTENT	Drilling Rate (ft/min)	GRAPHIC LOG	Lithology Depth	MATERIAL DESCRIPTION
0					
	dry	0.7		8.0	SANDY LEAN CLAY WITH GRAVEL, brown, subangular to subrounded
10				12.0	CLAYEY SAND, brown, shale fragments
	dry	0.9		20.0	SANDY LEAN CLAY, brown, subangular to subrounded
20				24.0	CLAYEY SAND WITH GRAVEL, brown, fine to coarse grained, sandstone fragments
	moist	0.6			WEATHERED SHALE, brown
30	moist	1.0		38.0	
	dry			43.0	UNWEATHERED SHALE, blue gray

Total Depth of borehole = 43.0 feet

DTW = ND, mud from 41 to 43 ft bgs, backfill to 35.5 ft bgs with bentonite chips



Borehole: SB-30+00

**PROJECT:** Four Corners Power Plant  
**CLIENT:** APS  
**LOCATION:** Fruitland, NM  
**URS PROJECT #:** 23446275

**DRILLING METHOD:** Air Rotary with ODEX  
**LOGGED BY:** Morgan Wagoner  
**START DATE/TIME:** 10/2/2012 8:00:00 AM  
**FINISH DATE/TIME:** 10/2/2012 9:17:00 AM

**COMMENTS:** Elevations surveyed by Souder, Miller and Associates on 10/05/2012

**COORDINATES(NAD83):** East: 2521977.148  
North: 2069197.62  
**TOP OF GROUND ELEVATION (NAVD88):** 5095.089 feet A.S.L.

DEPTH (ft)	MOISTURE CONTENT	Drilling Rate (ft/min)	GRAPHIC LOG	Lithology Depth	MATERIAL DESCRIPTION
0					
	dry				SANDY LEAN CLAY, (CL) brown, medium plasticity, medium toughness
				5.0	
	dry				WEATHERED SHALE, brown
10					
	moist				
20					
	▼ moist				
30					
	moist				
40					
	dry			41.0	
					UNWEATHERED SHALE, blue gray
				47.0	

Total Depth of borehole = 47.0 feet  
DTW = ND mud on end of probe, backfill to 37 ft by








Borehole: SB-32+50

**PROJECT:** Four Corners Power Plant  
**CLIENT:** APS  
**LOCATION:** Fruitland, NM  
**URS PROJECT #:** 23446275

**DRILLING METHOD:** Air Rotary with ODEX  
**LOGGED BY:** Morgan Wagoner  
**START DATE/TIME:** 10/2/2012 10:00:00 AM  
**FINISH DATE/TIME:** 10/2/2012 11:20:00 AM

**COMMENTS:** Elevations surveyed by Souder, Miller and Associates on 10/05/2012

**COORDINATES(NAD83):** East: 2522028.187  
North: 2068961.01  
**TOP OF GROUND ELEVATION (NAVD88):** 5094.564 feet A.S.L.

DEPTH (ft)	MOISTURE CONTENT	Drilling Rate (ft/min)	GRAPHIC LOG	Lithology Depth	MATERIAL DESCRIPTION
0					
	dry	0.4			CLAYEY SAND, (SC) brown, subrounded, fine to coarse grained
10					
	dry	0.5		13.0	WEATHERED SHALE, brown
20					
	moist				
	moist	1.0		36.0	UNWEATHERED SHALE, blue gray
30					
	dry				
40				41.0	

Total Depth of borehole = 41.0 feet  
DTW = ND (mud on bottom of 1.5 inches of probe, backfill to 31 ft bgs with bentonite chips)



Borehole: SB-34+50

**PROJECT:** Four Corners Power Plant  
**CLIENT:** APS  
**LOCATION:** Fruitland, NM  
**URS PROJECT #:** 23446275

**DRILLING METHOD:** Air Rotary with ODEX  
**LOGGED BY:** Morgan Wagoner  
**START DATE/TIME:** 10/2/2012 12:45:00 PM  
**FINISH DATE/TIME:** 10/2/2012 1:50:00 PM

**COMMENTS:** Elevations surveyed by Souder, Miller and Associates on 10/05/2012

**COORDINATES(NAD83):** East: 2522071.55  
North: 2068766.982  
**TOP OF GROUND ELEVATION (NAVD88):** 5094.649 feet A.S.L.

DEPTH (ft)	MOISTURE CONTENT	Drilling Rate (ft/min)	GRAPHIC LOG	Lithology Depth	MATERIAL DESCRIPTION
0					
	dry				SANDY LEAN CLAY, brown, medium plasticity, medium toughness
	moist	0.7			
10					
	moist			15.0	CLAYEY SAND, brown, fine to medium grained, pieces of broken sandstone
	moist			18.0	WEATHERED SHALE, brown
20					
		1.0			
30	moist				
				37.0	WEATHERED/UNWEATHERED SHALE TRANSITION ZONE, brown blue
40	dry	1.0		40.0	UNWEATHERED SHALE, blue gray
	dry			45.0	

Total Depth of borehole = 45.0 feet

DTW = ND tape wet from 28 to 29 ft bg, backfill to 35.5 ft bgs with bentonite chips, static water level = 19.32 ft bgs







Borehole: SB-38+00

**PROJECT:** Four Corners Power Plant  
**CLIENT:** APS  
**LOCATION:** Fruitland, NM  
**URS PROJECT #:** 23446275

**DRILLING METHOD:** Air Rotary with ODEX  
**LOGGED BY:** Morgan Wagoner  
**START DATE/TIME:** 10/2/2012 2:38:00 PM  
**FINISH DATE/TIME:** 10/2/2012 3:50:00 PM

**COMMENTS:** Elevations surveyed by Souder, Miller and Associates on 10/05/2012

**COORDINATES(NAD83):** East: 2522135.217  
North: 2068431.799  
**TOP OF GROUND ELEVATION (NAVD88):** 5092.789 feet A.S.L.

DEPTH (ft)	MOISTURE CONTENT	Drilling Rate (ft/min)	GRAPHIC LOG	Lithology Depth	MATERIAL DESCRIPTION
0					
	dry	0.7			SANDY LEAN CLAY, (CL) brown, medium plasticity, medium toughness
10	dry			10.0	
	moist	0.7			WEATHERED SHALE, brown
20					
	moist	0.7			
30		1.0			
	moist				
40	dry			38.0	
				42.0	UNWEATHERED SHALE, blue gray

Total Depth of borehole = 42.0 feet  
DTW = ND (mud on tape from 21 to 26 ft bgs, backfill to 33.5 ft bgs with bentonite chips)



Borehole: SB-42+30

**PROJECT:** Four Corners Power Plant  
**CLIENT:** APS  
**LOCATION:** Fruitland, NM  
**URS PROJECT #:** 23446275

**DRILLING METHOD:** Air Rotary with ODEX  
**LOGGED BY:** Morgan Wagoner  
**START DATE/TIME:** 10/3/2012 7:50:00 AM  
**FINISH DATE/TIME:** 10/3/2012 11:40:00 AM

**COMMENTS:** Elevations surveyed by Souder, Miller and Associates on 10/05/2012

**COORDINATES(NAD83):** East: 2522212.363  
North: 2068008.416  
**TOP OF GROUND ELEVATION (NAVD88):** 5091.092 feet A.S.L.

DEPTH (ft)	MOISTURE CONTENT	Drilling Rate (ft/min)	GRAPHIC LOG	Lithology Depth	MATERIAL DESCRIPTION
0					
	moist	0.1			SANDY LEAN CLAY, brown, medium plasticity, medium toughness
	dry				
10				11.0	
	moist				WEATHERED SHALE, brown, (possible alluvium) cuttings poor and poor recovery
	wet - water coming out of borehole	0.7			
20					(23-32) cuttings poor, mostly water
	moist	1.0			
30					
	dry			45.0	
40					UNWEATHERED SHALE, blue gray
50				51.0	

Total Depth of borehole = 51.0 feet

DTW = 20.5 ft bgs, Saturated zone = 23 to 30 ft bgs, static water level = 17.00 ft bgs



Borehole: SB-44+00

**PROJECT:** Four Corners Power Plant  
**CLIENT:** APS  
**LOCATION:** Fruitland, NM  
**URS PROJECT #:** 23446275

**DRILLING METHOD:** Air Rotary with ODEX  
**LOGGED BY:** Morgan Wagoner  
**START DATE/TIME:** 10/4/2012 7:35:00 AM  
**FINISH DATE/TIME:** 10/4/2012 12:40:00 PM

**COMMENTS:** Elevations surveyed by Souder, Miller and Associates on 10/05/2012

**COORDINATES(NAD83):** East: 2522264.719  
North: 2067801.233  
**TOP OF GROUND ELEVATION (NAVD88):** 5088.044 feet A.S.L.

DEPTH (ft)	MOISTURE CONTENT	Drilling Rate (ft/min)	GRAPHIC LOG	Lithology Depth	MATERIAL DESCRIPTION
0					
10	moist	1.2			CLAYEY SAND, brown, fine to medium grained
20	wet	0.9			
30	moist			27.0	WELL GRADED SAND WITH GRAVEL, fine to coarse grained, fragments of sandstone, some clay
40	dry	0.7		30.0	WEATHERED SHALE, brown
				42.0	UNWEATHERED SHALE, blue gray
				47.0	

Total Depth of borehole = 47.0 feet

DTW = ND tape muddy from 36 to 47 ft bgs, backfill to 37.4 ft bgs with bentonite chips







Borehole: SB-46+00

**PROJECT:** Four Corners Power Plant  
**CLIENT:** APS  
**LOCATION:** Fruitland, NM  
**URS PROJECT #:** 23446275

**DRILLING METHOD:** Air Rotary with ODEX  
**LOGGED BY:** Morgan Wagoner  
**START DATE/TIME:** 10/4/2012 1:52:00 PM  
**FINISH DATE/TIME:** 10/4/2012 3:15:30 PM

**COMMENTS:** Elevations surveyed by Souder, Miller and Associates on 10/05/2012

**COORDINATES(NAD83):** East: 2522287.777  
North: 2067639.265  
**TOP OF GROUND ELEVATION (NAVD88):** 5088.635 feet A.S.L.

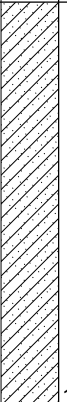DEPTH (ft)	MOISTURE CONTENT	Drilling Rate (ft/min)	GRAPHIC LOG	Lithology Depth	MATERIAL DESCRIPTION
0					
	moist	1.1			CLAYEY SAND, brown, fine to medium grained
10	moist				
	▼			17.0	
20	dry	0.7			WEATHERED SHALE, brown
30	dry				
	moist	0.7			
40	wet				
	wet dry			40.0	
				45.0	UNWEATHERED SHALE, blue gray

Total Depth of borehole = 45.0 feet  
DTW = 17.5 ft bgs, backfill to 38 ft bgs with bentonite chips, static water level = 17.275 ft bgs



Borehole: SB-47+00

**PROJECT:** Four Corners Power Plant  
**CLIENT:** APS  
**LOCATION:** Fruitland, NM  
**URS PROJECT #:** 23446275

**DRILLING METHOD:** Air Rotary with ODEX  
**LOGGED BY:** Adam Ford  
**START DATE/TIME:** 10/4/2012 4:20:00 PM  
**FINISH DATE/TIME:** 10/5/2012 8:06:00 AM

**COMMENTS:** Elevations surveyed by Souder, Miller and Associates on 10/05/2012

**COORDINATES(NAD83):** East: 2522305.977  
North: 2067541.382  
**TOP OF GROUND ELEVATION (NAVD88):** 5089.348 feet A.S.L.

DEPTH (ft)	MOISTURE CONTENT	Drilling Rate (ft/min)	GRAPHIC LOG	Lithology Depth	MATERIAL DESCRIPTION
0					
	dry	0.7			CLAYEY SAND, brown, fine to medium grained
10	moist	0.5		12.0	WEATHERED SHALE, brown
20					
30	moist wet dry	0.33		35.0	UNWEATHERED SHALE, blue gray
40				40.0	

Total Depth of borehole = 45.0 feet  
DTW = ND, backfill to 32.5 ft bgs with bentonite chips






Borehole: SB-48+00

**PROJECT:** Four Corners Power Plant  
**CLIENT:** APS  
**LOCATION:** Fruitland, NM  
**URS PROJECT #:** 23446275

**DRILLING METHOD:** Air Rotary with ODEX  
**LOGGED BY:** Adam Ford  
**START DATE/TIME:** 10/5/2012 9:12:00 AM  
**FINISH DATE/TIME:** 10/5/2012 10:52:00 AM

**COMMENTS:** Elevations surveyed by Souder, Miller and Associates on 10/05/2012

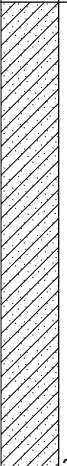**COORDINATES(NAD83):** East: 2522320.734  
North: 2067443.937  
**TOP OF GROUND ELEVATION (NAVD88):** 5087.052 feet A.S.L.

DEPTH (ft)	MOISTURE CONTENT	Drilling Rate (ft/min)	GRAPHIC LOG	Lithology Depth	MATERIAL DESCRIPTION
0					
	moist	0.4			CLAYEY SAND, brown, fine to medium grained
10	driller adding water at 14 ft bgs				
20	moist dry Stop adding water at 21 ft bgs	0.25		20.0	WEATHERED SHALE, brown
30	dry				
	dry			34.0	UNWEATHERED SHALE, blue gray
40		0.33		40.0	

Total Depth of borehole = 40.0 feet  
DTW = ND, backfill to 31 ft bgs with bentonite chips



Borehole: SB-48+50

**PROJECT:** Four Corners Power Plant  
**CLIENT:** APS  
**LOCATION:** Fruitland, NM  
**URS PROJECT #:** 23446275

**DRILLING METHOD:** Air Rotary with ODEX  
**LOGGED BY:** Adam Ford  
**START DATE/TIME:** 10/5/2012 11:52:00 AM  
**FINISH DATE/TIME:** 10/5/2012 12:52:00 PM

**COMMENTS:** Elevations surveyed by Souder, Miller and Associates on 10/05/2012

**COORDINATES(NAD83):** East: 2522314.892  
North: 2067386.156  
**TOP OF GROUND ELEVATION (NAVD88):** 5089.21 feet A.S.L.

DEPTH (ft)	MOISTURE CONTENT	Drilling Rate (ft/min)	GRAPHIC LOG	Lithology Depth	MATERIAL DESCRIPTION
0					
	dry				CLAYEY SAND, brown, fine to medium grained
10					
	moist moist			14.0	
		0.53			WEATHERED SHALE, brown
20					
		0.8			
30	moist				
		0.75		33.0	
	dry	0.75		35.0	UNWEATHERED SHALE, blue gray

Total Depth of borehole = 35.0 feet

DTW = ND, not mud on probe, backfill to 31' bgs with bentonite chips



Borehole: SB-51+50

**PROJECT:** Four Corners Power Plant**CLIENT:** APS**LOCATION:** Fruitland, NM**URS PROJECT #:** 23446275**DRILLING METHOD:** Air Rotary with ODEX**LOGGED BY:** Adam Ford**START DATE/TIME:** 10/5/2012 2:08:00 PM**FINISH DATE/TIME:** 10/5/2012 3:03:00 PM**COMMENTS:** Elevations surveyed by Souder, Miller and Associates on 10/05/2012**COORDINATES(NAD83): East:** 2522316.914**North:** 2067097.827**TOP OF GROUND ELEVATION (NAVD88):** 5091.97 feet A.S.L.

DEPTH (ft)	MOISTURE CONTENT	Drilling Rate (ft/min)	GRAPHIC LOG	Lithology Depth	MATERIAL DESCRIPTION
0					
				3.0	CLAYEY SAND, brown, fine to medium grained
				4.0	SANDSTONE
		0.5			WEATHERED SHALE, brown
10	dry				
	moist				
20		1.7			
	moist				
30					
	moist wet dry	0.9		35.0	UNWEATHERED SHALE, blue gray
				37.0	

Total Depth of borehole = 37.0 feet

DTW = 33.3, backfill to 34 ft bgs with bentonite chips, static water level on 10-6-12 = no water TD was 17.7 ft  
bgs possible bridging



Borehole: SB-53+50

**PROJECT:** Four Corners Power Plant  
**CLIENT:** APS  
**LOCATION:** Fruitland, NM  
**URS PROJECT #:** 23446275

**DRILLING METHOD:** Air Rotary with ODEX  
**LOGGED BY:** Adam Ford  
**START DATE/TIME:** 10/6/2012 7:53:00 AM  
**FINISH DATE/TIME:** 10/6/2012 8:40:00 AM

**COMMENTS:** Elevations surveyed by Souder, Miller and Associates on 10/05/2012

**COORDINATES(NAD83):** East: 2522305.543  
North: 2066873.537  
**TOP OF GROUND ELEVATION (NAVD88):** 5095.323 feet A.S.L.

DEPTH (ft)	MOISTURE CONTENT	Drilling Rate (ft/min)	GRAPHIC LOG	Lithology Depth	MATERIAL DESCRIPTION
0					
	dry				CLAYEY SAND, brown, fine to medium grained
		1.8		8.0	
	dry				
10				10.0	POORLY GRADED SAND, well rounded, coarse grained
	dry				WEATHERED SHALE, brown
	moist	1.8			
20					
		3.4			
	moist				
30					
				36.0	
	dry	2.1			UNWEATHERED SHALE, blue gray
40				41.0	

Total Depth of borehole = 41.0 feet  
DTW = ND, dry probe, backfill to 32 ft bgs with bentonite chips







Borehole: SB-57+50

**PROJECT:** Four Corners Power Plant  
**CLIENT:** APS  
**LOCATION:** Fruitland, NM  
**URS PROJECT #:** 23446275

**DRILLING METHOD:** Air Rotary with ODEX  
**LOGGED BY:** Adam Ford  
**START DATE/TIME:** 10/6/2012 10:56:00 AM  
**FINISH DATE/TIME:** 10/6/2012 11:55:00 AM

**COMMENTS:** Elevations surveyed by Souder, Miller and Associates on 10/05/2012

**COORDINATES(NAD83):** East: 2522316.455  
North: 2066489.949  
**TOP OF GROUND ELEVATION (NAVD88):** 5096.194 feet A.S.L.

DEPTH (ft)	MOISTURE CONTENT	Drilling Rate (ft/min)	GRAPHIC LOG	Lithology Depth	MATERIAL DESCRIPTION
0					
	dry	2.15			CLAYEY SAND, fine to medium grained, some well rounded gravel up to 1/2" diam.
	dry				
10		0.8		10.0	SANDSTONE, some gypsum and well rounded gravel
	dry			15.0	WEATHERED SHALE
20		2.12			
	▼				
30	dry moist				
		1.97		36.0	
	dry	1.4			UNWEATHERED SHALE, blue gray
40					
				41.0	

Total Depth of borehole = 41.0 feet

DTW = ND, dry probe, backfill to 31 ft bgs with bentonite chips, static water level = 25.2 ft bgs







Borehole: SB-59+50

**PROJECT:** Four Corners Power Plant  
**CLIENT:** APS  
**LOCATION:** Fruitland, NM  
**URS PROJECT #:** 23446275

**DRILLING METHOD:** Air Rotary with ODEX  
**LOGGED BY:** Adam Ford  
**START DATE/TIME:** 10/6/2012 12:30:00 PM  
**FINISH DATE/TIME:** 10/6/2012 1:21:00 PM

**COMMENTS:** Elevations surveyed by Souder, Miller and Associates on 10/05/2012

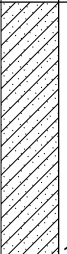**COORDINATES(NAD83):** East: 2522311.037  
North: 2066293.735  
**TOP OF GROUND ELEVATION (NAVD88):** 5094.514 feet A.S.L.

DEPTH (ft)	MOISTURE CONTENT	Drilling Rate (ft/min)	GRAPHIC LOG	Lithology Depth	MATERIAL DESCRIPTION
0					
	dry	1.76			CLAYEY SAND, fine to medium grained
10					
				11.0	
	dry moist	1.1			WEATHERED SHALE
20					
		1.67			
30					
	moist				
40				40.0	
		1.6			UNWEATHERED SHALE, blue gray
	dry			45.0	

Total Depth of borehole = 45.0 feet  
DTW = ND, dry probe, backfill to 36.1 ft bgs with bentonite chips






Borehole: SB-61+00

**PROJECT:** Four Corners Power Plant  
**CLIENT:** APS  
**LOCATION:** Fruitland, NM  
**URS PROJECT #:** 23446275

**DRILLING METHOD:** Air Rotary with ODEX  
**LOGGED BY:** Adam Ford  
**START DATE/TIME:** 10/6/2012 2:06:00 PM  
**FINISH DATE/TIME:** 10/6/2012 3:05:00 PM

**COMMENTS:** Elevations surveyed by Souder, Miller and Associates on 10/05/2012

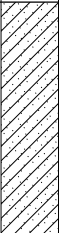**COORDINATES(NAD83):** East: 2522316.325  
North: 2066140.567  
**TOP OF GROUND ELEVATION (NAVD88):** 5093.626 feet A.S.L.

DEPTH (ft)	MOISTURE CONTENT	Drilling Rate (ft/min)	GRAPHIC LOG	Lithology Depth	MATERIAL DESCRIPTION
0					
	dry	1.3			CLAYEY SAND, fine to medium grained
10				10.0	
	dry moist	1.43			WEATHERED SHALE
20					
	moist	1.85			
30					
40	moist				
	dry			47.0	
50					UNWEATHERED SHALE, blue gray
				51.0	

Total Depth of borehole = 51.0 feet

DTW = ND, dry probe, backfill to 34.1 ft bgs with bentonite chips, static water level = ND - dry at 31.9 ft bgs














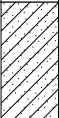

Borehole: SB-63+00

**PROJECT:** Four Corners Power Plant  
**CLIENT:** APS  
**LOCATION:** Fruitland, NM  
**URS PROJECT #:** 23446275

**DRILLING METHOD:** Air Rotary with ODEX  
**LOGGED BY:** Adam Ford  
**START DATE/TIME:** 10/6/2012 3:50:00 PM  
**FINISH DATE/TIME:** 10/7/2012 8:59:00 AM

**COMMENTS:** Elevations surveyed by Souder, Miller and Associates on 10/05/2012

**COORDINATES(NAD83):** East: 2522317.138  
North: 2065945.004  
**TOP OF GROUND ELEVATION (NAVD88):** 5093.66 feet A.S.L.

DEPTH (ft)	MOISTURE CONTENT	Drilling Rate (ft/min)	GRAPHIC LOG	Lithology Depth	MATERIAL DESCRIPTION
0					
	dry	1.25			CLAYEY SAND, fine to medium grained
	dry			5.0	
					WEATHERED SHALE
10					
	dry				
20					
		1.28			
				27.0	
	dry				Possible large gypsum deposit or gravelly concretous material with quartz and reddish angular rock
30	moist			30.0	
					WEATHERED SHALE
		2.15			
40					
	moist				
50					
	dry			50.0	
		1.3		53.0	UNWEATHERED SHALE, blue gray

Total Depth of borehole = 53.0 feet

DTW = ND, dry probe, backfill to 41.8 ft bgs with bentonite chips, static water level = 36.1 ft bgs




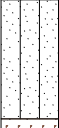

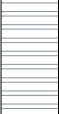
Borehole: SB-66+00

**PROJECT:** Four Corners Power Plant  
**CLIENT:** APS  
**LOCATION:** Fruitland, NM  
**URS PROJECT #:** 23446275

**DRILLING METHOD:** Air Rotary with ODEX  
**LOGGED BY:** Adam Ford  
**START DATE/TIME:** 10/7/2012 12:33:00 PM  
**FINISH DATE/TIME:** 10/7/2012 1:15:00 PM

**COMMENTS:** Elevations surveyed by Souder, Miller and Associates on 10/05/2012

**COORDINATES(NAD83):** East: 2522313.764  
North: 5065633.714  
**TOP OF GROUND ELEVATION (NAVD88):** 5094.071 feet A.S.L.

DEPTH (ft)	MOISTURE CONTENT	Drilling Rate (ft/min)	GRAPHIC LOG	Lithology Depth	MATERIAL DESCRIPTION
0					
	dry	2.1			CLAYEY SAND, fine to medium grained, some cobbles, well rounded, ranging in size to 1/2" diam.
				7.0	
					SILTY SAND, fine grained
10				12.0	
					WEATHERED SHALE
	dry				
20	moist	2.5			
		2.17			
30				35.0	
	moist dry				UNWEATHERED SHALE, blue gray
40				40.0	

Total Depth of borehole = 40.0 feet  
DTW = ND, dry probe, backfill to 30.1 ft bgs with bentonite chips







Borehole: SB-71+00

**PROJECT:** Four Corners Power Plant  
**CLIENT:** APS  
**LOCATION:** Fruitland, NM  
**URS PROJECT #:** 23446275

**DRILLING METHOD:** Air Rotary with ODEX  
**LOGGED BY:** Adam Ford  
**START DATE/TIME:** 10/7/2012 2:57:00 PM  
**FINISH DATE/TIME:** 10/7/2012 3:40:00 PM

**COMMENTS:** Elevations surveyed by Souder, Miller and Associates on 10/05/2012

**COORDINATES(NAD83):** East: 2522315.175  
North: 2065131.955  
**TOP OF GROUND ELEVATION (NAVD88):** 5093.499 feet A.S.L.

DEPTH (ft)	MOISTURE CONTENT	Drilling Rate (ft/min)	GRAPHIC LOG	Lithology Depth	MATERIAL DESCRIPTION
0					
	dry				CLAYEY SAND, fine to medium grained, some well rounded and angular cobbles
				8.0	(5-8) clayey sand with some sandstone
10		1.67		10.0	SANDSTONE
	dry moist				WEATHERED SHALE
20					
				32.0	
30		1.17			UNWEATHERED SHALE, blue gray
	dry			37.0	

Total Depth of borehole = 37.0 feet  
DTW = ND, dry probe, backfill to 28.4 ft bgs with bentonite chips





Borehole: SB-73+50

**PROJECT:** Four Corners Power Plant  
**CLIENT:** APS  
**LOCATION:** Fruitland, NM  
**URS PROJECT #:** 23446275

**DRILLING METHOD:** Air Rotary with ODEX  
**LOGGED BY:** Adam Ford  
**START DATE/TIME:** 10/7/2012 4:18:00 PM  
**FINISH DATE/TIME:** 10/7/2012 4:57:00 PM

**COMMENTS:** Elevations surveyed by Souder, Miller and Associates on 10/05/2012

**COORDINATES(NAD83):** East: 2522315.184  
North: 2064893.45  
**TOP OF GROUND ELEVATION (NAVD88):** 5094.396 feet A.S.L.

DEPTH (ft)	MOISTURE CONTENT	Drilling Rate (ft/min)	GRAPHIC LOG	Lithology Depth	MATERIAL DESCRIPTION
0					
	dry	2.0		7.0	CLAYEY SAND, fine to medium grained
10	dry	3.3			WEATHERED SHALE
20		1.5			
30	dry			34.0	UNWEATHERED SHALE, blue gray
40	dry			40.0	

Total Depth of borehole = 40.0 feet  
DTW = ND, dry probe, backfill to 30 ft bgs with bentonite chips



Borehole: SB-76+00

**PROJECT:** Four Corners Power Plant  
**CLIENT:** APS  
**LOCATION:** Fruitland, NM  
**URS PROJECT #:** 23446275

**DRILLING METHOD:** Air Rotary with ODEX  
**LOGGED BY:** Adam Ford  
**START DATE/TIME:** 10/8/2012 8:16:00 AM  
**FINISH DATE/TIME:** 10/8/2012 8:57:00 AM

**COMMENTS:** Elevations surveyed by Souder, Miller and Associates on 10/05/2012

**COORDINATES(NAD83):** East: 2522314.874  
North: 2064639.98  
**TOP OF GROUND ELEVATION (NAVD88):** 5097.048 feet A.S.L.

DEPTH (ft)	MOISTURE CONTENT	Drilling Rate (ft/min)	GRAPHIC LOG	Lithology Depth	MATERIAL DESCRIPTION
0					
	dry	2.1			CLAYEY SAND, fine to medium grained
10					
	dry	1.8			(11-14) some angular cobbles and sandstone
				14.0	
					WEATHERED SHALE
20					
	dry	2.83			
	moist				
30					
	moist				
	dry				
				36.0	
					UNWEATHERED SHALE, blue gray
40					
		1.26			
				41.0	

Total Depth of borehole = 41.0 feet

DTW = ND, dry probe, backfill to 30.1 ft bgs with bentonite chips, static water level = ND - dry at 28.9 ft bgs







Borehole: SB-78+00

**PROJECT:** Four Corners Power Plant  
**CLIENT:** APS  
**LOCATION:** Fruitland, NM  
**URS PROJECT #:** 23446275

**DRILLING METHOD:** Air Rotary with ODEX  
**LOGGED BY:** Adam Ford  
**START DATE/TIME:** 10/8/2012 9:46:00 AM  
**FINISH DATE/TIME:** 10/8/2012 10:34:00 AM

**COMMENTS:** Elevations surveyed by Souder, Miller and Associates on 10/05/2012

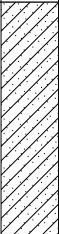**COORDINATES(NAD83):** East: 2522312.523  
North: 2064309.479  
**TOP OF GROUND ELEVATION (NAVD88):** 5105.286 feet A.S.L.

DEPTH (ft)	MOISTURE CONTENT	Drilling Rate (ft/min)	GRAPHIC LOG	Lithology Depth	MATERIAL DESCRIPTION
0					
10	dry	1.67		10.0	CLAYEY SAND, fine to medium grained
		1.16		15.0	POORLY GRADED SAND, coarse grained, well rounded cobbles up to 1" diam.
20	dry moist	2.6			WEATHERED SHALE
30					
40	moist dry			36.0	UNWEATHERED SHALE, blue gray
				41.0	

Total Depth of borehole = 41.0 feet  
DTW = ND, dry probe, backfill to 31 ft bgs with bentonite chips



7720 North 16th Street STE 100  
Phoenix, AZ

SHEET 1 of 2

## Borehole: MW-12R

**PROJECT:** Four Corners Power Plant

**CLIENT:** APS

**LOCATION:** Fruitland, NM

**URS PROJECT #:** 23446275

**DRILLING METHOD:** Rotasonic

**LOGGED BY:** Derrick Maurer

**START DATE/TIME:** 3/26/2012 2:53:00 PM

**FINISH DATE/TIME:** 3/27/2012 1:20:00 PM


**COMMENTS:** Surveyed by Souder, Miller and Associates: June 2012 PVC and steel casing were extended ten feet on 4/23/12

**COORDINATES (NAD83):**

**North:** 2068356.17

**East:** 2527509.566

**TOP OF GROUND ELEVATION (NAVD88):** 5261.71feet A.S.L.

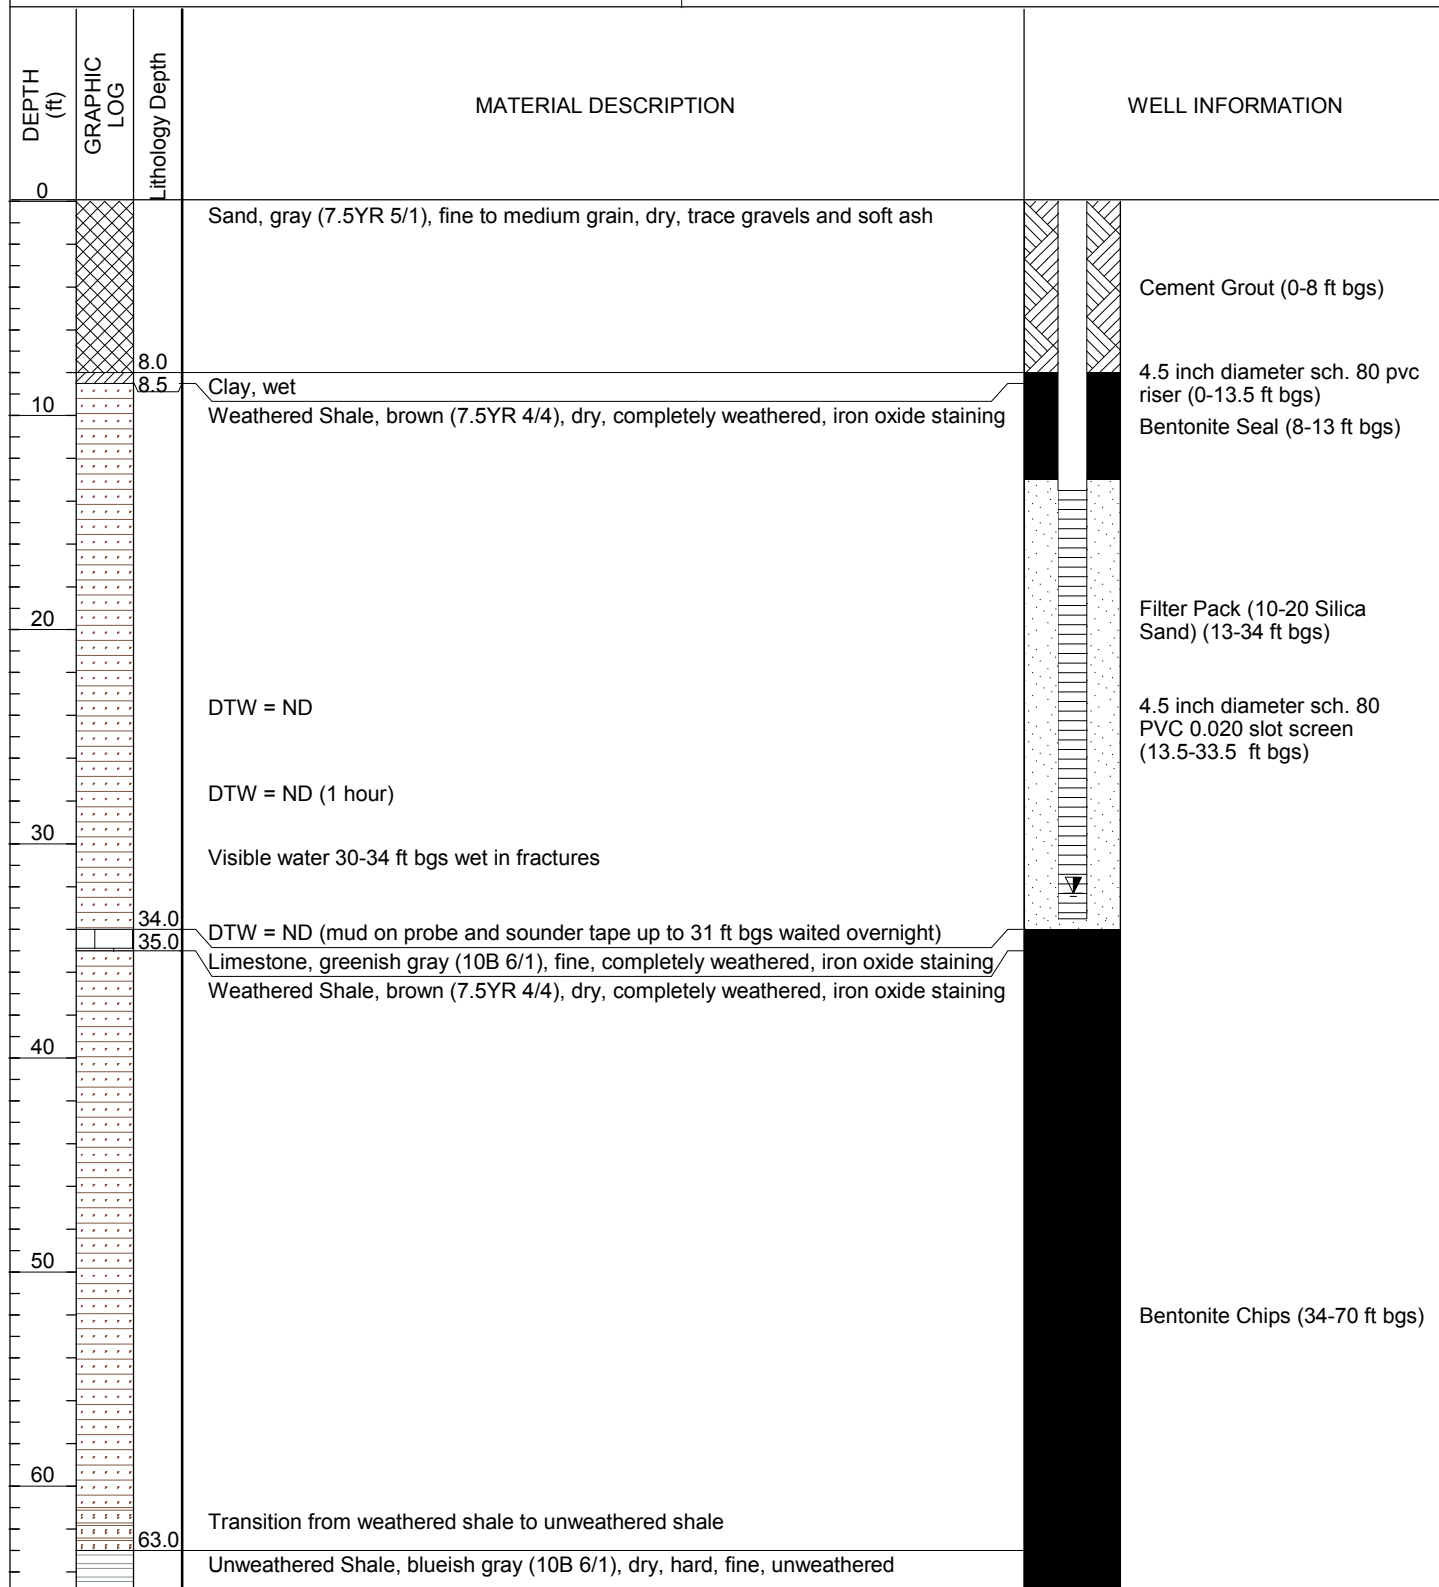





7720 North 16th Street STE 100  
Phoenix, AZ

SHEET 2 of 2

## Borehole: MW-12R

**PROJECT:** Four Corners Power Plant  
**CLIENT:** APS  
**LOCATION:** Fruitland, NM  
**URS PROJECT #:** 23446275

**DRILLING METHOD:** Rotosonic  
**LOGGED BY:** Derrick Maurer  
**START DATE/TIME:** 3/26/2012 2:53:00 PM  
**FINISH DATE/TIME:** 3/27/2012 1:20:00 PM

DEPTH (ft)	GRAPHIC LOG	Lithology Depth	MATERIAL DESCRIPTION	WELL INFORMATION
70		70.0	Unweathered Shale, blueish gray (10B 6/1), dry, hard, fine, unweathered ( <i>continued</i> )	

Total Depth of borehole = 70.0 feet



7720 North 16th Street STE 100  
Phoenix, AZ

SHEET 1 of 1

## Borehole: MW-40

**PROJECT:** Four Corners Power Plant

**CLIENT:** APS

**LOCATION:** Fruitland, NM

**URS PROJECT #:** 23446275

**DRILLING METHOD:** Rotasonic

**LOGGED BY:** Derrick Maurer

**START DATE/TIME:** 3/25/2012 8:20:00 AM

**FINISH DATE/TIME:** 3/25/2012 1:50:00 PM


**COMMENTS:** Surveyed by Souder, Miller and Associates: June 2012

**COORDINATES (NAD83):**

**North:** 2069609.076

**East:** 2523640.187

**TOP OF GROUND ELEVATION (NAVD88):** 5134.91feet A.S.L.

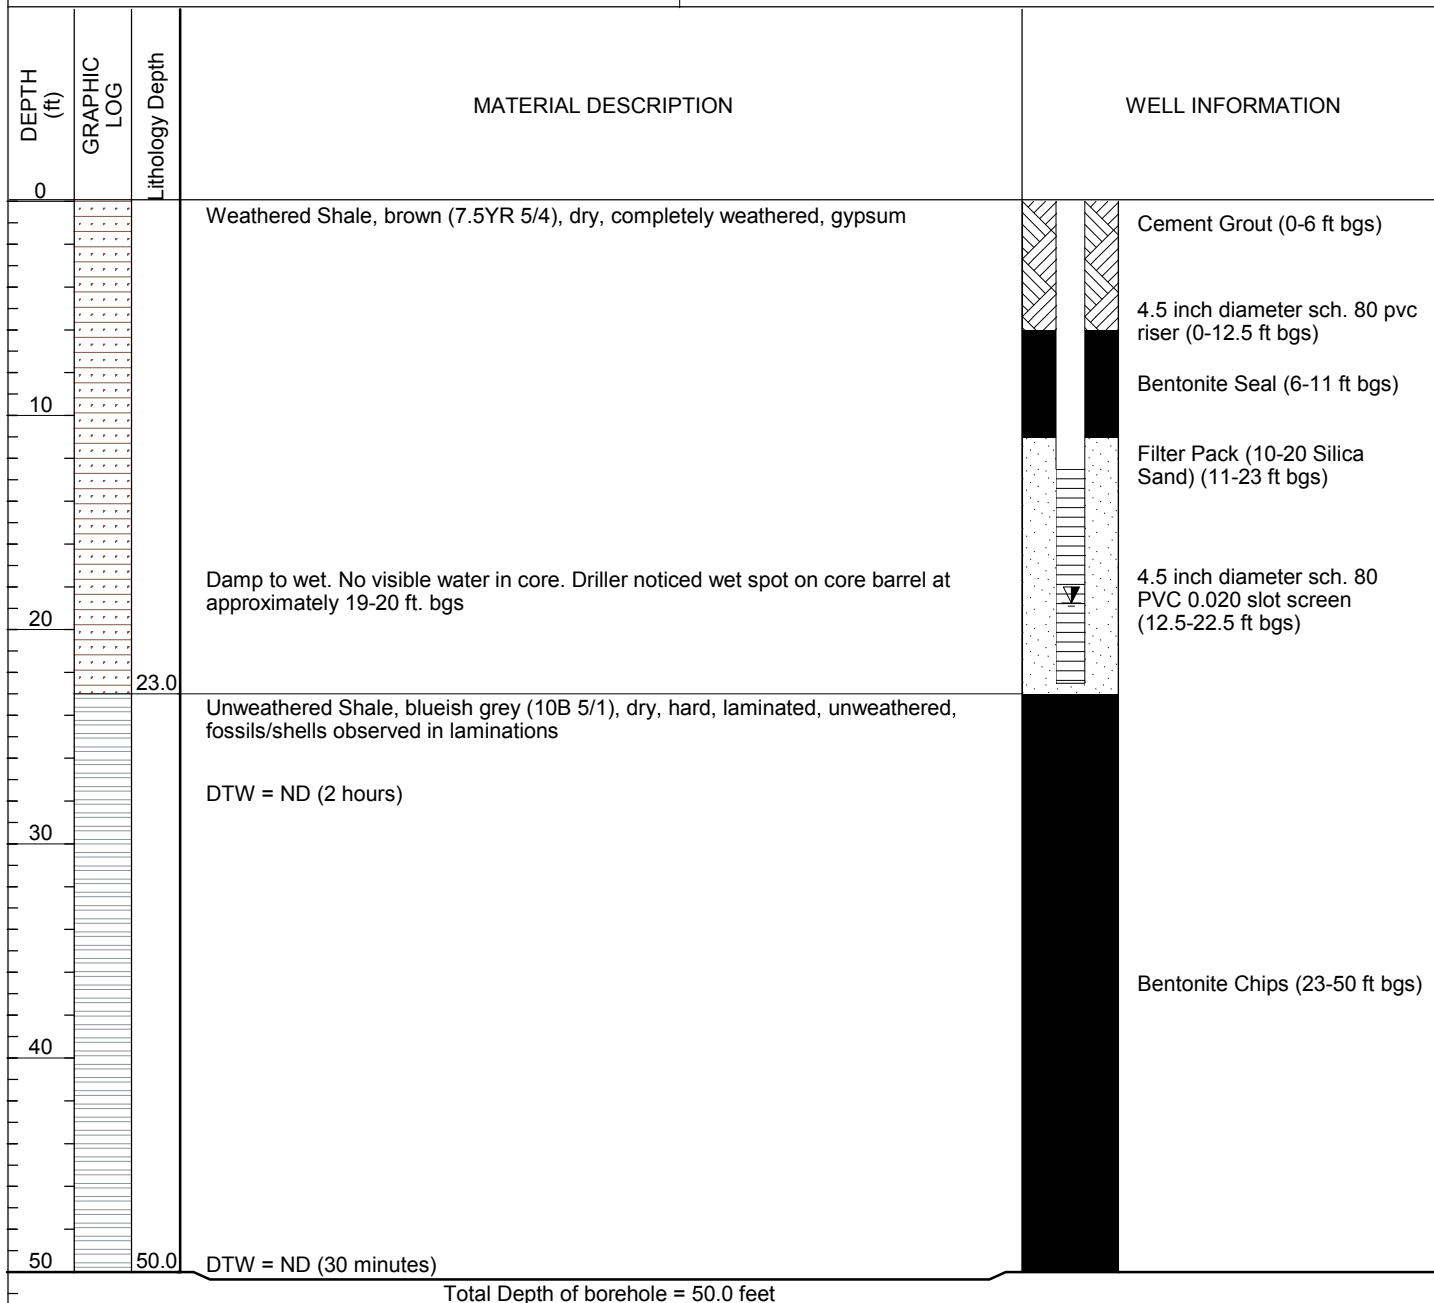



7720 North 16th Street STE 100  
Phoenix, AZ

SHEET 1 of 1

## Borehole: MW-41

**PROJECT:** Four Corners Power Plant

**CLIENT:** APS

**LOCATION:** Fruitland, NM

**URS PROJECT #:** 23446275

**DRILLING METHOD:** Rotasonic

**LOGGED BY:** Derrick Maurer

**START DATE/TIME:** 3/25/2012 4:37:00 PM

**FINISH DATE/TIME:** 3/26/2012 12:20:00 PM


**COMMENTS:** Surveyed by Souder, Miller and Associates: June 2012

**COORDINATES (NAD83):**

**North:** 2071279.193

**East:** 2527525.246

**TOP OF GROUND ELEVATION (NAVD88):** 5253.98feet A.S.L.

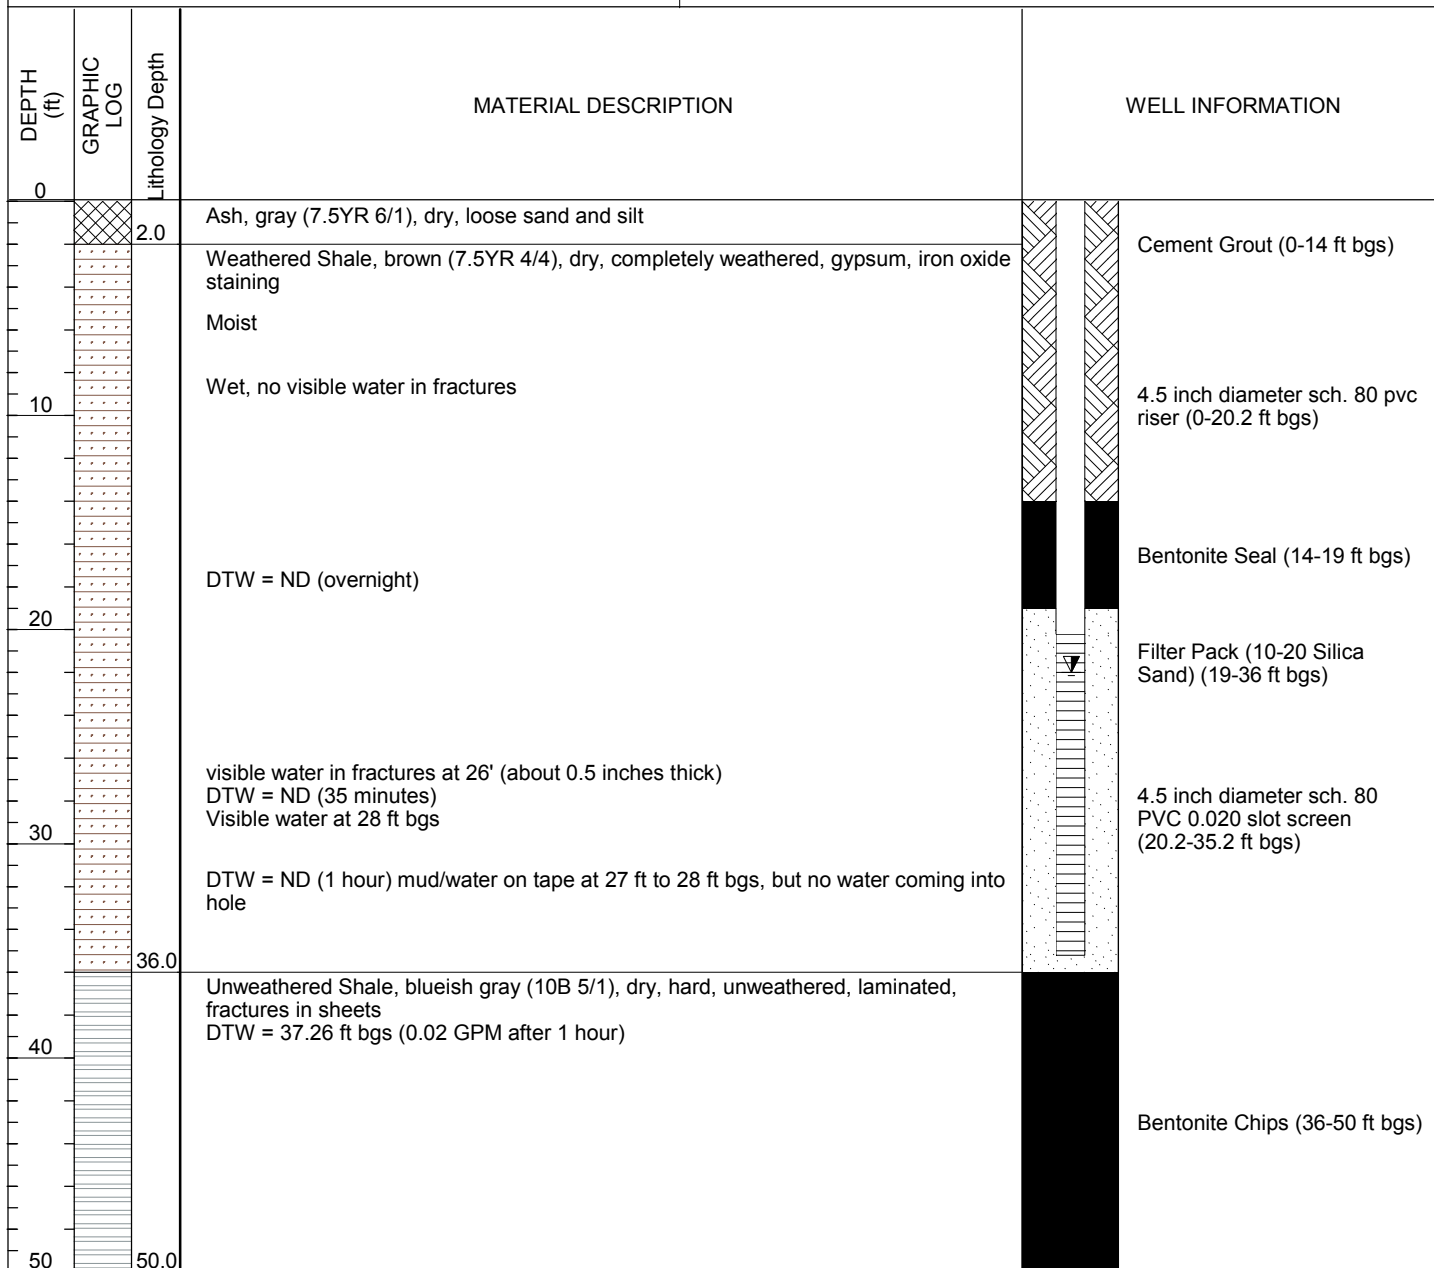

Total Depth of borehole = 50.0 feet



7720 North 16th Street STE 100  
Phoenix, AZ

SHEET 1 of 2

## Borehole: MW-42

**PROJECT:** Four Corners Power Plant

**CLIENT:** APS

**LOCATION:** Fruitland, NM

**URS PROJECT #:** 23446275

**DRILLING METHOD:** Rotasonic

**LOGGED BY:** Derrick Maurer

**START DATE/TIME:** 3/22/2012 10:15:00 AM

**FINISH DATE/TIME:** 3/23/2012 2:45:00 PM


**COMMENTS:** Surveyed by Souder, Miller and Associates: June 2012

**COORDINATES (NAD83):**

**North:** 2072910.359

**East:** 2526527.6

**TOP OF GROUND ELEVATION (NAVD88):** 5222.32feet A.S.L.

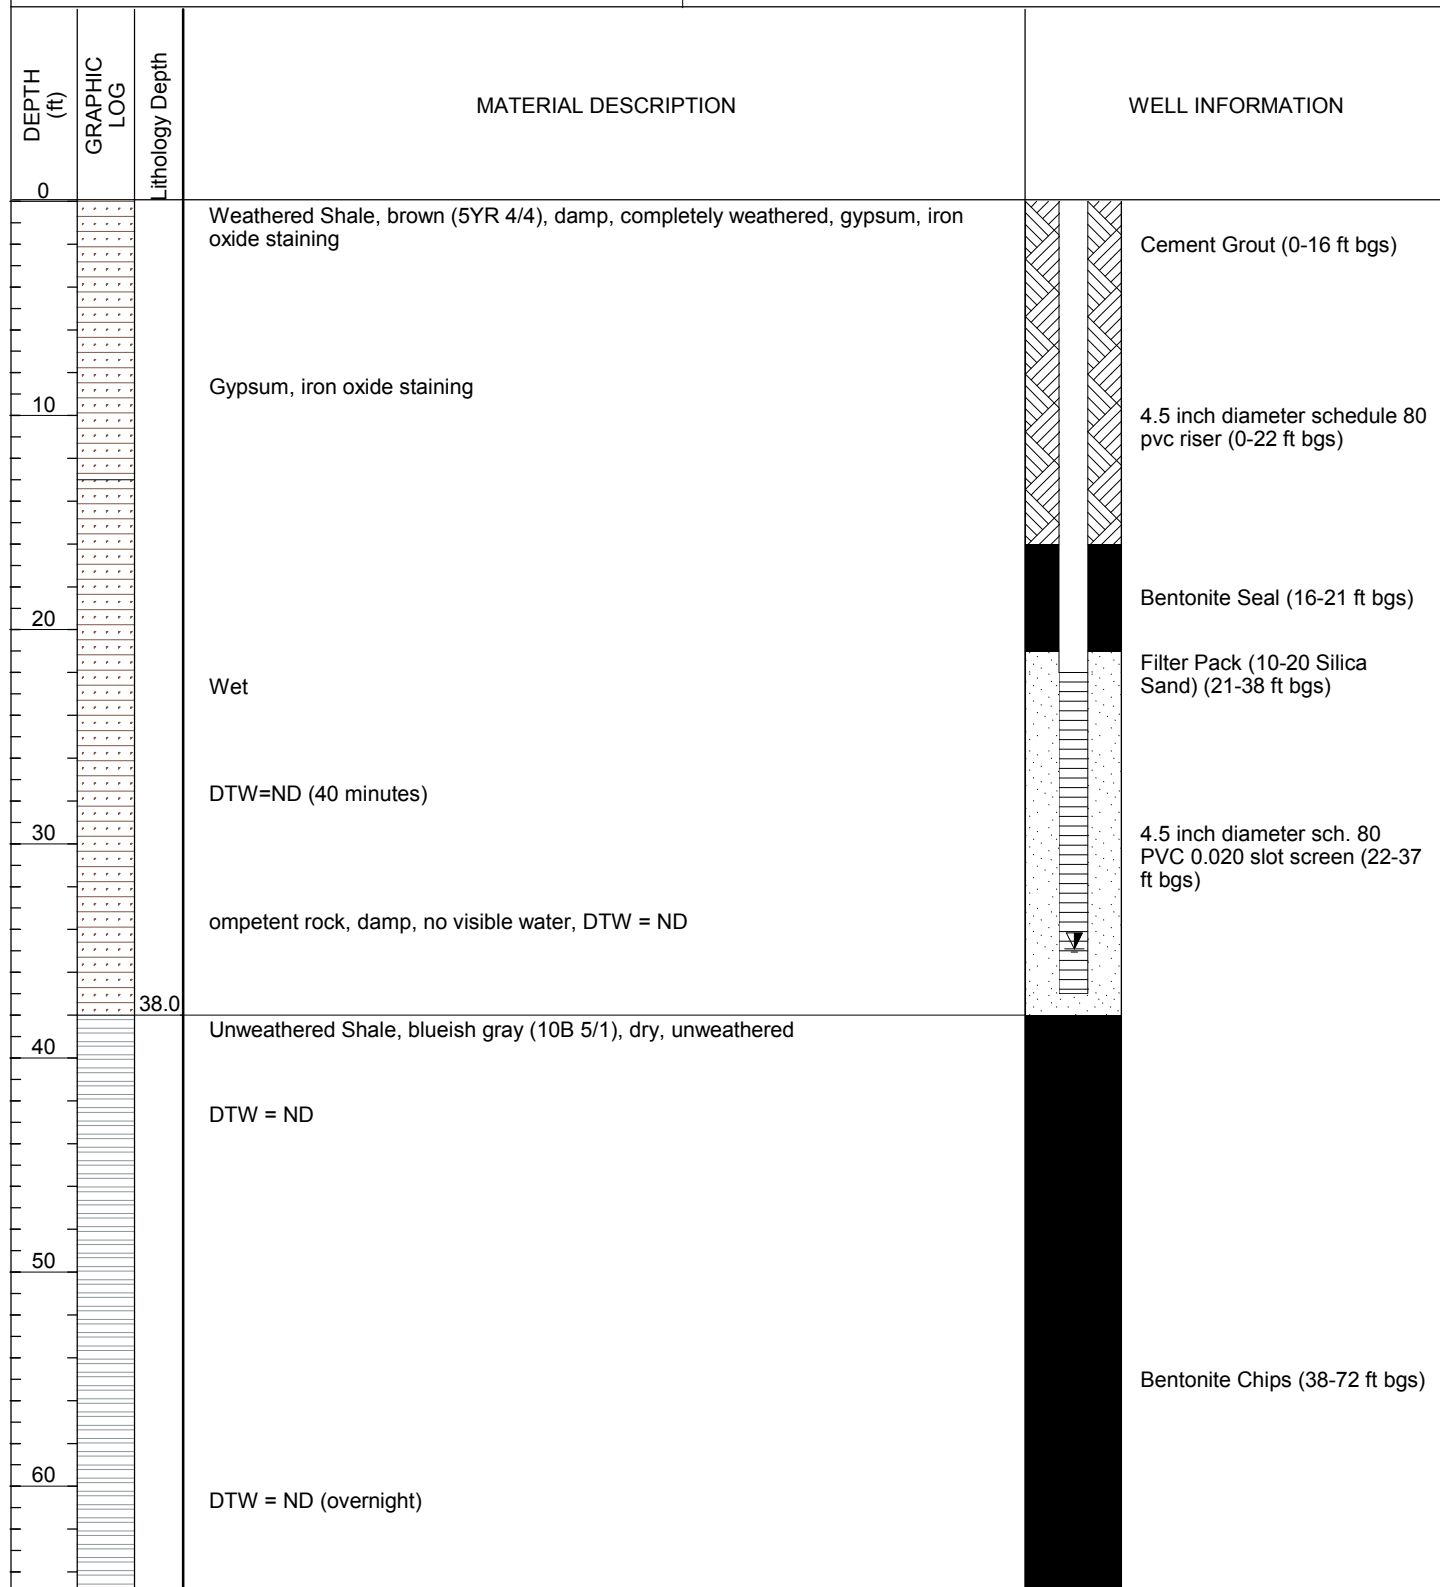



7720 North 16th Street STE 100  
Phoenix, AZ

SHEET 2 of 2

## Borehole: MW-42

**PROJECT:** Four Corners Power Plant  
**CLIENT:** APS  
**LOCATION:** Fruitland, NM  
**URS PROJECT #:** 23446275

**DRILLING METHOD:** Rotosonic  
**LOGGED BY:** Derrick Maurer  
**START DATE/TIME:** 3/22/2012 10:15:00 AM  
**FINISH DATE/TIME:** 3/23/2012 2:45:00 PM

DEPTH (ft)	GRAPHIC LOG	Lithology Depth	MATERIAL DESCRIPTION	WELL INFORMATION
70			Unweathered Shale, blueish gray (10B 5/1), dry, unweathered ( <i>continued</i> )	
		72.0	DTW = ND	

Total Depth of borehole = 72.0 feet



7720 North 16th Street STE 100  
Phoenix, AZ

SHEET 1 of 1

## Borehole: MW-43

**PROJECT:** Four Corners Power Plant

**CLIENT:** APS

**LOCATION:** Fruitland, NM

**URS PROJECT #:** 23446275

**DRILLING METHOD:** Rotasonic

**LOGGED BY:** Derrick Maurer

**START DATE/TIME:** 3/23/2012 4:50:00 PM

**FINISH DATE/TIME:** 3/24/2012 12:05:00 PM


**COMMENTS:** Surveyed by Souder, Miller and Associates: June 2012

**COORDINATES (NAD83):**

**North:** 2072045.99

**East:** 2530655.841

**TOP OF GROUND ELEVATION (NAVD88):** 5269.42feet A.S.L.

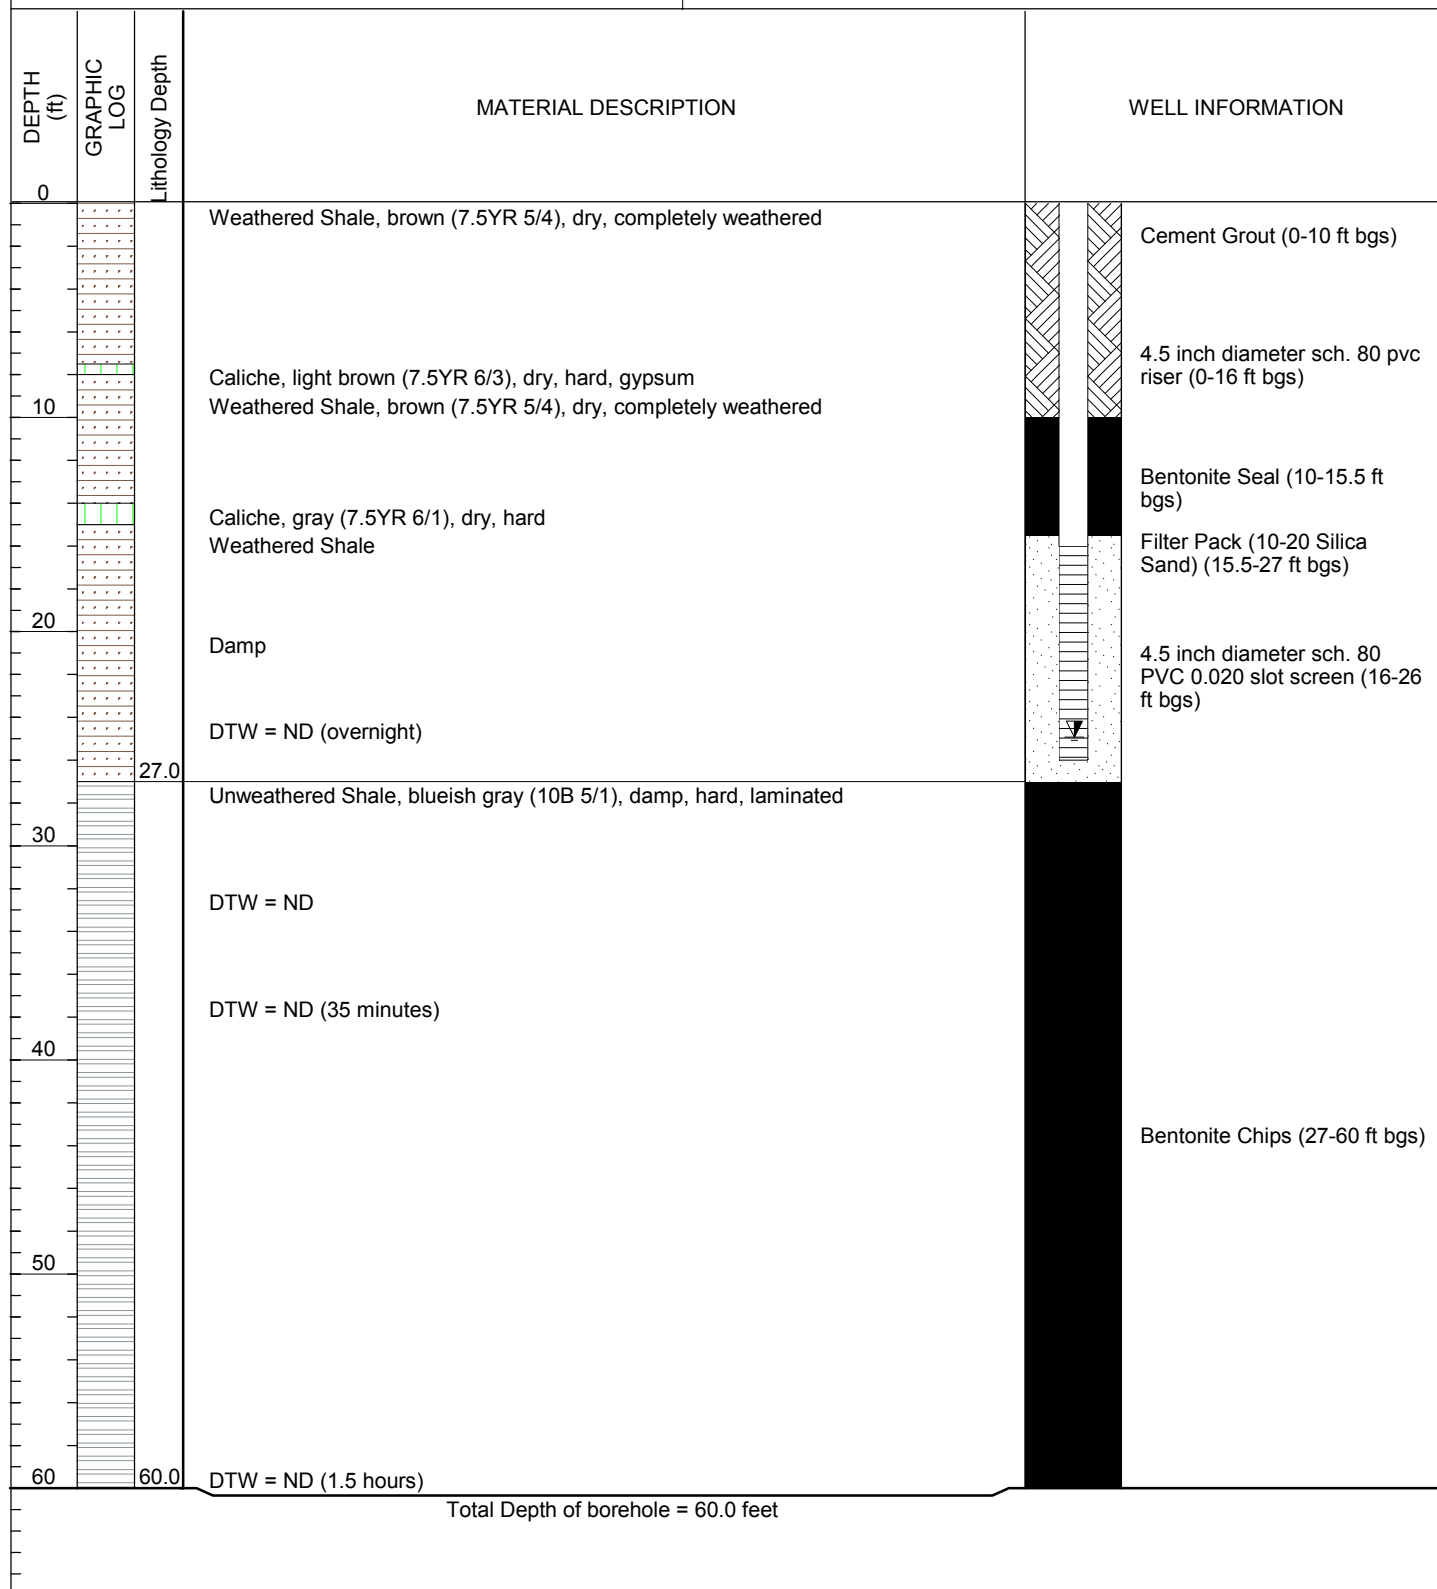





7720 North 16th Street STE 100  
Phoenix, AZ

SHEET 1 of 1

## Borehole: MW-44

**PROJECT:** Four Corners Power Plant  
**CLIENT:** APS  
**LOCATION:** Fruitland, NM  
**URS PROJECT #:** 23446275

**DRILLING METHOD:** Rotasonic  
**LOGGED BY:** Derrick Maurer  
**START DATE/TIME:** 3/27/2012 4:20:00 PM  
**FINISH DATE/TIME:** 3/28/2012 1:00:00 PM

**COMMENTS:** Surveyed by Souder, Miller and Associates: June 2012

**COORDINATES (NAD83):**  
**North:** 2065826.301  
**East:** 2525157.767  
**TOP OF GROUND ELEVATION (NAVD88):** 5145.15feet A.S.L.

